

THIS REPORT
MUST BE SUBMITTED
WITHIN 30 DAYS
AFTER COMPLETION
OF THE WELL

WELL COMPLETION REPORT

A-10242

WELL DESCRIPTION

King Manor

WELL LOG

State the kind of formations penetrated, their color, their depth, their thickness, and if water-bearing

CASING AND SCREEN RECORD

State the kind and size and position of casing, liner, shoe, screen, and other accessories (if no casing used, give diameter of well).

Top soil

FEET
from to
- 2

grayer sand

2 - 40

gray granite

40 - 98

water at

36

water at

60

67-W-36

*10 1/2 in. ft.
Black steel
welded shd*

DIAM.
(Inches)

5 5/8

FEET
from to
- 41

PUMPING TEST

Hours Pumped *2*

Type of Pump Used *Bailer*

Pumping Rate *7*

Gallons per Minute *7*

WATER LEVEL

Distance from land surface to water:

Before Pumping *35* Ft.

When Pumping *out* Ft.

APPEARANCE OF WATER

Clear ☒ Cloudy ☐

Taste ☐

Odor ☐

Height of Casing Above Land

Surface *hit* Ft.

PUMP INSTALLED

Type ☐

Capacity


Gallons per Minute ☐

Gallons per Hour ☐

Pump Column Length ☐ Ft.

LOCATION OF WELL ON LOT

Show permanent structures such as building(s), septic tank, and/or other landmarks and indicate not less than 2 distances (measurements) to well.

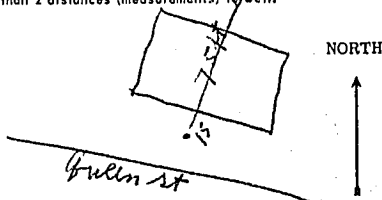

Date Well

Was Completed *Aug 24/66*

Well Driller

Signature

John A. Moore