

APPLICATION

PERCOLATION TESTING

A 38119

P _____

HOWARD COUNTY HEALTH DEPARTMENT
BUREAU OF ENVIRONMENTAL HEALTH
P.O. BOX 476 ELLICOTT CITY, MARYLAND 21043
TELEPHONE: 461-9933

DISTRICT _____

DATE 11/28/82

TO: THE COUNTY HEALTH OFFICER
ELLICOTT CITY, MARYLAND

I, HEREBY, APPLY FOR THE NECESSARY TEST IN ORDER TO CONSTRUCT (OR RECONSTRUCT) A SEWAGE DISPOSAL SYSTEM.

PROPERTY OWNER Springhill Associates - c/o D.S. Thaler & Associates, Inc.

ADDRESS 11 Warren Road, Baltimore, MD 21208 PHONE (301) 484-4100

PROSPECTIVE BUYER N/A Polaris Development

ADDRESS _____ PHONE _____

PROPERTY LOCATION:

SUBDIVISION Meadowood LOT NO. 12 11

ROAD AND DESCRIPTION Henryton Road - approximately 4000' north of Tunnel Road
Howard County, Maryland 1201 Shady Creek Rd.

TAX MAP 10 PARCEL # 139

SIZE OF LOT 3+ Acres TYPE BLDG. Single Family
(SINGLE FAMILY DWELLING OR COMMERCIAL)

THE SYSTEM INSTALLED UNDER THIS APPLICATION IS ACCEPTABLE ONLY UNTIL PUBLIC FACILITIES BECOME AVAILABLE. I FULLY UNDERSTAND THE FEE CONNECTED WITH THE FILING OF THIS PERC TEST APPLICATION IS NON-REFUNDABLE UNDER ANY CIRCUMSTANCES. I ALSO AGREE TO COMPLY WITH ALL M.O.S.H.A. REQUIREMENTS IN TESTING THIS LOT.

(SIGNATURE OF APPLICANT)

APPROVED BY Ed Abel FOR Dep Truchio DATE 5-16-89

REJECTED BY _____ FOR _____ DATE _____

HOLD PENDING FURTHER TESTS _____ DATE _____

REASONS FOR REJECTION OR HOLDING 12/3/86 Perc Satisfactory, Hold For Subdivision Plat. S. Abel

BDG. PERMIT SIGNED


AND RETURNED 5-16-89

BP 25773 SAG

THIS IS NOT A PERMIT

① ②
SOIL PROFILE

4'-11"
A1-3
Yellow Bk
silt loam
~99% clay
<10% frags
3'-
Tan yellow
Bk silt sand
loam
Highly
micaceous
15-20%
increasing
w/ depth
to 20-30%

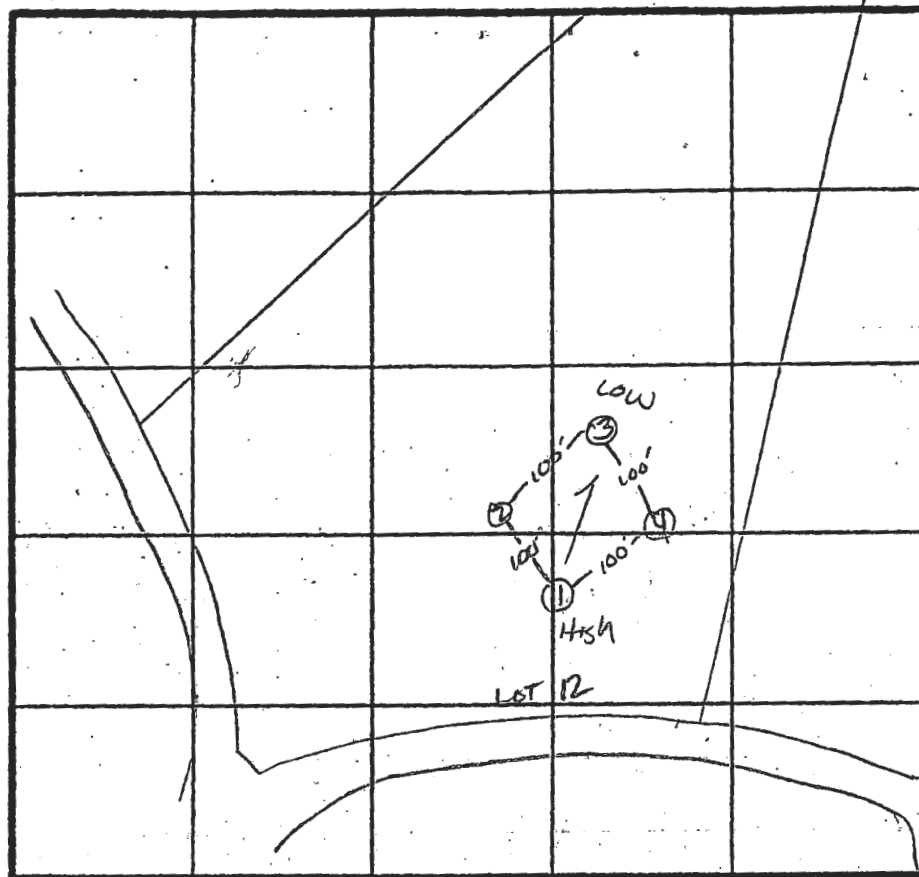


X PERC
1min
1.60 & 1BR
INLET 3'
BOTTOM 7'

INDICATE NORTH - NAME ADJOINING ROADWAY AS BASE LINE.

DATE	TEST NO.	DEPTH	PRE-WET		TEST - 1" DROP		TIME
			START	STOP	START	STOP	
12/3/86	S	3.5	12:09	12:10	12:10	12:11	1 MIN
	M	8	12:09	12:10	12:10	12:11	1 MIN
	1V	11'	UNIFORM SOIL below 3'				
	2V	12.5'	UNIFORM SOIL below 3.5' SAME AS #1				
	3S	3.5	12:13	12:14	12:14	12:15	1 MIN
	3V	11'	SIMILAR TO #1 w/ MORE FRAGMENT 50% AT 11'				
	4S	3'	12:18	12:19	12:19	12:20	1 MIN
	4V	11.5'	UNIFORM SOIL below 3' FRAGMENTS 50% AT 10.5'				

REMARKS HOLES PER PLAT
TYPE OF SOIL Glenelg
TESTED BY S. Abel OWNER/ Fyock & Co.
ALSO PRESENT

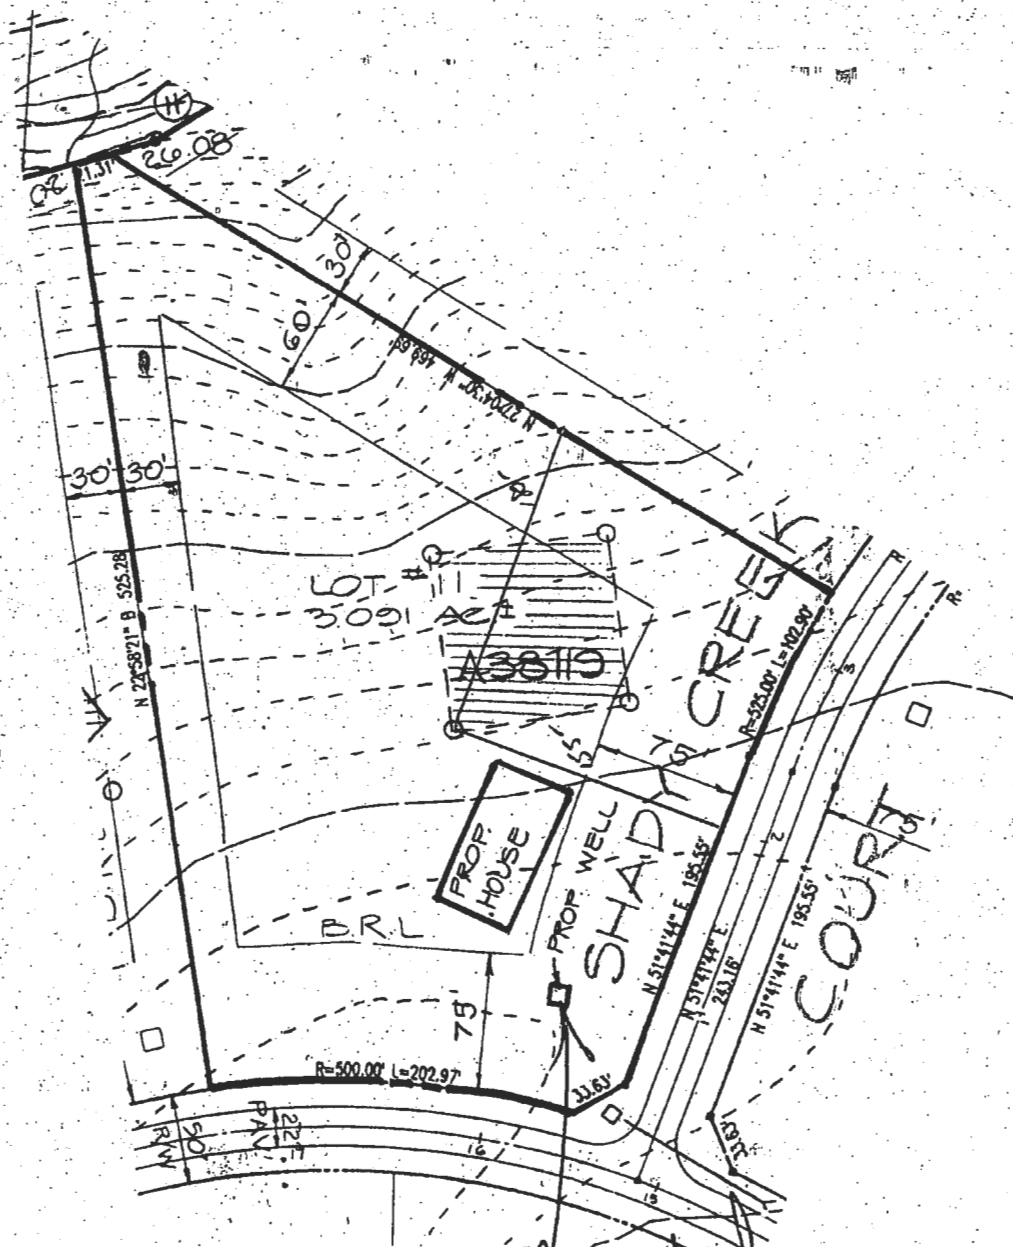

8/21/84
 Site shown
 & OK'd as shown
 (Signature)

RECEIVED
 JUN 30 1987
 L.F. EASTERDAY, INC.

OWNER

SPRING HILL ASSOCIATES
 RUTH H. WESTON
 1427 ROUTE 32
 SYKESVILLE, MD. 21784

DEVELOPER

KOREN DEVELOPMENT CORP. INC.
 5423 WATERCRESS PLACE
 COLUMBIA, MARYLAND 21045

P.S. Thaler & Assoc. Inc.
 CIVIL ENGINEERS - SURVEYORS
 LANDSCAPE ARCHITECTS
 11 WARREN ROAD
 BALTIMORE, MARYLAND 21208
 (301) 484-4100

LOT # 11
MEADOWWOOD

SECTION ONE

TAP MAP 10
 3RD ELECTION DISTRICT
 SCALE: 1"=100'

PARCEL 133
 HOWARD COUNTY, MARYLAND
 DATE: JUNE 25, 1987