

DEPT. OF INSPECTIONS, LICENSES AND PERMITS 3430 COURT HOUSE DRIVE ELLICOTT CITY, MD 21043 PERMITS (410) 313-2455 INSPECTIONS (410) 313-1810 AUTOMATED INFORMATION (410) 313-3800	HOWARD COUNTY PERMIT APPLICATION	PERMIT NUMBER <div style="font-size: 2em; margin-top: 10px;">310003209</div>
Building Address <u>1201 SHADY CREEK RD, MARIOTTSVILLE MD 21104</u>		Property Owner's Name <u>DON & MAUREEN STEBIER</u> Address <u>1201 SHADY CREEK ROAD</u> City <u>MARIOTTSVILLE</u> State <u>MD</u> Zip Code <u>21104</u> Home Phone <u>410 442 9806</u> Work Phone <u>410 279 8667</u> Applicant's Name & Mailing Address, (if other than stated herein): _____ _____ _____
Suite/Apt. #: _____ SDP/WP/Petition #: _____ Census Tract _____ Subdivision _____ Section _____ Area _____ Lot _____ Tax Map _____ Parcel _____ Grid _____ Zoning _____ Map Coordinates _____ Lot Size _____		Phone _____ Fax _____
Existing Use <u>SINGLE FAMILY HOME</u> Proposed Use <u>SAME WITH DETACHED GARAGE</u> Estimated Construction Cost \$ <u>29,000</u> Description of Work <u>DETACHED GARAGE THREE CAR</u> <u>1,136 SF SEE PLANS</u>		Contractor Company <u>COSSENTINO REMODELING</u> Contact Person <u>WAYNE COSSENTINO</u> Address <u>12107 MAYHURD TRAIL</u> City <u>MARIOTTSVILLE</u> State <u>MD</u> Zip Code <u>21104</u> License No. <u>080100116414</u> Phone <u>410 977 5781</u> Fax <u>410 442 5765</u>
Occupant or Tenant <u>DON & MAUREEN STEBIER</u> Contact Name <u>SAME</u> Address <u>1201 SHADY CREEK ROAD</u> City <u>MARIOTTSVILLE</u> State <u>MD</u> Zip Code <u>21104</u> Phone <u>410 442 9806</u> Fax _____		Engineer or Architect Company <u>ALISA SCHMIDT ARCHITECT INC.</u> Contact Person <u>ALISA SCHMIDT</u> Address <u>2739 THORNBROOK ROAD</u> City <u>ELLICOTT CITY</u> State <u>MD</u> Zip Code <u>21042</u> Phone <u>410 461 3462</u> Fax <u>SAME</u>

BUILDING DESCRIPTION - COMMERCIAL		BUILDING DESCRIPTION - RESIDENTIAL	
Building Characteristics Height: _____ No. of stories: _____ Gross area, sq. ft. per floor: _____ Use group: _____ Construction type: <input type="checkbox"/> Reinforced Concrete <input type="checkbox"/> Structural Steel <input type="checkbox"/> Masonry <input type="checkbox"/> Wood Frame <input type="checkbox"/> State Certified Modular	Utilities Water Supply: <input type="checkbox"/> Public <input type="checkbox"/> Private Sewage Disposal: <input type="checkbox"/> Public <input type="checkbox"/> Private Electric Yes <input type="checkbox"/> No <input type="checkbox"/> Gas Yes <input type="checkbox"/> No <input type="checkbox"/> Heating System: Electric <input type="checkbox"/> Oil <input type="checkbox"/> Natural Gas <input type="checkbox"/> Propane Gas <input type="checkbox"/> Sprinkler system: N/A <input type="checkbox"/> Full _____ Partial _____ Other Suppression _____ # of Heads _____	Building Characteristics SF Dwelling <input checked="" type="checkbox"/> SF Townhouse <input type="checkbox"/> Depth _____ Width _____ 1 st floor: <u>DETACHED GARAGE</u> 2 nd floor: _____ Basement: <u>SEE PLANS</u> Finished Basement <input type="checkbox"/> Unfinished Basement <input type="checkbox"/> Crawl space <input type="checkbox"/> Slab on Grade <input type="checkbox"/> No. of Bedrooms _____ Multi-family dwellings: No. of efficiency units: _____ No. of 1 BR units: _____ No. of 2 BR units: _____ No. of 3 BR units: _____ Other Structure: <u>DETACHED GARAGE</u> Dimensions: _____ Footings: <u>SEE PLANS</u> Roof: _____ <input type="checkbox"/> State Certified Modular <input type="checkbox"/> Manufactured Home	Utilities Water Supply: <input type="checkbox"/> Public <input checked="" type="checkbox"/> Private Sewage Disposal: <input type="checkbox"/> Public <input checked="" type="checkbox"/> Private Electric Yes <input type="checkbox"/> No <input type="checkbox"/> Gas Yes <input type="checkbox"/> No <input type="checkbox"/> Heating System: Electric <input type="checkbox"/> Oil <input type="checkbox"/> Natural Gas <input type="checkbox"/> Propane Gas <input type="checkbox"/> Sprinkler system: N/A <input checked="" type="checkbox"/> NFPA #13D _____ NFPA #13R _____ Other: _____

THE UNDERSIGNED HEREBY CERTIFIES AND AGREES AS FOLLOWS: (1) THAT HE/SHE IS AUTHORIZED TO MAKE THIS APPLICATION; (2) THAT THE INFORMATION IS CORRECT; (3) THAT HE/SHE WILL COMPLY WITH ALL REGULATIONS OF HOWARD COUNTY WHICH ARE APPLICABLE THERETO; (4) THAT HE/SHE WILL PERFORM NO WORK ON THE ABOVE REFERENCED PROPERTY NOT SPECIFICALLY DESCRIBED IN THIS APPLICATION; (5) THAT HE/SHE GRANTS COUNTY OFFICIALS THE RIGHT TO ENTER ONTO THIS PROPERTY FOR THE PURPOSE OF INSPECTING THE WORK PERMITTED AND POSTING NOTICES.


Applicant's Signature _____	Print Name _____
Email Address _____	
Title/Company _____	Date _____

Checks payable to: DIRECTOR OF FINANCE OF HOWARD COUNTY
 PLEASE WRITE NEATLY AND LEGIBLY
 - FOR OFFICE USE ONLY -

AGENCY	DATE	SIGNATURE	APPROVAL	DPZ SETBACK INFORMATION	Filing fee	PROPERTY ID #
Land Development, DPZ				Front: _____	\$ _____	
State Highways				Rear: _____	\$ _____	
Building Officials				Side: _____	\$ _____	
Dev. Engineering, DPZ				Side St: _____	\$ _____	
Health	10/14/10	Wesley Scott		All minimum setbacks met?	TOTAL FEES \$ _____	
Fire Protection				YES <input type="checkbox"/> NO <input type="checkbox"/>	Sub-total paid \$ _____	
Is Sediment Control approval required prior to issuance?				Is Entrance Permit Required?	Balance due	\$ _____
YES <input type="checkbox"/> NO <input type="checkbox"/>				YES <input type="checkbox"/> NO <input type="checkbox"/>	Check	# _____
				Historic District?	Validation	# _____
				YES <input type="checkbox"/> NO <input type="checkbox"/>		
				Lot Coverage for New Town Zone		
				SDP/Red-line approval date _____	Accepted by _____	

CONTINGENCY CONSTRUCTION START: ☐
 ONE STOP SHOP: ☐

Distribution of Copies - White: Building Officials Green: LDD, DPZ Yellow: DED, DPZ Pink: Health Gold: SHA
 T: Operations/Updated forms

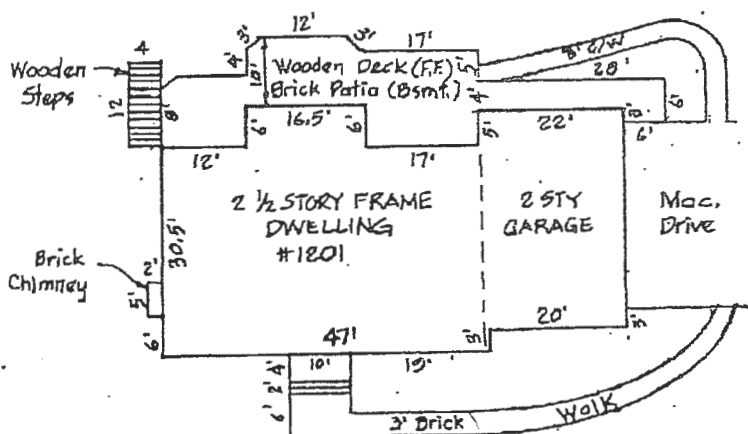

ENLARGEMENT

SCALE: 1"=20'

APPROVED

WALK-THRU BUILDING PERMIT


BP#

A# 38119

APP. SAN HS

DATE: 10-14-10

DESC. OF WORK: detached garage

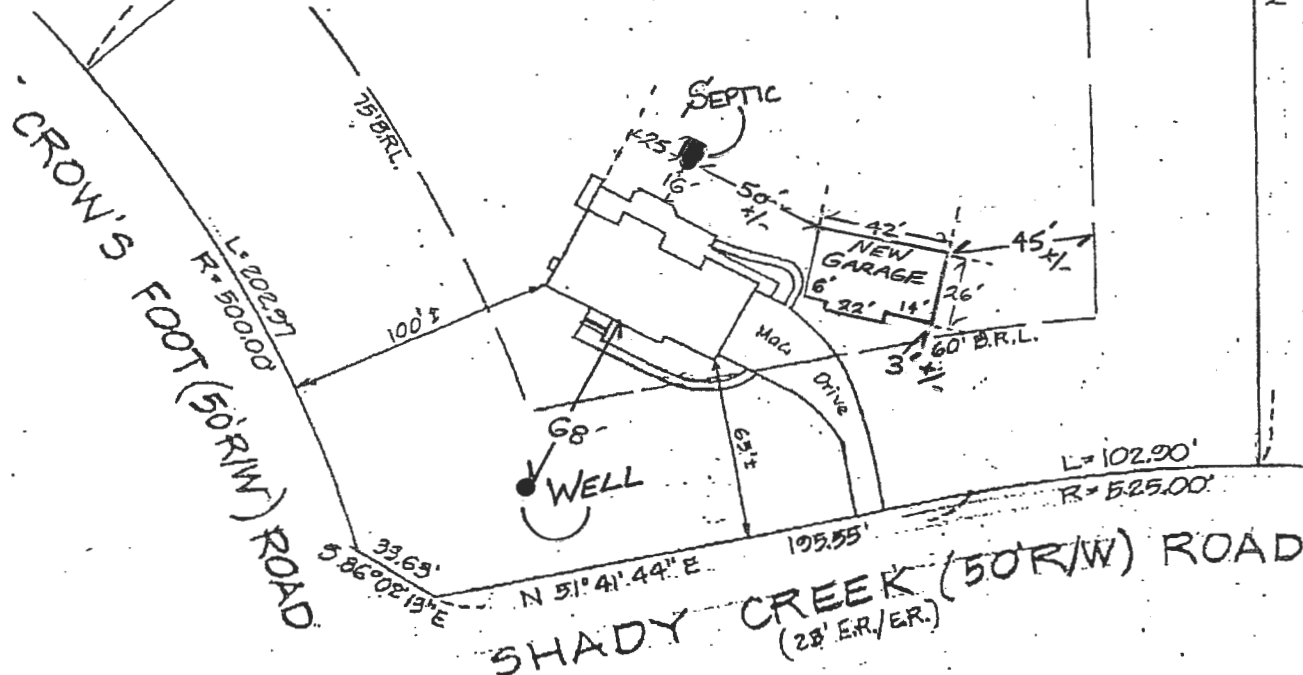

THE LOT SHOWN HEREON IS IN FLOOD
 ZONE 6 PER F.E.M.A. FLOOD INSURANCE
 RATE MAP PANEL # 240044 0009 B

The plat is of benefit to a consumer only insofar as it is required by a lender or a title insurance company or its agent in connection with contemplated transfer, financing, or refinancing. The plat is not to be relied upon for the establishment or location of fences, garages, buildings, or other existing or future improvements. The plat does not provide for the accurate identification of property boundary lines, but such identification may not be required for the transfer of title or securing financing or refinancing. The plat contains a tolerance of accuracy of two feet, more or less.



LOCATION DRAWING OF