

HOWARD COUNTY
PERMIT APPLICATION

PERMIT NUMBER

B-153375

KP

Building Address 2803 Shadow Roll Ct

Property Owner's Name ALHAWA K. NGUYEN

Address 2803 Shadow Roll Ct

Suite/Apt. #: _____ SDP/WP/Petition #: _____

Census Tract 6040.02 Subdivision Glenwood Springs

City Columbia State MD Zip Code 21738

Section _____ Area _____ Lot 24

Home Phone _____ Work Phone _____

Tax Map 141 Parcel 227 Grid 17

Applicant's Name & Mailing Address, (if other than stated hereon):

Zoning RR-06B Map Coordinates 9-D-5 Lot size _____

Phone _____ Fax _____

Existing Use _____

Contractor Company HOSEA GAS CO.

Proposed Use Boiler and cooking

Contact Person Bill Miller

Estimated Construction Cost \$ 15000

Address 360 Maryland

Description of Work Installing a 325 gallon

Address 360 Maryland

water boiler tank and gas line

City Columbia State MD Zip Code 21707

for a hot water heater and a cook top

License No. Gas 09164

and a gas line work on 1/4

Phone 410-725-3222 Fax 410-725-7129

Occupant or Tenant ALHAWA K. NGUYEN

Engineer or Architect Company _____

Contact Name SAME

Contact Person _____

Address 2803 Shadow Roll Ct

Address _____

City Columbia State MD Zip Code 21738

City _____ State _____ Zip Code _____

Phone _____ Fax _____

Phone _____ Fax _____

BUILDING DESCRIPTION - COMMERCIAL

BUILDING DESCRIPTION - RESIDENTIAL

Building Characteristics

Utilities

Height: _____
No. of stories: _____
Gross area, sq. ft. per floor: _____
Use group: _____
Construction type:
☐ Reinforced Concrete
☐ Structural Steel
☐ Masonry
☐ Wood Frame
☐ State Certified Modular

Water Supply: _____
☐ Public
☐ Private
Sewage Disposal: _____
☐ Public
☐ Private
Electric Yes ☐ No ☐
Gas Yes ☐ No ☐
Heating System:
Electric ☐ Oil ☐
Natural Gas ☐
Propane Gas ☐
Sprinkler system: N/A ☐
☐ Full
☐ Partial
☐ Other Suppression
☐ # of Heads

Building Characteristics

Utilities

SF Dwelling ☐ SF Townhouse ☐
Depth Width
1st floor: _____
2nd floor: _____
Basement: _____
Finished Basement ☐ Unfinished Basement ☐
Crawl space ☐ Slab on Grade ☐
No. of Bedrooms: _____
Height: _____
Multi-family dwellings:
No. of efficiency units: _____
No. of 1 BR units: _____
No. of 2 BR units: _____
No. of 3 BR units: _____
Other Structure: _____
Dimensions: _____
Footings: _____
Roof Height: _____
☐ State Certified Modular
☐ Manufactured Home

Water Supply: _____
☐ Public
☐ Private
Sewage Disposal: _____
☐ Public
☐ Private
Electric Yes ☐ No ☐
Gas Yes ☐ No ☐
Heating System: _____
Electric ☐ Oil ☐
Natural Gas ☐
Propane Gas ☒
Sprinkler system: N/A ☐
☐ NFPA #13D
☐ NFPA #13R
☐ Other:

THE UNDERSIGNED HEREBY CERTIFIES AND AGREES AS FOLLOWS: (1) THAT HE/SHE IS AUTHORIZED TO MAKE THIS APPLICATION; (2) THAT THE INFORMATION IS CORRECT; (3) THAT HE/SHE WILL COMPLY WITH ALL REGULATIONS OF HOWARD COUNTY WHICH ARE APPLICABLE THERETO; (4) THAT HE/SHE WILL PERFORM NO WORK ON THE ABOVE REFERENCED PROPERTY NOT SPECIFICALLY DESCRIBED IN THIS APPLICATION; (5) THAT HE/SHE GRANTS COUNTY OFFICIALS THE RIGHT TO ENTER ONTO THIS PROPERTY FOR THE PURPOSE OF INSPECTING THE WORK PERMITTED AND POSTING NOTICES.

Applicant's Signature

Print Name

Title/Company

Date

Checks payable to: **DIRECTOR OF FINANCE OF HOWARD COUNTY**
** PLEASE WRITE NEATLY AND LEGIBLY. **
- FOR OFFICE USE ONLY -

63746


AGENCY DATE SIGNATURE APPROVAL
Land Development, DPZ
State Highways
Building Official
Dev. Engineering, DPZ
Health
Fire Protection
Is Sediment Control approval required prior to issuance?
YES ☐ NO ☐

DPZ SETBACK INFORMATION PROPERTY ID#
Front: _____ Filing fee \$ _____
Rear: _____ Permit fee \$ 100.00
Side: _____ Excise tax \$ 10.00
Side St.: _____ Add'l per. fee \$ _____
All minimum setbacks met? TOTAL FEES \$ 110.00
YES ☐ NO ☐ Sub-total paid \$ _____
Is Entrance Permit required? Balance due \$ _____
YES ☐ NO ☐ Check # 6873
Historic District? Validation # 89339
YES ☐ NO ☐

CONTINGENCY CONSTRUCTION START: ☐
ONE STOP SHOP: ☐


Lot Coverage for NewTown Zone _____
SDP/Red-line approval date _____ Accepted by 9

Distribution of Copies- White: Building Official Green: LDD, DPZ Yellow: DED, DPZ Pink: Health Gold: SHA
T:\forms\PERMIT.FRM

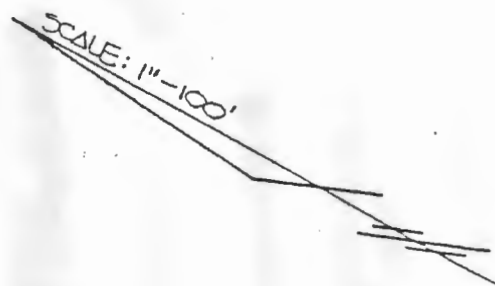

SCALE: 1" = 30'

N 26° 30' 00" W 224.67' ∴ N 17° 50' 28" E, 34.75'

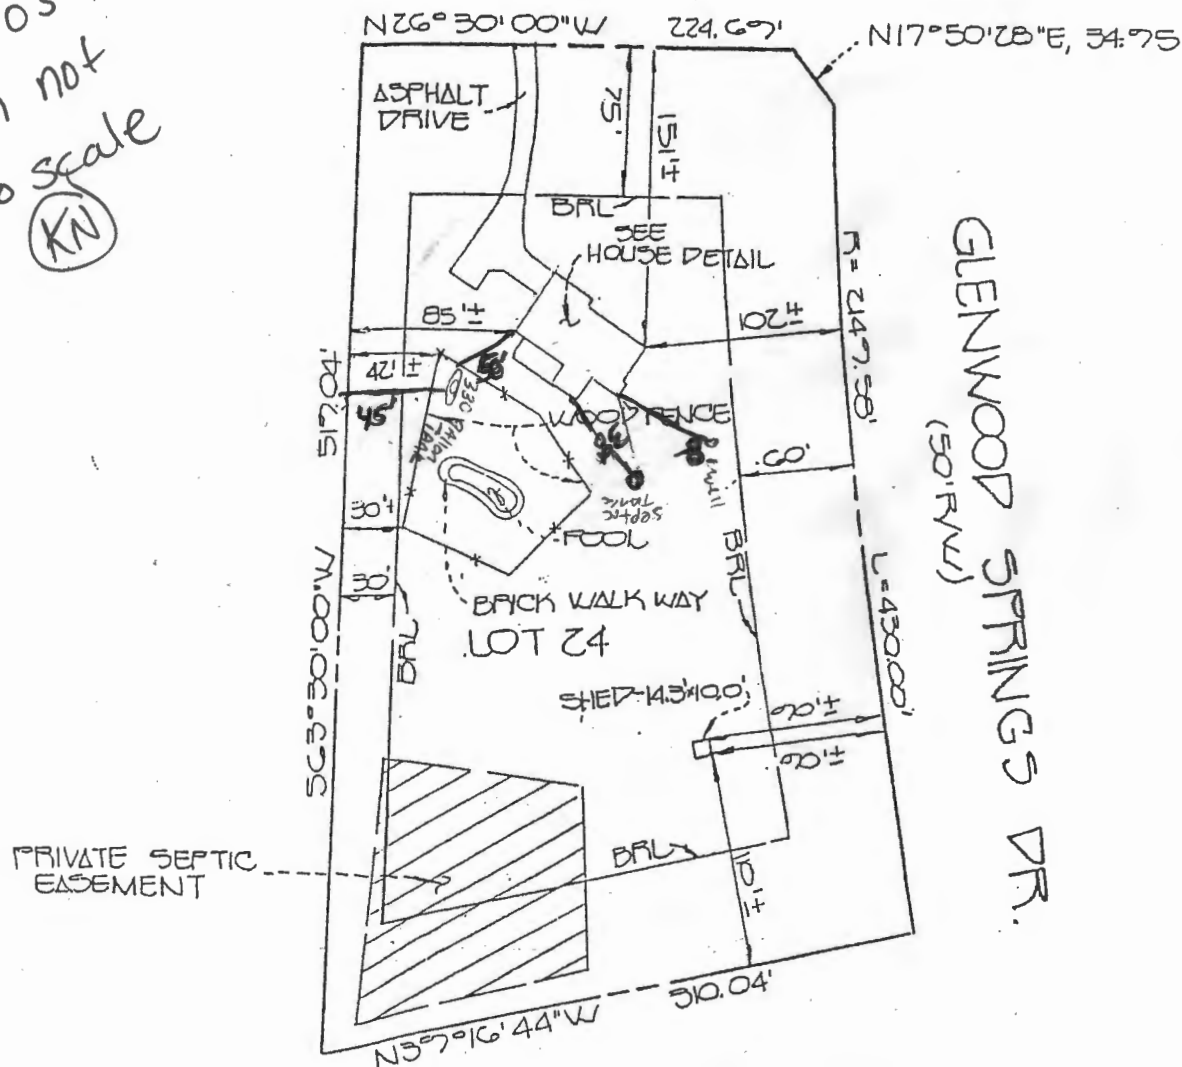

GLENWOOD SPRINGS DR.
(501 RV)

SL-BUILDING RESTRICTION LINE


NOTE: THIS PROPERTY IS NOT LOCATED
WITHIN A 100 YEAR FLOOD PLAIN.



SCALE: 1" = 30'

10/22/04 BOO50830
2-STORY ADDITION
Proposed addition OK.
-NO new medications-
CT K5B

N 26° 30' 00" W 224.67' ∴ N 17° 50' 28" E, 34.75'

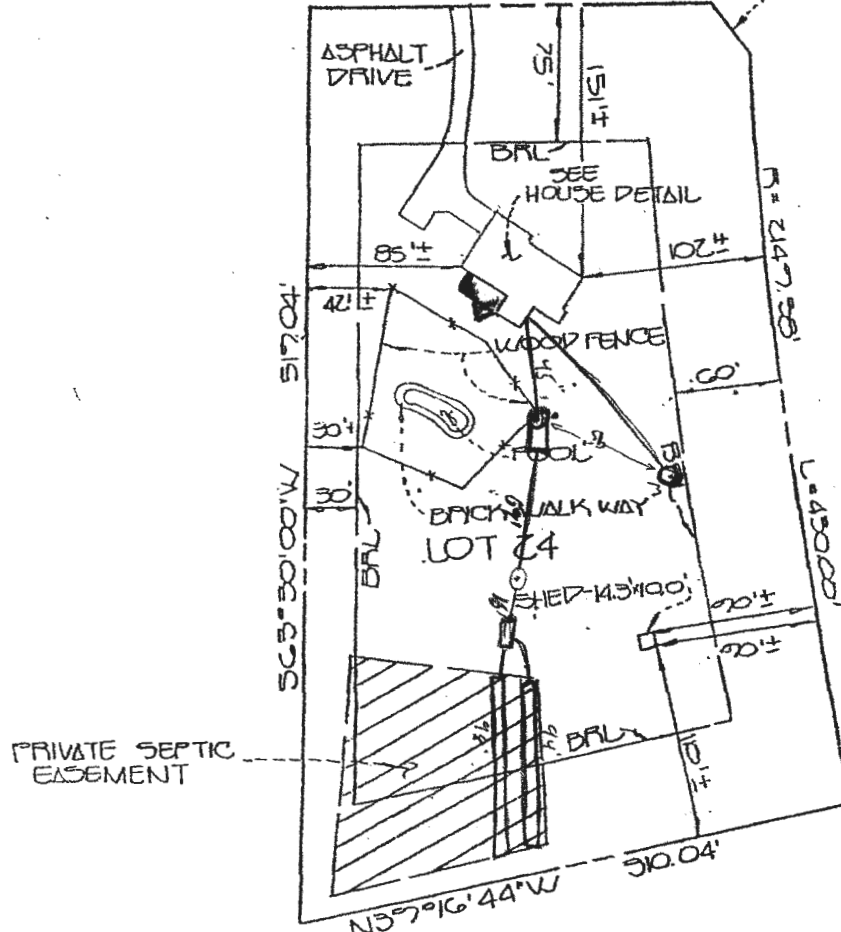

GLENWOOD SPRINGS DR.
(SO. RW.)

NOTE: THIS PROPERTY IS NOT LOCATED
WITHIN A 100 YEAR FLOOD PLAIN