

APPLICATION

A 26550

P _____

SEWAGE DISPOSAL TESTING

STATE OF MARYLAND - DEPARTMENT OF HEALTH AND MENTAL HYGIENE

HOWARD COUNTY HEALTH DEPARTMENT
ENVIRONMENTAL HEALTH SERVICESP O. BOX 476, ELLICOTT CITY, MARYLAND 21043
TELEPHONE: 465-5000, EXT. 356✓ DISTRICT 5th✓ DATE 28 July 778/12/77*See separate sheet for specs*TO: THE COUNTY HEALTH OFFICER
ELLICOTT CITY, MARYLAND

I, HEREBY, APPLY FOR THE NECESSARY TEST IN ORDER TO CONSTRUCT (OR RECONSTRUCT) A SEWAGE DISPOSAL SYSTEM.

✓ PROPERTY OWNER Clare I Guernsey 513 W. Norrers Lane Rockville, Md.✓ ADDRESS Tridelpia Mill Rd. Clarksville ✓ PHONE 340-8425
property to be tested. Business 384 0854

PROPERTY LOCATION:

✓ SUBDIVISION _____ ✓ LOT NO. C✓ ROAD AND DESCRIPTION directions From D.C. - 29 W. - 32 W, R 108, 2 Ten Oaks, 1 Tridelpia Mill
go about 2 blocks (2nd main driveway on left) by row of mail boxes✓ SIZE OF LOT 11± acres ✓ TYPE BLDG. None at present
NUMBER OF BEDROOMS _____IF NOT SINGLE RESIDENCE DESCRIBE Expect to build 2-3 BR house


THE SYSTEM INSTALLED UNDER THIS APPLICATION IS ACCEPTABLE ONLY UNTIL PUBLIC FACILITIES BECOME AVAILABLE.

✓ SIGNATURE OF APPLICANT Clare I GuernseyAPPROVED BY Raymond Hodges FOR Raymond DATE 12/6/77
(KIND OF SYSTEM)REJECTED BY _____ FOR _____ DATE _____
(KIND OF SYSTEM)

HOLD PENDING FURTHER TESTS _____ DATE _____

REASONS FOR REJECTION OR HOLDING _____

THIS IS NOT A PERMIT

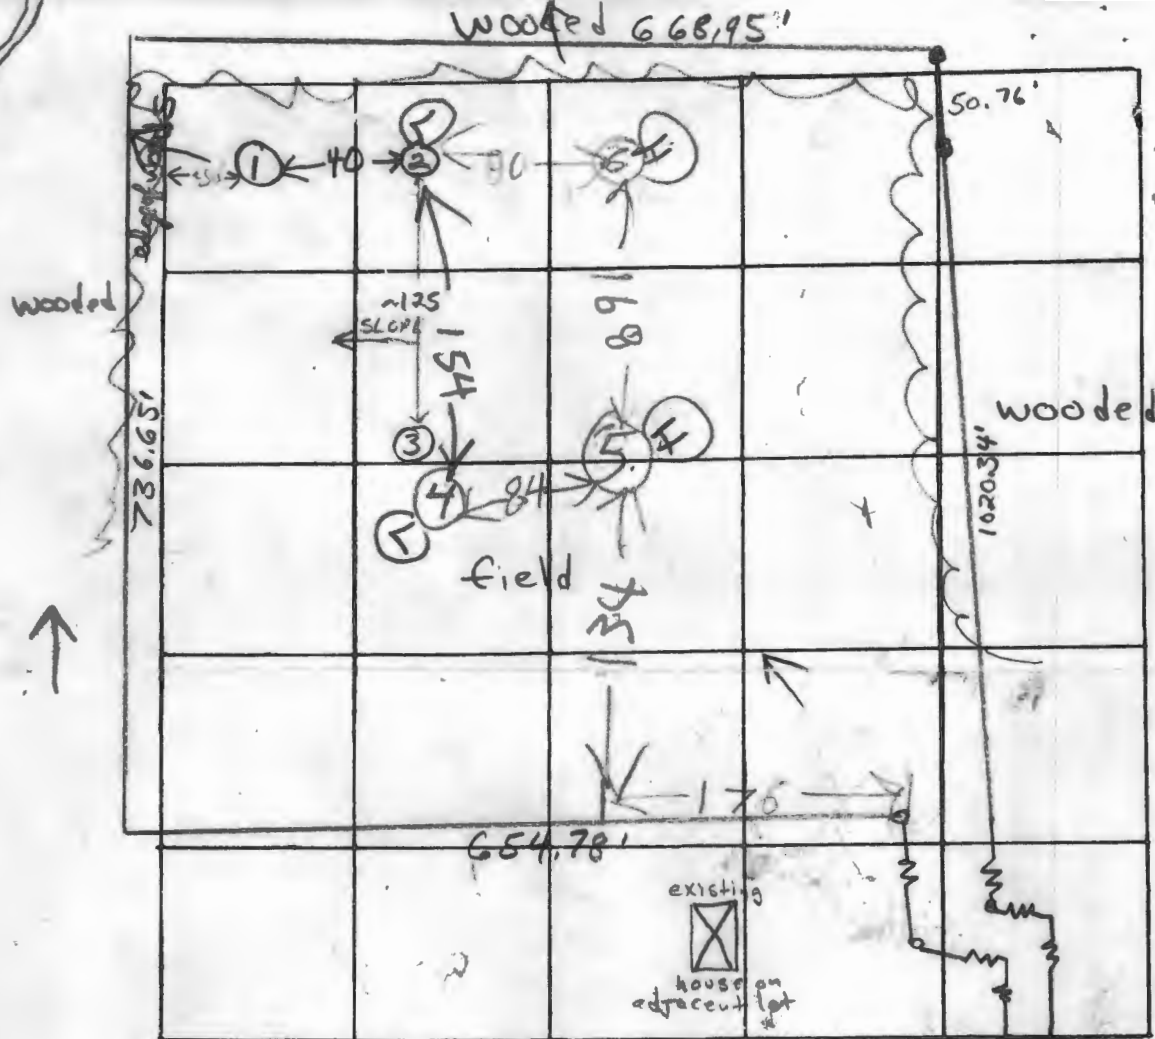

X = 12
210

DATE	TEST NO.	DEPTH	PRE-WET		TEST - 1" DROP		TIME
			START	STOP	START	STOP	
11/10/77	1	12'	Water at 12', clayey to 4' silty				
	2	4'	11:47	11:56	11:56	12:11	15min
	2A	13'	11:45	11:50	11:50	12:02	12min
	3	9'	Clayey to 24' sandy silt loam below				
12/6/77	4D	12	1044	1107	1107	1132	25
12/6/77	4S	6	1044	1051	1051	1106	15
12/6/77	5D	14	1047	1052	1052	1159	7
12/6/77	5S	4	1047	1110	little perc		
12/8/77	6D	13	1102	1109	1109	1111	4
	6S	5	1110	1115	1115	1125	10
	5m	5 1/2	1116	1120	1120	1126	6

REMARKS

backhoe breaks down (3)

TYPE OF SOIL

clayey to 4' silty/sandy brown mica schist below

TESTED BY

F.S. 12/6/77 RH

ALSO PRESENT: Clare Guernsey

12/6/77) BATHINGHAM
E. GUERNSEY

Water in left rear corner of lot

NOTE: 100 Year Flood Elevations are based on an assumed datum.

The lots shown hereon comply with minimum ownership width and lot area as required by the Maryland State Department of Health Regulations.

CURVE DATA						COORDINATE SCHEDULE					
No.	Radius	Length	Tangent	Delta	Chord Bearing & Dist.	No.	North	East	No.	North	East
4-29	1586.12'	446.86'	275.08'	16°59'58"	S 57° 09' 01" W 445.72'	1	9,243.92	3,292.67	15	8,945.38	3,450.54
5-22	1556.12'	461.69'	232.56'	16°59'58"	S 57° 09' 01" W 460.80'	2	10,014.28	4,175.04	16	9,046.01	3,414.36
23-24	300.00'	62.42'	31.32'	11°55'14"	S 71° 36' 37" W 62.503'	3	9,761.80	4,394.36	17	9,124.67	3,366.00
24-25	25.00'	18.78'	9.86'	43°02'57"	S 56° 02' 46" W 18.34'	4	9,786.74	4,376.09	18	9,123.57	3,354.43
25-26	50.00'	240.72'	—	275°50'25"	—	5	9,709.20	4,009.12	19	9,150.01	3,342.70
26-27	25.00'	23.98'	11.00'	56°57'55"	S 77° 07' 14" E 23.021'	6	9,438.27	4,647.56	20	9,149.34	3,327.49
27-28	250.00'	42.53'	21.31'	69°44'47"	N 70° 31' 23" E 42.881'	7	8,685.71	3,603.63	21	9,227.12	3,307.05
						8	8,716.62	3,564.33	22	9,459.68	4,022.48
						9	8,707.79	3,554.85	23	9,417.21	3,928.83
						10	8,737.87	3,514.82	24	9,397.55	3,869.71
						11	8,750.78	3,476.77	25	9,387.30	3,854.69
						12	8,828.16	3,443.60	26	9,453.74	3,845.68
						13	8,915.55	3,429.64	27	9,448.60	3,869.17
						14	8,940.55	3,437.09	28	9,462.76	3,906.22
						19	9,505.23	4,002.06			

THE ORIGIN OF THE COORDINATES SHOWN HEREON IS ASSUMED.

FILED AUG 16 1973

CABIN HILL

SECTION TWO
5TH ELECTION DISTRICT

HOWARD COUNTY, MARYLAND

DATE: APRIL 12, 1973 SCALE: 1"=100'

RECORDED PLAT BOOK FOLIO
ON 18 AMONG THE LAND RECORDED OF
HOWARD COUNTY, MD.

OWNER & DEVELOPER

CABIN HILL CORPORATION
SHARP ROAD
GLENWOOD, MARYLAND 21738

NUMBER OF LOTS 13
AREA OF LOTS 10,764 AC.
AREA OF ROADS 0.891 AC.
TOTAL AREA SHOWN 12,675 AC.

APPROVED: For private water and private sewerage systems, Howard County Health Department.
County Health Officer Date
APPROVED: Howard County Office of Planning and Zoning
Director Date
APPROVED: For private water, private sewerage, storm drainage systems and public roads, Howard County Department of Public Works.
Director Date

OWNER'S CERTIFICATE:
We, The Cabin Hill Corporation, owners of the property shown and described hereon, adopt this plan of Subdivision and reserve the fee simple title to the beds of the streets and/or roads shown hereon and in consideration of the approval of this plat by the Office of Planning and Zoning we for ourselves, our heirs or assigns; do hereby give and grant unto Howard County, Maryland, the right and option to acquire for the consideration of One Dollar the fee simple title to the beds of the streets and/or roads shown hereon, within the period of five years from the date of the recording of this plat among the Land Records of Howard County, Maryland.
Witness our hands and seals, this 4th day of April, 1973
1/4/73 Date
VICE PRESIDENT
CABIN HILL CORP.

SURVEYOR'S & ENGINEER'S CERTIFICATE:
I, William G. Rasch II, certify that the plan shown hereon is correct; that it is a Subdivision of part of the land which by deed dated October 22, 1971 and recorded among the Land Records of Howard County, Maryland in Liber C.M.P. 574 at Folio 705, was granted and conveyed by William E. Richards and wife, to Cabin Hill Corporation, and that stones and/or monuments marked thus  are in place as shown.
I further certify that the requirements of Section 60-B, Article 17 of the Annotated Code of Maryland (as amended) as far as they relate to the making of this plat have been complied with.
William G. Rasch II Reg. No. 4575



PURDUM
AND
JESCHKE
ENGINEERS AND
LAND SURVEYORS
1023 N. CALVERT ST.
BALTIMORE, MARYLAND
21202

MSA 55 W 1347-4299