

05-359120

PERMIT

P 514968

SEWAGE DISPOSAL SYSTEM

A REPAIR

HOWARD COUNTY HEALTH DEPARTMENT

BUREAU OF ENVIRONMENTAL HEALTH

410-313-2640

INDEXED

ISSUE DATE 3/8/01
APPROVAL DATE 8-17-01

Hatfield's Equipment

IS PERMITTED TO INSTALL ALTER X

ADDRESS 13785 Burntwoods Road, Glenelg, MD 21737 PHONE 301-854-6172

SUBDIVISION LOT NUMBER C ADDRESS 13029 Triadelphia Mill Road

PROPERTY OWNER William Hayden PROPERTY OWNER'S ADDRESS Same

SEPTIC TANK CAPACITY EX. 1000 GALLONSPUMP CHAMBER CAPACITY GALLONSNUMBER OF BEDROOMS 4 BR w/Add'nSQUARE FEET PER BEDROOM 180LINEAR FEET OF TRENCH REQUIRED 90TRENCHES: Trenches to be 2 feet wide. Inlet 4 feet below original grade. Bottom maximum depthLOCATION: 8 feet below original grade. 4 feet of stone below distribution box.REPAIR - PURPOSE - ~~Existing septic system has failed.~~ In Support of Building Permit B00128599
Call for inspection when ground is opened so sanitarian can recommend repair. 8/10/0190'± TRENCH BETW. HOLES (2) & (3)PLANS APPROVED DATE

PERMIT VOID AFTER 2 YEARS

NOTE: CONTRACTOR RESPONSIBLE FOR SCHEDULING A PRE-CONSTRUCTION INSPECTION FOR ALL INSTALLATIONS.

NOTE: TOP OF SEPTIC TANKS ARE TO BE NO DEEPER THAN 3.0 FEET BELOW FINISH GRADE

NOTE: WATERTIGHT SEPTIC TANKS REQUIRED

NOTE: CLEANOUT REQUIRED EVERY 70 FEET OF SEWER LINE AND/OR AT 90° SWEEPS IN LINES FROM HOUSE TO DRAIN FIELDS, 90° ELBOWS ARE NOT ACCEPTABLE

NOTE: ALL PARTS OF SEPTIC SYSTEMS (I.E. TANK, DISTRIBUTION BOX, DRAINFIELDS) TO BE 100 FEET FROM ANY WATER WELL UNLESS OTHERWISE SPECIFICALLY AUTHORIZED

NOTE: NO ABSORPTION TRENCH TO EXCEED 100 FEET IN LENGTH UNLESS SPECIFICALLY AUTHORIZED

NOTE: ALL PIPE FROM HOUSE TO SEPTIC TANK MUST BE CAST IRON OR SCHEDULE 35/40 PVC OR ABS

NOTE: MANHOLE RISERS REQUIRED ON ALL SEPTIC TANKS AND PUMP CHAMBERS

NOTE: DISTRIBUTION BOXES MUST HAVE BAFFLES

NOTE: IF PUMPED SEPTIC SYSTEM REQUIRED, (1) SEPTIC PUMP DETAIL TO BE PROVIDED BY INSTALLER PRIOR TO ISSUANCE OF SEPTIC PERMIT (2) PUMP PERFORMANCE TEST IS NECESSARY PRIOR TO HEALTH DEPARTMENT APPROVAL OF SEPTIC PERMIT


NEITHER THE HOWARD COUNTY COUNCIL NOR THE HEALTH DEPARTMENT IS RESPONSIBLE FOR THE
SUCCESSFUL OPERATION OF ANY SYSTEM

PERMITTEE RESPONSIBLE FOR OBTAINING FINAL APPROVAL ON THIS PERMIT

CALL 410-313-2640 FOR INSPECTION OF SEPTIC SYSTEM

P 514968

③ 5' 2min 3:56
3:57
3:59

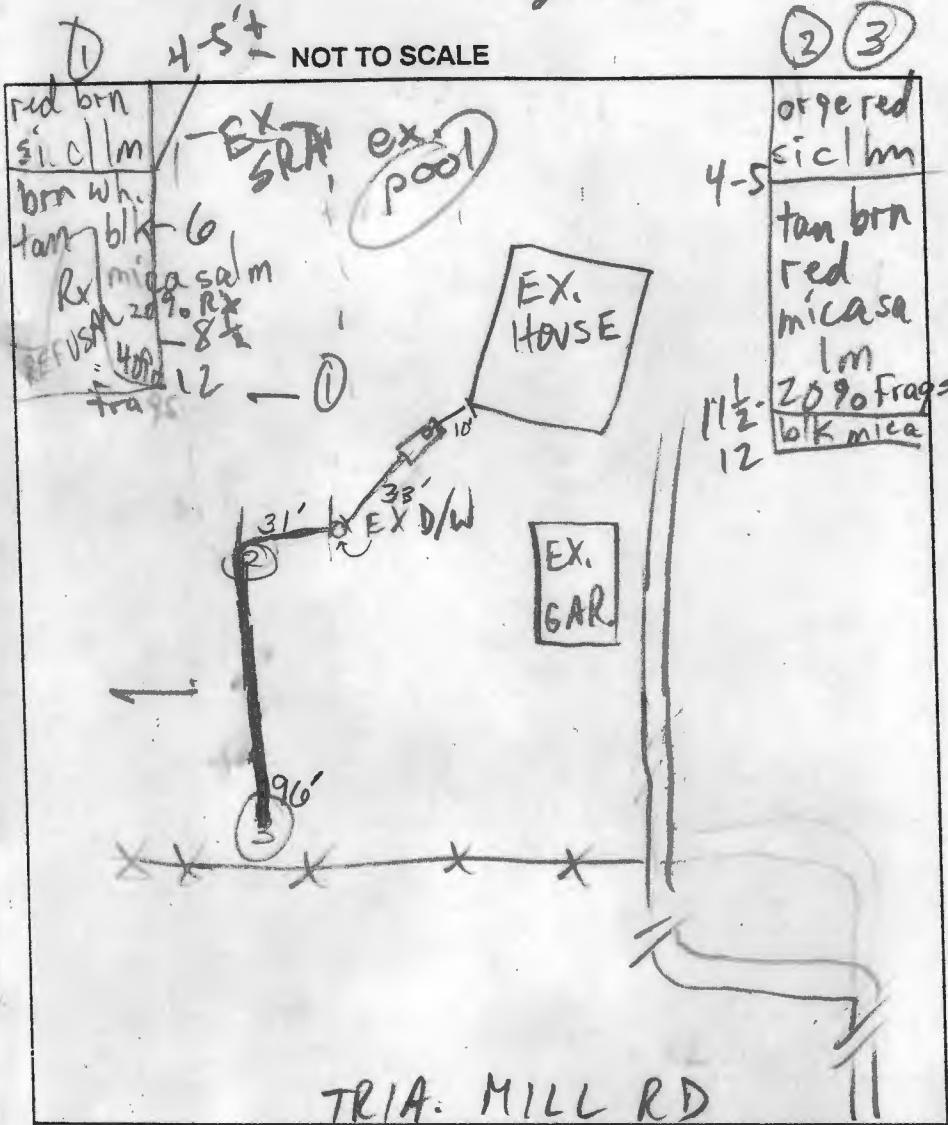

TRENCH DATA

TRENCH WIDTH 2'
TRENCH INLET DEPTH 4' 4"
TRENCH BOTTOM DEPTH 8' 3"
DEPTH OF STONE 4
NUMBER OF TRENCHES 1
TOTAL TRENCH LENGTH 96'
ABSORBENT AREA 38 4/5 ft²
DISTRIBUTION BOX LEVEL N/A
BAFFLE IN DISTRIBUTION BOX N/A

SEPTIC TANK DATA

SEPTIC TANK 1000 GALLONS
MANHOLE RISER 2 1/2 - 3' below
6 INCH INSPECTION PORT yes

PUMP CHAMBER DATA

PUMP CHAMBER GALLONS N/A
MANHOLE RISER —
ALARM —
PUMP PERFORMANCE TEST —

PRE-CONSTRUCTION INSPECTION: 8/16/01 OK TO START IN REVISED

REPAIR AREA (MR)

INSPECTION COMMENTS: 8-17-01 OK TO COVER (KG)

INSPECTOR

Handwritten signature: Godey K

DATE SYSTEM APPROVED

8-17-01