

410-730-0810

EMERGENCY/TEMP NO. IF ANY

B 1 03018

SEQUENCE NO.
(MDE USE ONLY)STATE OF MARYLAND
PERMIT TO DRILL WELL
please print or type

STATE PERMIT NUMBER

H0 94 2956
fill in this form completely

Date Received (APA)

11/6/01

OWNER INFORMATION

BRANT WOOD LLC
Last Name First Name
8835-P Columbia 100 Parkway
Columbia MD 21045
Town State Zip

DRILLER INFORMATION

Michael Barlow MD 355
Driller's Name License No.
Michael Barlow Well Drilling
Firm Name
522 Underwood Lane Bel Air MD
Address
Signature Date 1-11-2001

B 2

WELL INFORMATION

APPROX. PUMPING RATE
(GAL. PER MIN.)

5

500

AVERAGE DAILY QUANTITY NEEDED
(GAL. PER DAY)

14

20

USE FOR WATER (CIRCLE APPROPRIATE BOX)

DOMESTIC POTABLE SUPPLY & RESIDENTIAL
IRRIGATIONFARMING (LIVESTOCK WATERING & AGRICULTURAL
IRRIGATION)

INDUSTRIAL, COMMERCIAL, DEWATERING



PUBLIC WATER SUPPLY WELL



TEST, OBSERVATION, MONITORING



GEO-THERMAL

APPROXIMATE DEPTH OF WELL 300' FEET

APPROXIMATE DIAMETER OF WELL 6" NEAREST INCH

METHOD OF DRILLING (circle one)

BORED (or Augered)

JETTED

Jetted & DRIVEN

AIR-ROTARY

AIR-PERCussion

ROTARY (Hydraulic Rotary)

CABLE

Reverse-ROTARY

Drive-POINT

other

REPLACEMENT OR DEEPEINED WELLS
(CIRCLE APPROPRIATE BOX)

THIS WELL WILL NOT REPLACE AN EXISTING WELL

THIS WELL WILL REPLACE A WELL THAT WILL BE
ABANDONED AND SEALEDTHIS WELL WILL REPLACE A WELL THAT WILL BE USED
AS A STANDBY-CONTACT LOCAL APPROVING AUTHORITY
FOR POLICY ON STANDBY WELLS

THIS WELL WILL DEEPEIN AN EXISTING WELL

PERMIT NUMBER OF WELL TO BE REPLACED OR DEEPEINED
(IF AVAILABLE)

52

Not to be filled in by driller (MDE OR COUNTY USE ONLY)

APPROX. PERMIT NUMBER

H098 GAP G003(2)

PERMIT NO

H0 94 - 2956

SPECIAL CONDITIONS

NOTE: APPROVING AUTHORITIES SHOULD USE SEPARATE SHEET IF NEEDED.

B 3

LOCATION OF WELL

8 COUNTY

Howard
BRANT WOOD

23 SUBDIVISION

SECTION 3


LOT 12

52 NEAREST TOWN

MILES FROM TOWN (enter 0 if in town)

2 M I

B 4

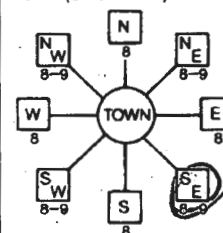1 2
DIRECTION OF WELL FROM
TOWN (CIRCLE BOX)ON WHICH SIDE OF ROAD
(CIRCLE APPROPRIATE BOX)

DISTANCE FROM ROAD

ENTER FT OR MI

TAX MAP: BLK: PARCEL

NOT TO BE FILLED IN BY DRILLER
HEALTH DEPARTMENT APPROVAL

Howard CO A510571m

COUNTY NAME

COUNTY NO.

STATE
SIGNATURE

INSERT S

DATE ISSUED

1/25/01 A. M. M. M. 1/25/02

43 MM DD YY 48

CO SIGNATURE

EXP. DATE

NORTH

GRID

520 000 55

EAST

GRID

820 000 63

SHOW MAJOR FEATURES OF
BOX & LOCATE WELL
WITH AN X

SOURCES OF DRILLING WATER

1.

2.

3.


WRITE THE BOX NUMBER
FROM THE MAP HERE

E


820

N

520

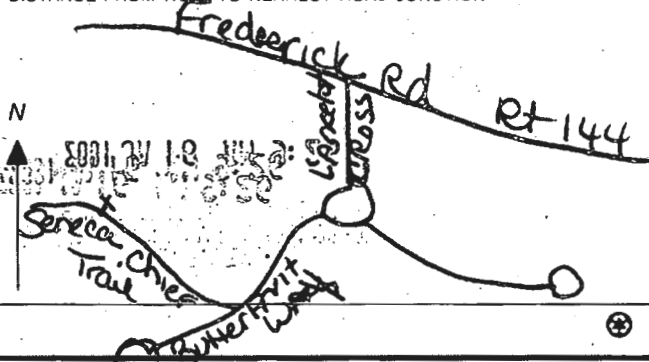DRAW A SKETCH BELOW SHOWING LOCATION OF WELL IN
RELATION TO NEARBY TOWNS AND ROADS AND GIVE
DISTANCE FROM WELL TO NEAREST ROAD JUNCTION

COUNTY

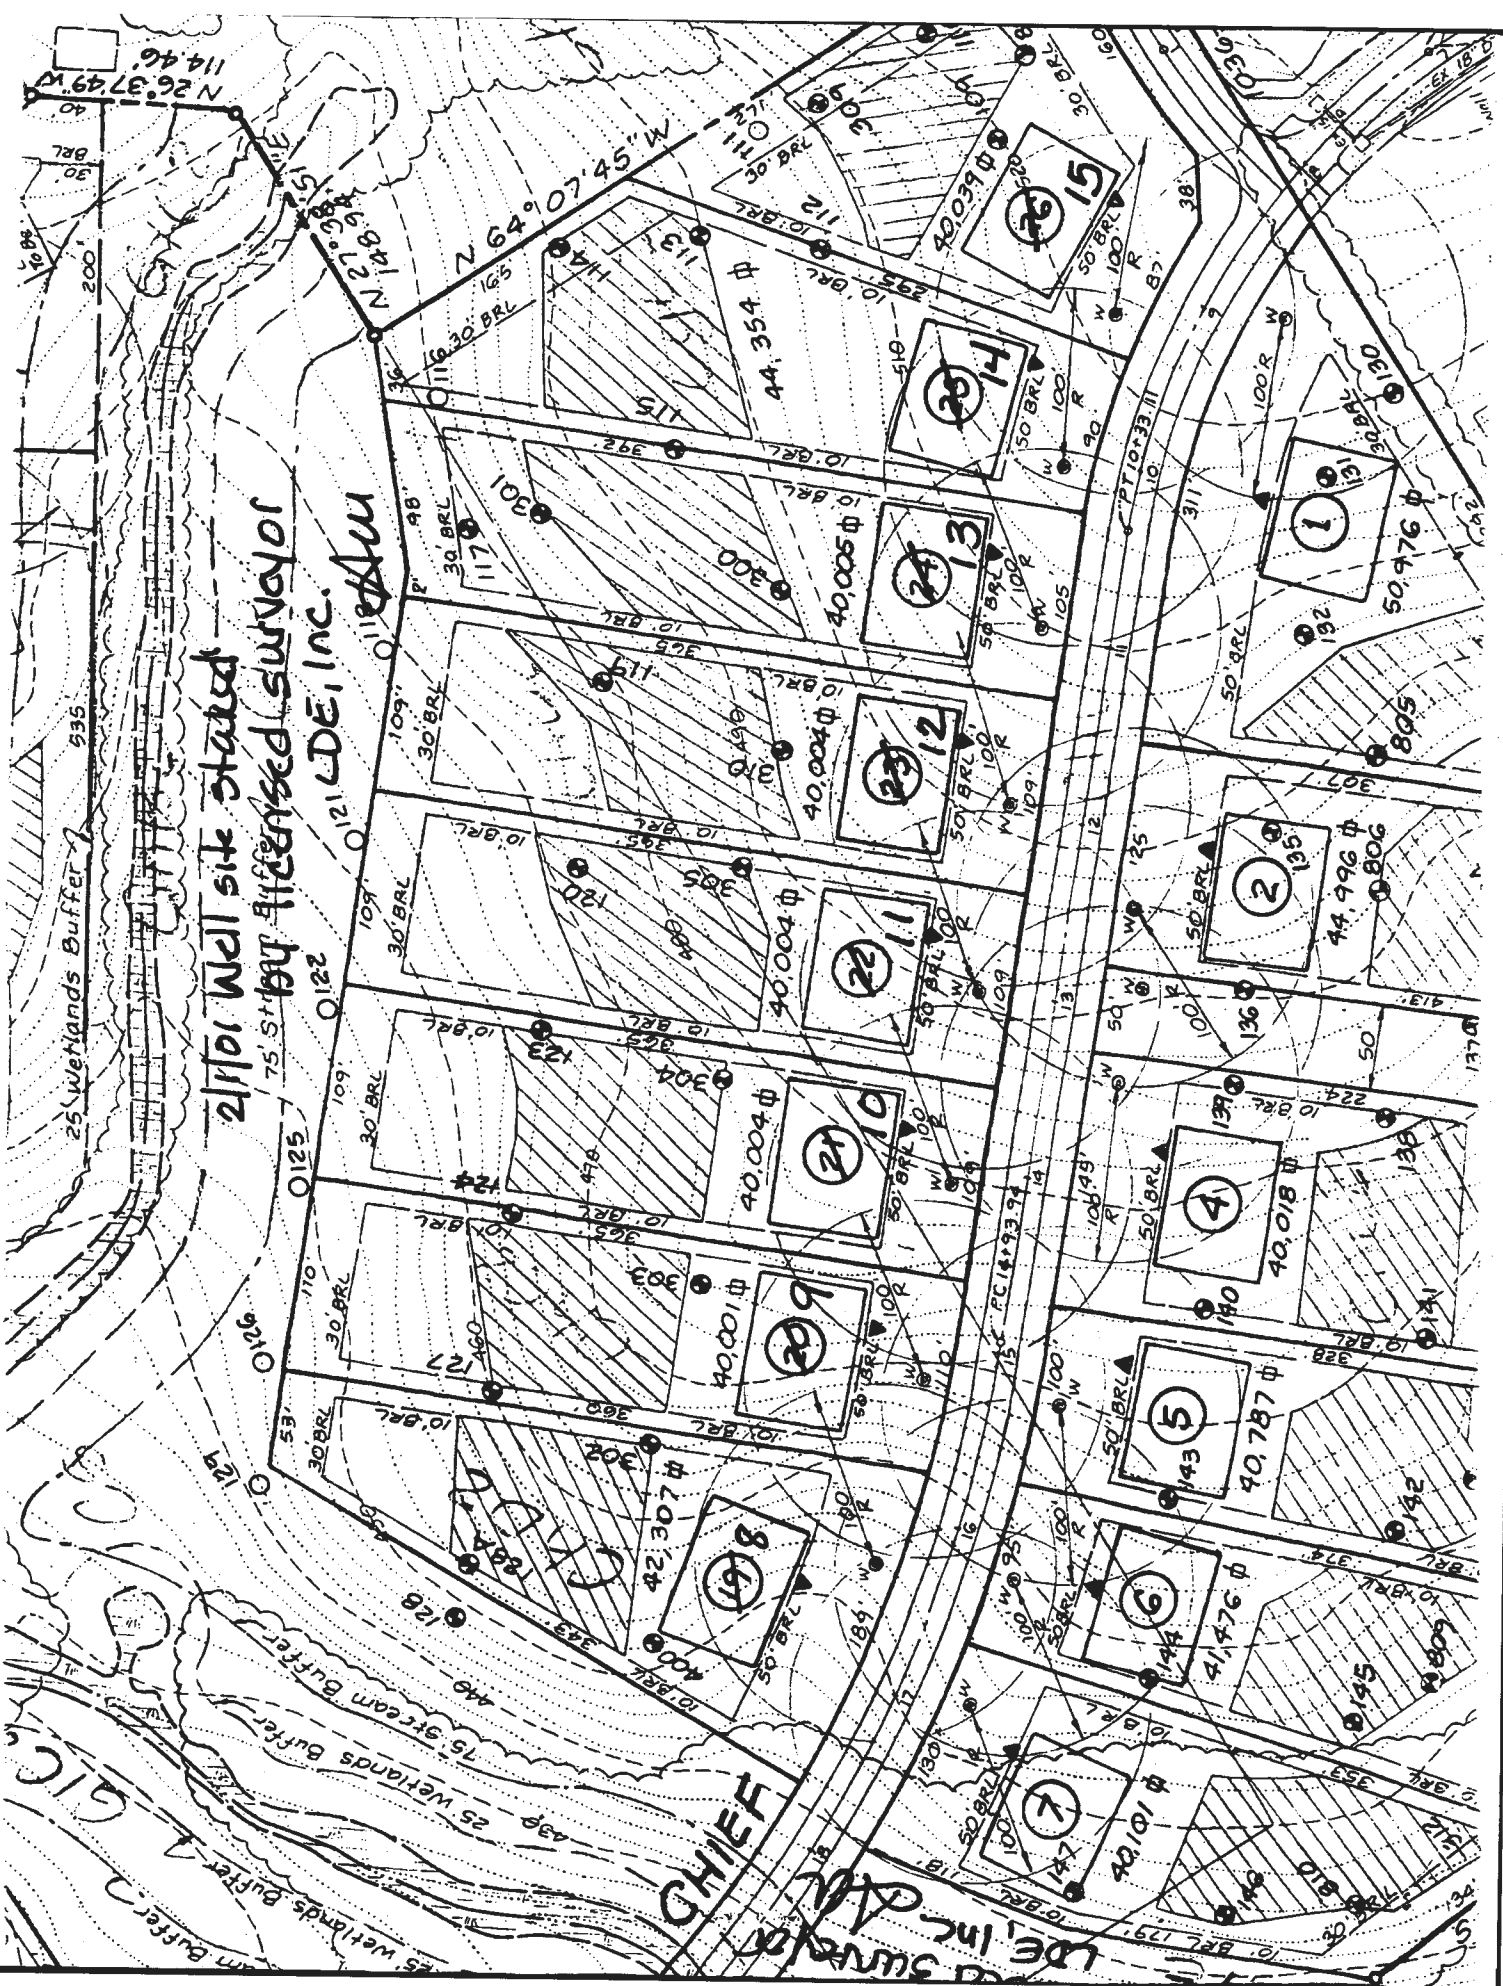

2/1/01 Well site started
by licensed surveyor
LDE, Inc.

CHIEF

LDE, Inc.

SITE INSPECTION SHEET

OWNER: P. Muhammad PHONE #: _____

ADDRESS: 3044 Seneca Crest Trail CONTRACTOR: Fogles


WELL TAG #: 94-2956

SUBDIVISION: _____ LOT: 12 COUNTY #: B

PROPOSAL: Possible well out of water

Prop. well site insp.

LOCATION DIAGRAM

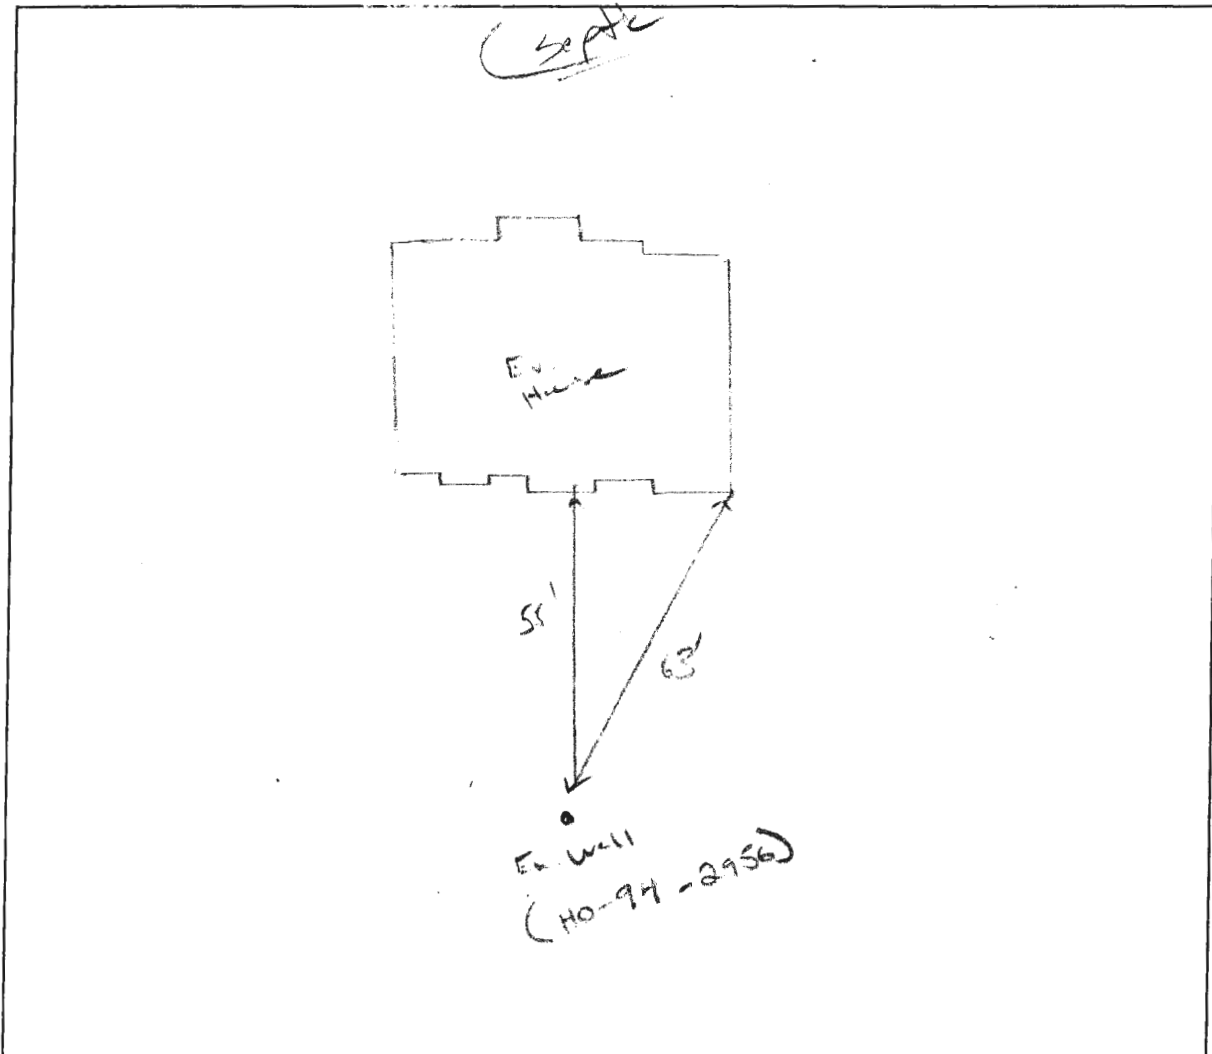

COMMENTS: Conclusion: homeowner doesn't seem to be out
of water. well dollar measured state H₂O level seems to be
holding @ or around 51'. (KW)

DATE: 8/21/08 INSPECTOR: (KW)