

11/9 AM ✓
DATE ✓
P.M.
2 (steps)

104-11-00-566401

PERMIT

File

W.T.C.U.
R.A.C.B.

P 47316

SEWAGE DISPOSAL SYSTEM

A REPAIR

DEPARTMENT OF HEALTH AND MENTAL HYGIENE

DISTRICT

HOWARD COUNTY HEALTH DEPARTMENT

DATE 7/17/91

BUREAU OF ENVIRONMENTAL HEALTH

461-9933

DATE SYSTEM APPROVED 8/1/91

INDEXED

INSPECTOR C.B. ✓

Donald Parlette

IS PERMITTED TO INSTALL ☒ ALTER ☐

ADDRESS 6575 Route 32, Clarksville, Maryland 21737

PHONE 531-2140

SUBDIVISION LOT ROAD 13079 Triadelphia Mill Road

PROPERTY OWNER Mr. James B. Shaw, Sr.

ADDRESS 13079 Triadelphia Mill Road, Clarksville, Md. 21029

SEPTIC TANK CAPACITY 1500 GALLONS 8/1/91 per contractor A.M.)

NUMBER OF BEDROOMS 3

SQUARE FEET PER BEDROOM

LINEAR FEET OF TRENCH REQUIRED

REPAIR - OVERFLOWING SEPTIC SYSTEM. Call for inspection when ground is opened so
sanitarian can recommend.

Replacing - very old system
8/1/91 "0" Trench & "1" Septic Tank - oh to continue
on project. Trench 40' to 50' long; 2' wide & 1' deep
slow O.G. and maximum C.B. depth 13' + every 4' as shown
on back. [8/1/91 C.B. for] [P.M. done by mistake
per contractor] 10' 4"

PLANS APPROVED BY Craig Williams

DATE 07/17/91

COVER NO WORK UNTIL INSPECTED AND APPROVED.

NEITHER THE HOWARD COUNTY COUNCIL NOR THE HEALTH DEPARTMENT IS RESPONSIBLE FOR THE SUCCESSFUL OPERATION OF ANY SYSTEM

NOTE: CLEANOUT REQUIRED EVERY 70 FEET OF SEWER LINE AND/OR AT 90° SWEEPS IN LINES FROM HOUSE TO DRAIN FIELDS, 90° ELBOWS NOT ACCEPTABLE.

NOTE: ALL PARTS OF SEPTIC SYSTEMS (I.E. TANK, DISTRIBUTION BOX TRENCHES) TO BE 100 FEET FROM WELL (UNLESS OTHERWISE SPECIFICALLY AUTHORIZED)

NOTE: IF DEEP TRENCH(ES) ARE USED CALL FOR INSPECTION BEFORE AND AFTER PLACING GRAVEL IN TRENCH(ES)

NOTE: NO DRY WELL SHALL EXCEED 15 FOOT IN DIAMETER NO ABSORPTION TRENCH TO EXCEED 100 FEET IN LENGTH


NOTE: ALL PIPE FROM HOUSE TO SEPTIC TANK MUST BE CAST IRON OR SCHEDULE 35/40 PVC OR ABS

PERMIT VOID AFTER TWO YEARS

NOTE: INSTALL STAND PIPE ON SEPTIC TANK AND DRY WELL STAND PIPES MUST BE 6 INCHES IN DIAMETER CAST IRON. CONCRETE OR TERRA COTTA OR PVA OR ABS ACCEPTED. IF TOP OF SEPTIC TANK IS DEEPER THAN 3 FEET. MANHOLE TO GRADE REQUIRED.

NOTE: DISTRIBUTION BOXES MUST HAVE BAFFLES

*INSTALLER IS RESPONSIBLE FOR OBTAINING FINAL APPROVAL ON THIS PERMIT

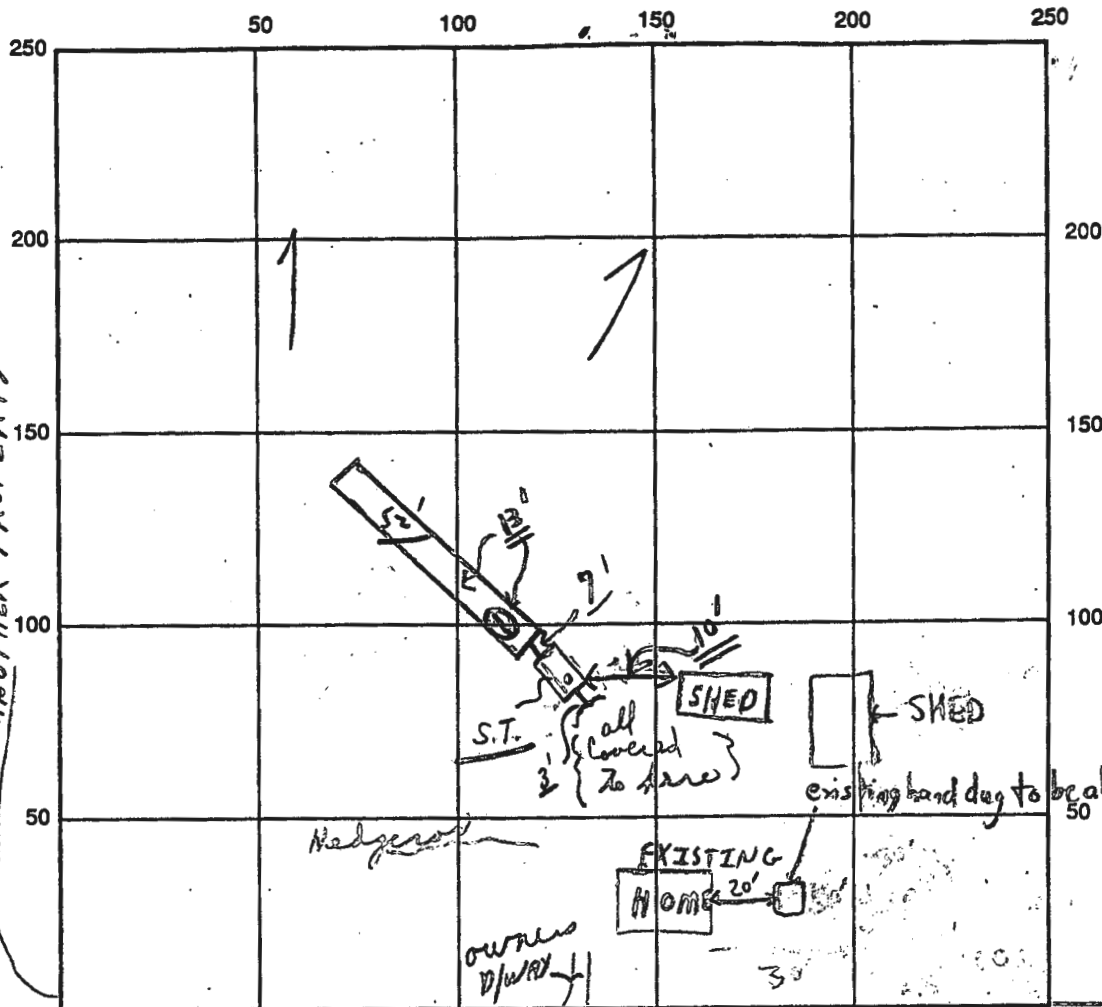

4.000
P.M.

Note 0'-3' ch
0 2 1/2' 3' do
sand
13' Mix
Loa
dry

INDICATE NORTH - NAME ADJOINING ROADWAY AS BASE LINE

SEPTIC TANK LEVEL 1500 gallon OK TRIADELPHIA MILL ROAD ST. OK CLEANOUTS OK

DISTRIBUTION BOX LEVEL N/A

DRAIN FIELD/TITLE DEPTH 13 1/2' average FT. TRENCH WIDTH 2 FT. INLET DEPTH 2 FT.

EFFECTIVE GRAVEL DEPTH 10 1/2' per owner + contractor FT. TOTAL LENGTH 52 FT.

NUMBER OF TRENCHES 1 ONE SIDEWALL/BOTTOM AREA 520 SQ. FT.

DRYWALL INSIDE DIAMETER — FT. EFFECTIVE DEPTH BELOW INLET — FT.

ABSORBENT AREA 520 SQ. FT.

REMARKS: 8/1/91 A.M. - Partial - ok to continue on #1 Trench;
8/1/91 Later P.M. - Final; c.R.A.

DATE SYSTEM APPROVED 8/1/91 INSPECTOR Charles, Bryan M. Stenke

SITE INSPECTION SHEET

OWNER: James Shaw

DATE REQUESTED: 8/6/99 11:00

ADDRESS: 13079 Triadelphia Mill
Clarksville, MD


DRILLER: EASTERNY (PENDING)

WELL TAG # _____

COUNTY # 47316

PROPOSAL: to drill replacement water well - existing hand
dug well is failing

LOCATION DIAGRAM

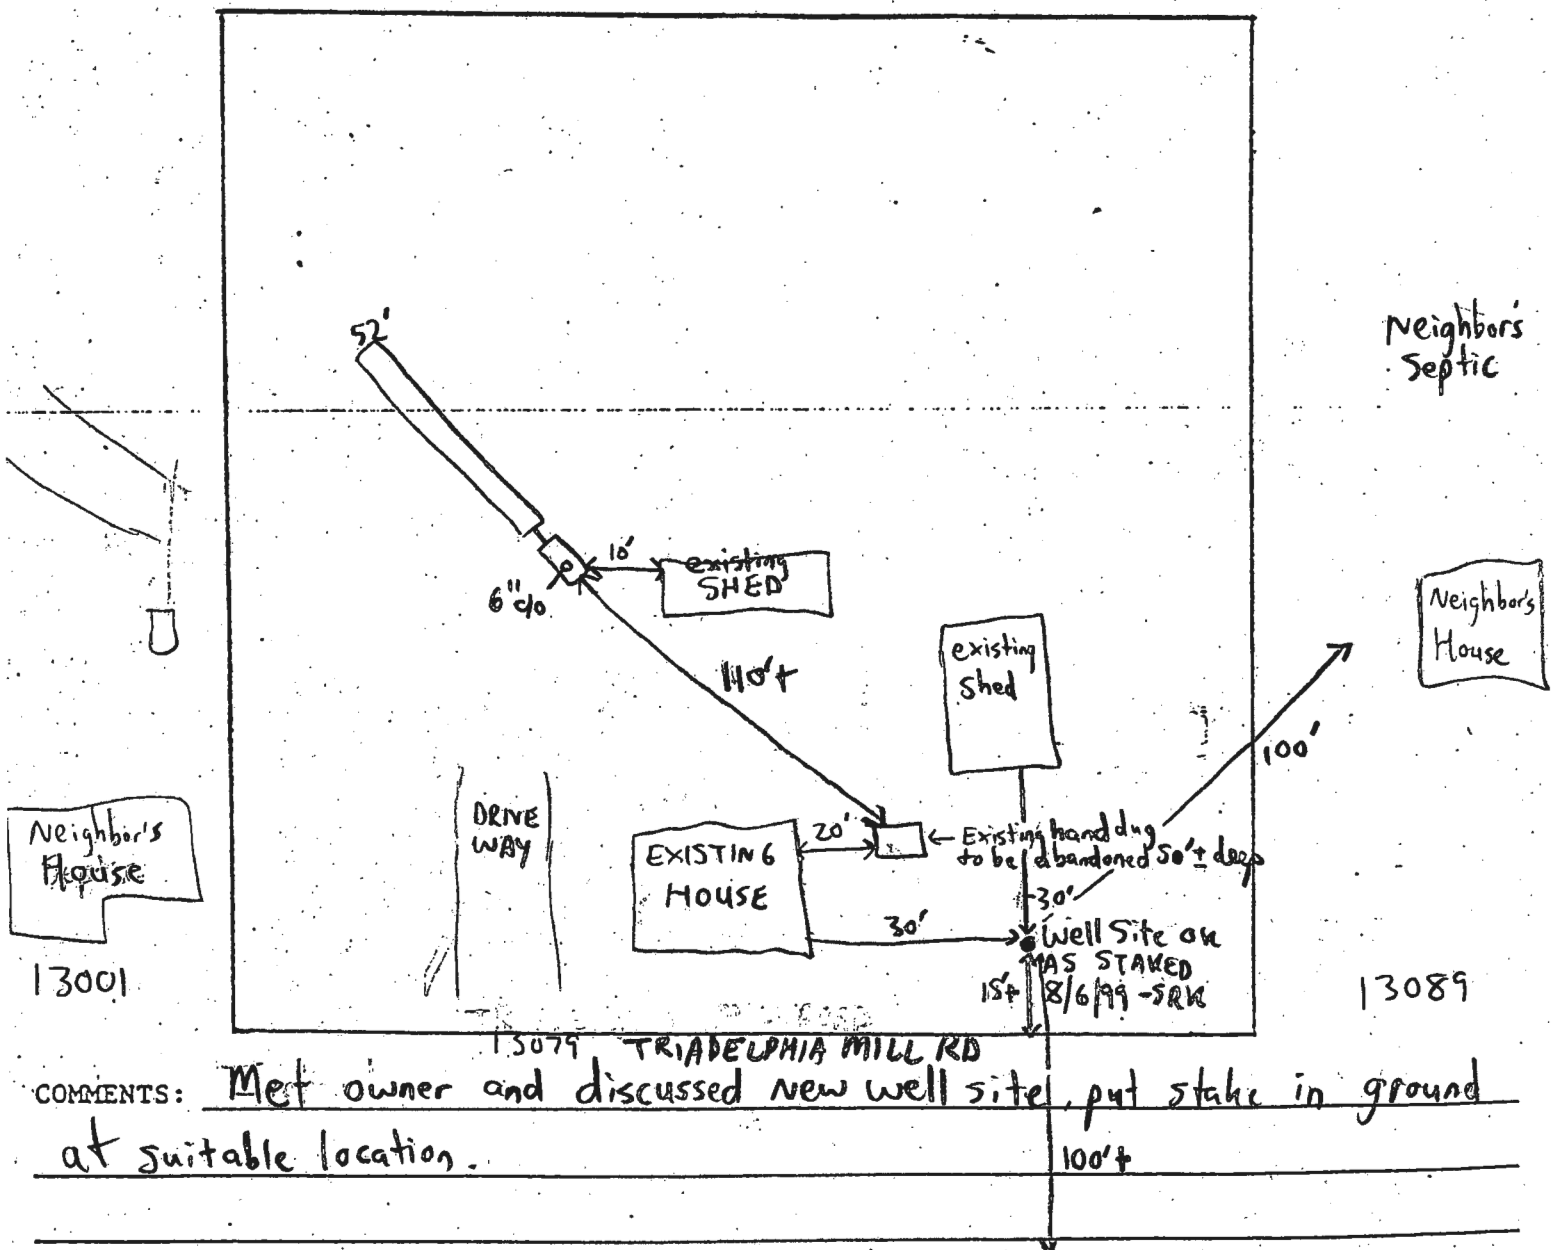

COMMENTS: Met owner and discussed new well site, put stake in ground
at suitable location.

DATE: 8/6/99

INSPECTOR: S.R.K.