COMPLETE THIS FORM WHEN DROPPING OFF ANY CORRESPONDENCE AND/OR PLANS TO THE HOWARD COUNTY DEPARTMENT OF INSPECTIONS, LICENSES AND PERMITS COUNTER:

Date:	2-22-19		
To:	PLAN REVIEW (Person's Name and Division)		
From:	CHRROLL HOME SELVICES (443) 456-3626 (Your Name, Company Name and Telephone Number)	_RECEIVED	
Subject:	Project name Rusidential Track Premit	FEB 27 2019	
	Project site address 12024 HAII Shop Rd	PLAN REVIEW DIVISION	
	Permit # <u>B1800.0438</u> SDP #		
	Other information pertinent to this project		
✓ Please c	check the attachments below that you are submitting with this transmittal:		
Le	etter of response to address plan review comment letter		
Re	Revised plans and/or revised details: When submitting for a complete re-review, duplicate sets shall be submitted. Letter Summarizing Changes		
Er	nergy conservation calculations		
Co	opies of (be specific).		
	Health Department Request DPZ/ DED Request	Applicant's Request	
Tv	wo sets of single family dwelling model plans to be placed on permanent file: Model name	e and/or #	
01	ther Notice of Violation, Copy of Perent		
C	ontact Person Information: (Required)		
PI	Blair Murson Telephone No: 443		
	E-Mail Address: bin 4	Home Selvices, com	
	CHILDU	bom Eselvices, com	
NECESSA INFORM OF INSP	ASSURE ALL DOCUMENTS AND/OR REVISIONS ARE APPROPRIATELY <u>SIG</u> ARY, BY A LICENSED ARCHITECT OR ENGINEER. PLEASE BE ADVISED ATION MAY RESULT IN THE DELAY OF REVIEW BY THE PLANS EXAMINER ECTIONS, LICENSES AND PERMITS WILL CONTACT YOU IF THERE IS A PRO	THAT INSUFFICIENT R. THE DEPARTMENT BLEM. IN ADDITION,	
SIGNATO	HE BUILDING PERMIT IS APPROVED BY THE PLAN REVIEW DIVISION AND A ORY AGENCIES, AND THE BUILDING PERMIT <u>IS</u> READY FOR ISSUANCE, T	HE PERMIT DIVISION	
	OTIFY THE APPROPRIATE CONTACT PERSON FOR PERMIT PICK UP.		
INQUIRIES SHALL BE DIRECTED TO THE PERMIT DIVISION AT 410-313-2455. CODE RELATED QUESTIONS			

PLEASE ALLOW A MINIMUM OF FIVE (5) WORKING DAYS FOR ANY PLAN SUBMITTALS TO BE REVIEWED.


Received by HUMMA

THANK YOU.

White-Plan Review / Yellow-Applicant / Pink-Permit Division t:\Operations\Updated forms\transmit.frm - Rev. 04/2014

\$25.N

DILP 2019 FEB 22 0×11:2

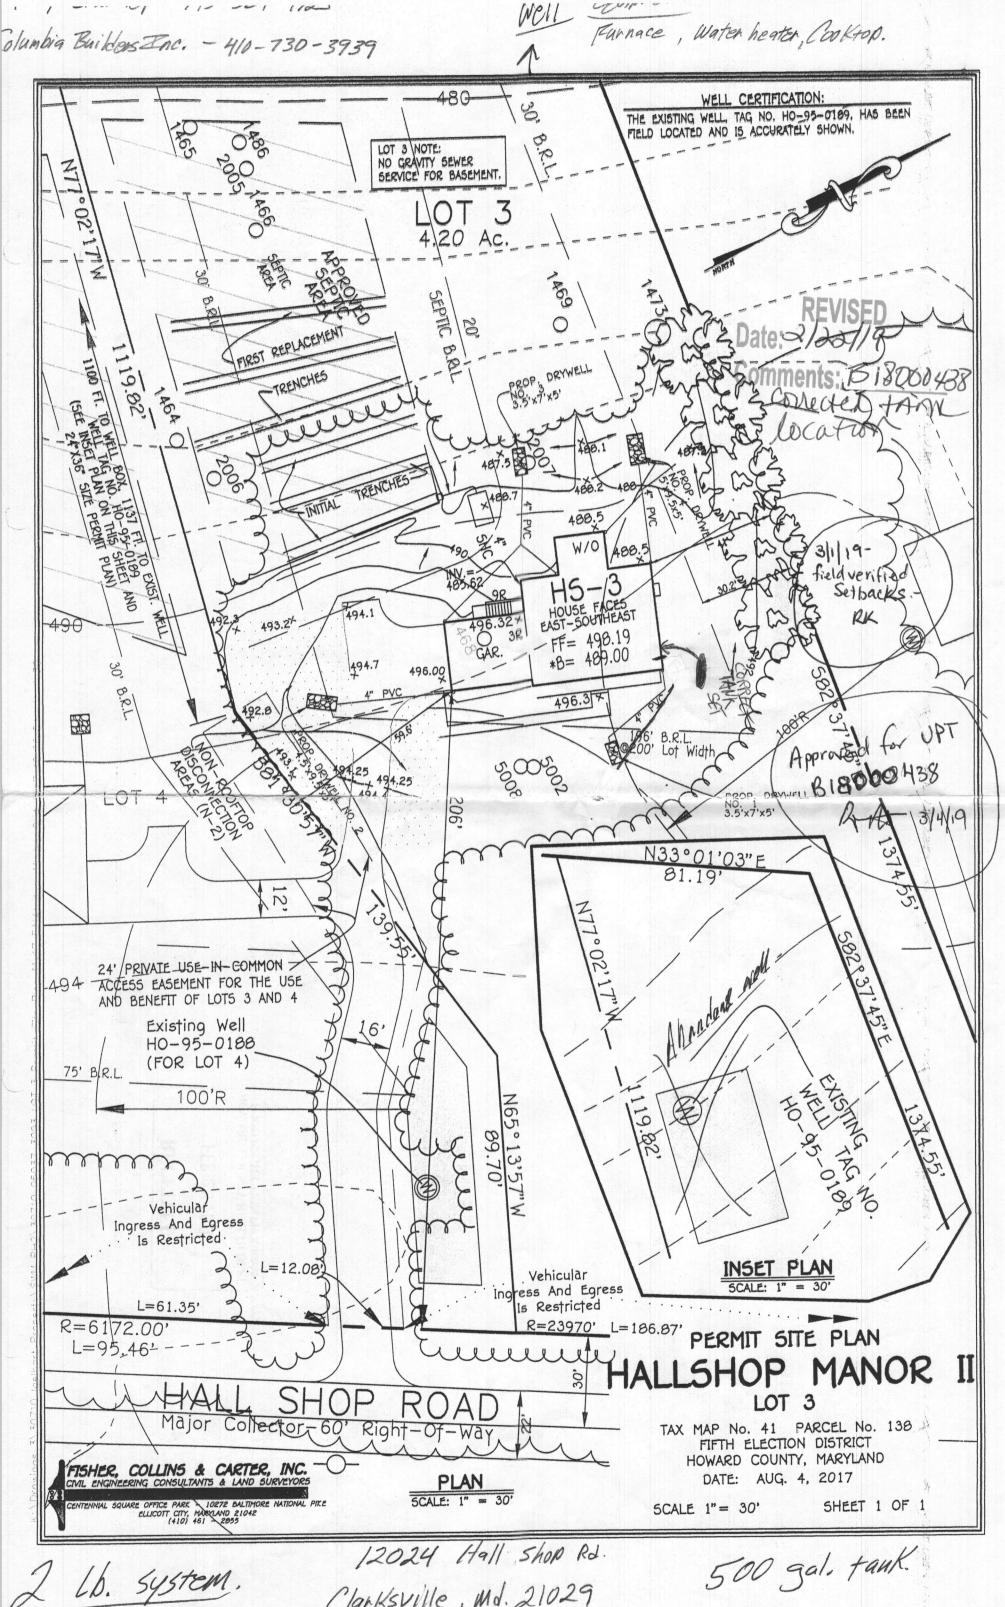

Clarksville, Md. 21029