



Building Permit Application

Howard County Maryland
Department of Inspections, Licenses and Permits
3430 Court House Drive
Permits: 410-313-2455
www.howardcountymd.gov

DLP 2018 NOV 30 AM 8:17

Date Received: _____

Permit No.: B18004036

Building Address: 5305 Talbots Lane Landing

City: Ellicott City State: MD Zip Code: _____

Suite/Apt. # _____ SDP/WP/BA #: _____

Census Tract: _____ Subdivision: _____

Section: _____ Area: _____ Lot: 116

Tax Map: _____ Parcel: _____ Grid: _____

Zoning: _____ Map Coordinates: _____ Lot Size: _____

Existing Use: SFD

Proposed Use: SFD - with tank

Estimated Construction Cost: \$ 6,000.00

Description of Work: Install 1x1000 u.g. propane tank and run gas line 20' to stub of house

Occupant/Tenant Name: _____

Was tenant space previously occupied? ☐ Yes ☐ No

Contact Name: _____

Address: _____

City: _____ State: _____ Zip Code: _____

Phone: _____ Fax: _____

Email: _____

Property Owner's Name: Carolyn Jones

Address: 2120 Baldwin Ave

City: Crofton State: MD Zip Code: 21114

Phone: _____ Fax: _____

Email: _____

Applicant's Name & Mailing Address, (If other than stated herein)

Applicant's Name: _____

Address: _____

City: _____ State: _____ Zip Code: _____

Phone: _____ Fax: _____

Email: _____

Contractor Company: Evergreen Propane

Contact Person: Bobby Parker

Address: 7629 Glenbrook Circle Rd

City: Curtis Bay State: MD Zip Code: 21226

License No.: 93150

Phone: 410-723-1132 Fax: 410-723-1134

Email: evergreenpropane@verizon.net

Engineer/Architect Company: _____

Responsible Design Prof.: _____

Address: _____

City: _____ State: _____ Zip Code: _____

Phone: _____ Fax: _____

Email: _____

Commercial Building Characteristics	Residential Building Characteristics
Height: _____	☐ SF Dwelling ☐ SF Townhouse
No. of stories: _____	Depth _____ Width _____
Gross area, sq. ft./floor: _____	1 st floor: _____
	2 nd floor: _____
Area of construction (sq. ft.): _____	Basement: _____
	☐ Finished Basement
Use group: _____	☐ Unfinished Basement
	☐ Crawl Space
Construction type: _____	☐ Slab on Grade
☐ Reinforced Concrete	No. of Bedrooms: _____
☐ Structural Steel	Multi-family Dwelling
☐ Masonry	No. of efficiency units: _____
☐ Wood Frame	No. of 1 BR units: _____
☐ State Certified Modular	No. of 2 BR units: _____
	No. of 3 BR units: _____
	Other Structure: _____
	Dimensions: _____
Roadside Tree Project Permit	Footings: _____
☐ Yes ☐ No	Roof: _____
Roadside Tree Project Permit # _____	☐ State Certified Modular
	☐ Manufactured Home

Utilities
Electric: ☐ Yes ☐ No
Gas: ☐ Yes ☐ No
Water Supply
☒ Public
☐ Private
Sewage Disposal
☒ Public
☐ Private
Heating System
☐ Electric ☐ Oil
☐ Natural Gas ☐ Propane Gas
☐ Other: _____
Sprinkler System:
☐ Yes ☐ No
Grading Permit Number: _____
Building Shell Permit Number: _____

THE UNDERSIGNED HEREBY CERTIFIES AND AGREES AS FOLLOWS: (1) THAT HE/SHE IS AUTHORIZED TO MAKE THIS APPLICATION; (2) THAT THE INFORMATION IS CORRECT; (3) THAT HE/SHE WILL COMPLY WITH ALL REGULATIONS OF HOWARD COUNTY WHICH ARE APPLICABLE THERETO; (4) THAT HE/SHE WILL PERFORM NO WORK ON THE ABOVE REFERENCED PROPERTY NOT SPECIFICALLY DESCRIBED IN THIS APPLICATION; (5) THAT HE/SHE GRANTS COUNTY OFFICIALS THE RIGHT TO ENTER ONTO THIS PROPERTY FOR THE PURPOSE OF INSPECTING THE WORK PERMITTED AND POSTING NOTICES.

Applicant's Signature: _____
Email Address: evergreenpropane@verizon.net
Title/Company: Owner

Print Name: Bobby Parker
Date: 11/30/18

Checks Payable to: DIRECTOR OF FINANCE OF HOWARD COUNTY

PLEASE WRITE NEATLY & LEGIBLY

FOR OFFICE USE ONLY

AGENCY	DATE	SIGNATURE OF APPROVAL
State Highways		
Building Officials		
PSZA (Zoning)		
PSZA (Engineering)		
Health	<u>12/11/18</u>	<u>R. H. review not required</u>

Is Sediment Control approval required for issuance? ☐ Yes ☐ No

☐ CONTINGENCY CONSTRUCTION START

DPZ SETBACK INFORMATION
Front: _____
Rear: _____
Side: _____
Side St.: _____
All minimum setbacks met? ☐ Yes ☐ No
Is Entrance Permit Required? ☐ Yes ☐ No
Historic District? ☐ Yes ☐ No
Lot Coverage for New Town Zone: _____
SDP/Red-line approval date: _____

Filing Fee	\$
Permit Fee	\$ <u>1000</u>
Tech Fee	\$ <u>10</u>
Excise Tax	\$
PSFS	\$
Guaranty Fund	\$
Add'l per Fee	\$
Total Fees	\$ <u>1110.00</u>
Sub- Total Paid	\$
Balance Due	\$
Check	# <u>277</u>

Distribution of Copies: White: Building Officials

Green: PSZA, Zoning

Yellow: PSZA, Engineering

Pink: Health

Gold: SHA

T:\Operations\Updated Forms\Building appimp 09.13.2016.docx

MAIL TO CONTRACTOR

Cus 116

B-18001793

Dealer

5305 Talbots Ln.

Economy Propane


Bobby Perry

410-923-1132

Economy propane & verizon net

413-694-3649

Property on public water
Sewer no
review required
1/18/18

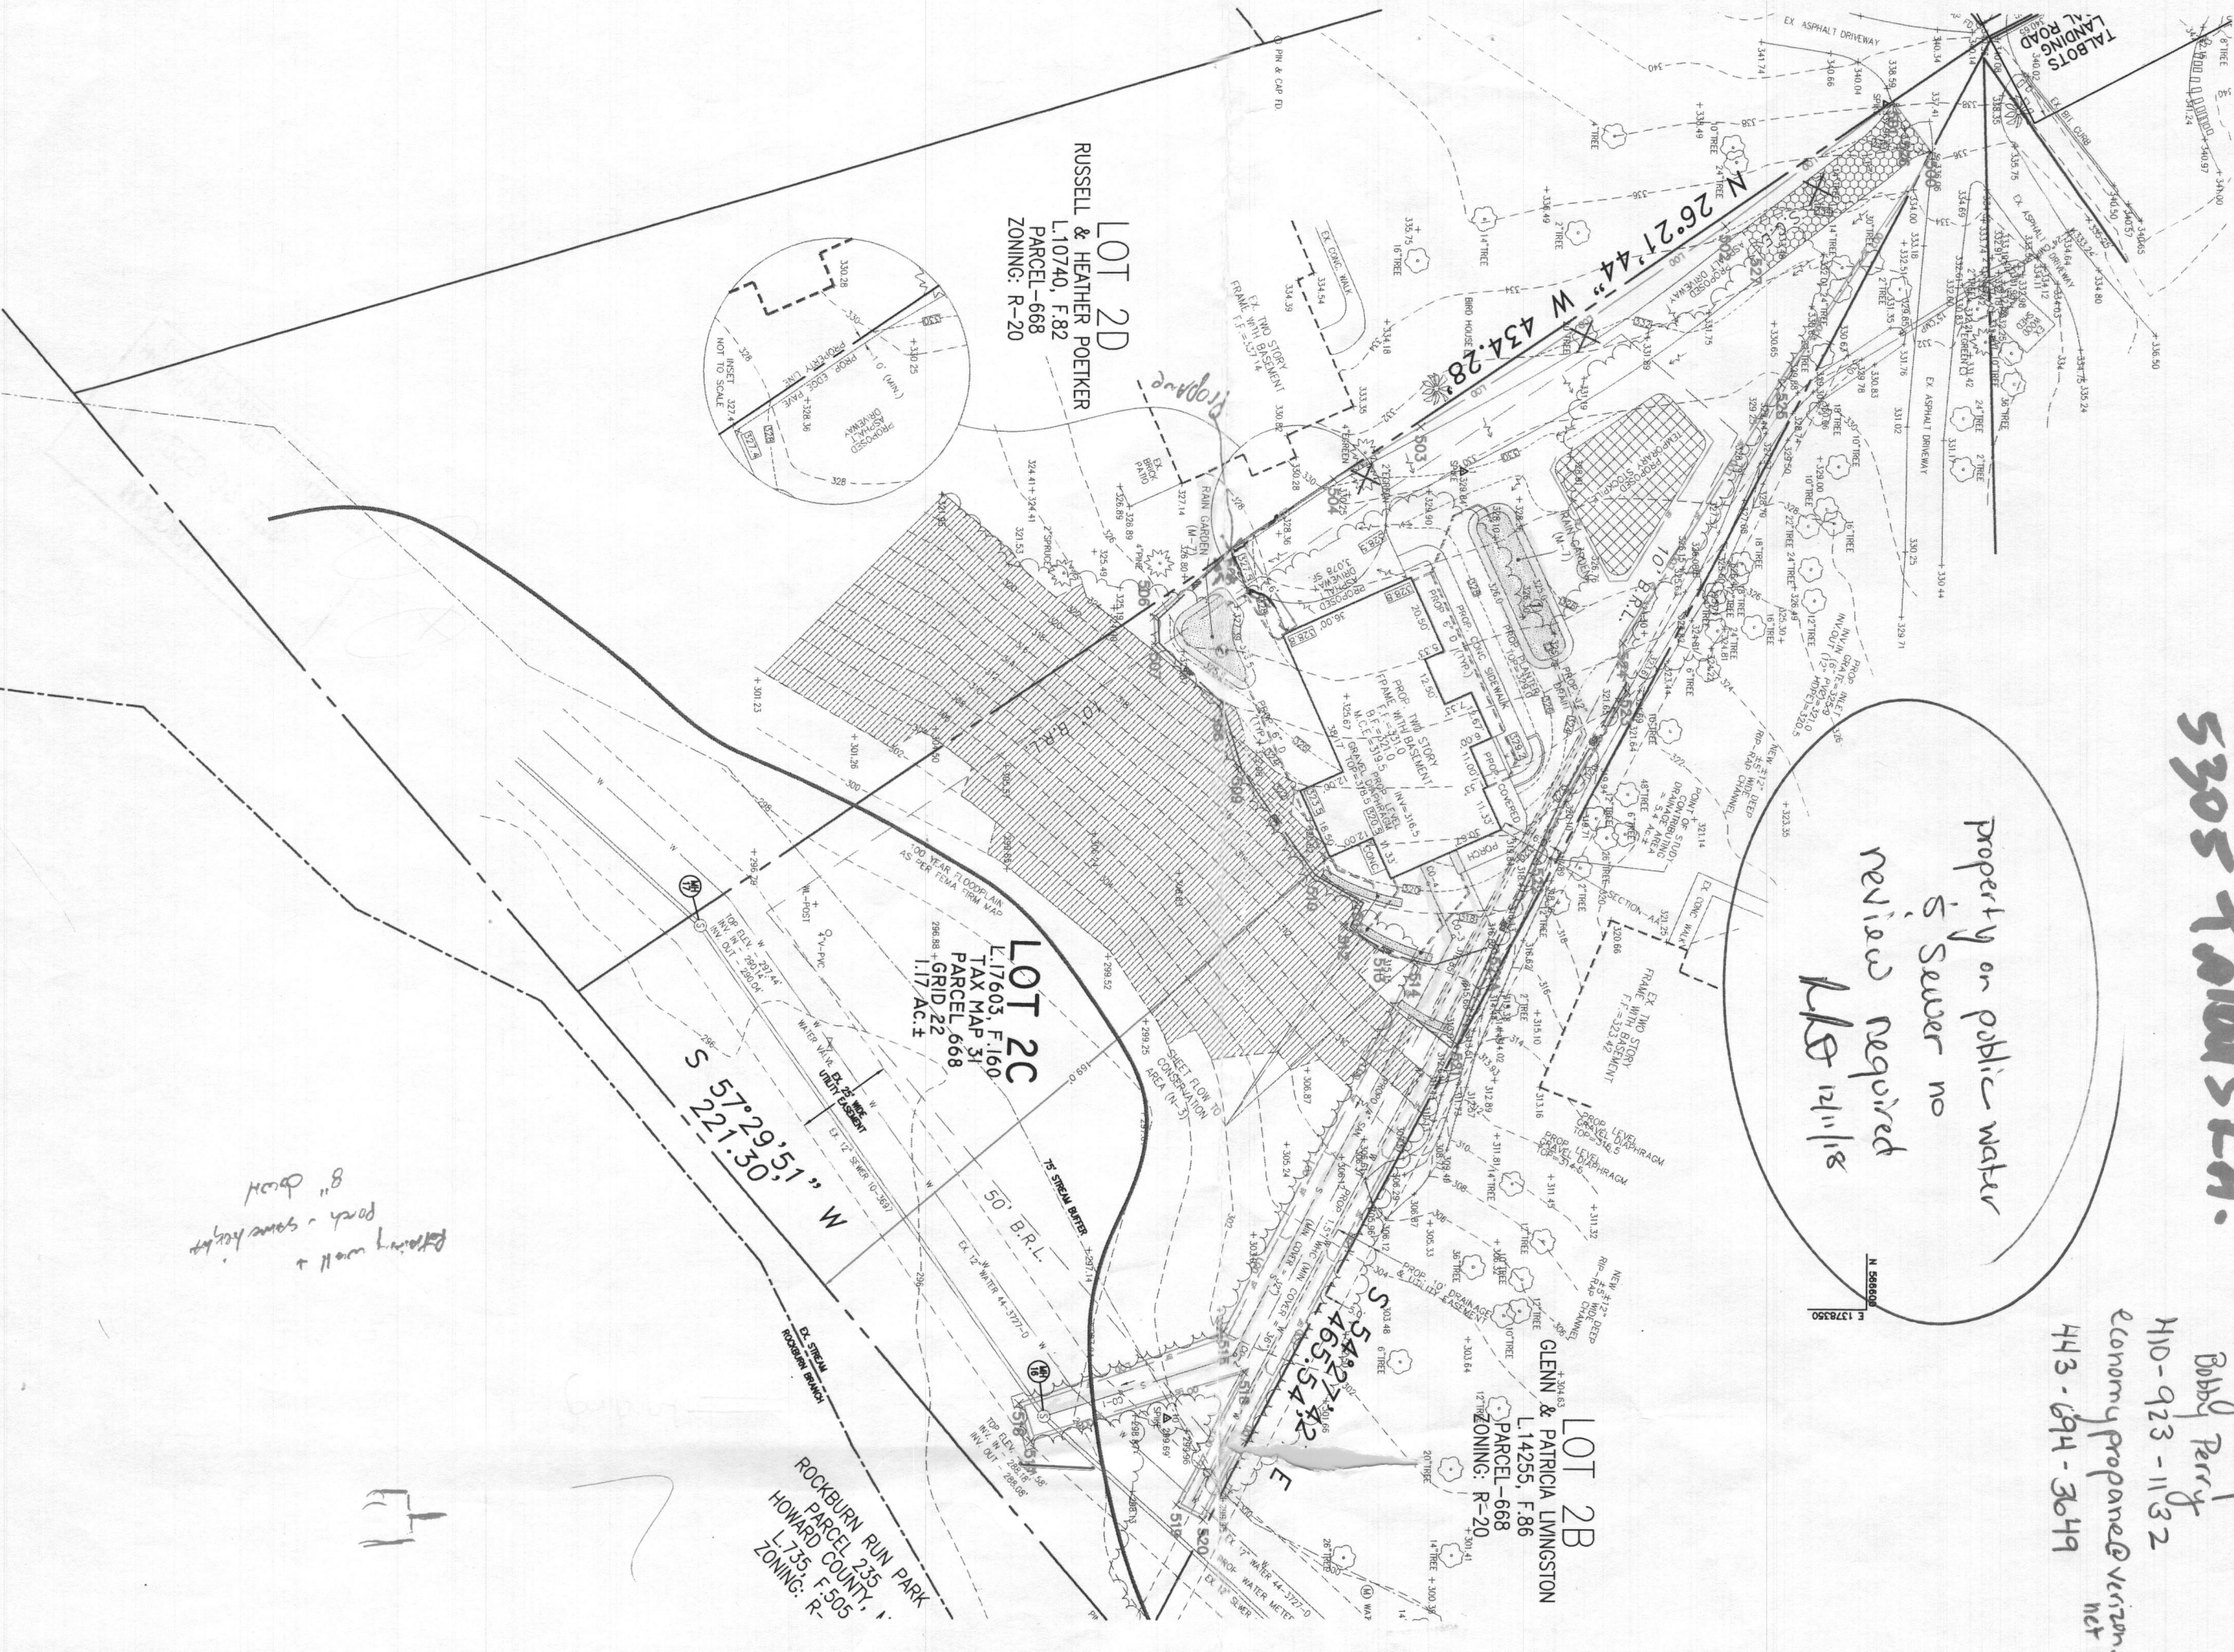

LOT 2D
RUSSELL & HEATHER POETKER
L.10740, F.82
PARCEL-668
ZONING: R-20

LOT 2C
L.17603, F.160
TAX MAP 31
PARCEL 668
GRID 22
1.17 AC.±

LOT 2B
GLENN & PATRICIA LIVINGSTON
L.14255, F.86
PARCEL-668
ZONING: R-20

Retaining wall +
8" down
porch - same height

41