

PERMITS NEEDED FOR PROJECT

- BUILDING
- ELECTRICAL
- PLUMBING
- MECHANICAL
- FIRE SPRINKLERS (POSSIBILITY)
- FRAMING
- INSULATION
- FINALS

2014 Terrapin Creek Rd.
SYKESVILLE, MD 21784
OWNERS: PURVESH PATEL
AMANDA PATEL
DECEMBER, 2018
1,737 SQUARE FEET
Bathroom 5'x9'

APPROVED

WALK-THRU BUILDING PERMIT

BP# 318004139 A#

APP. SAN R. Biala DATE: 1/18/19

DESC. OF WORK

Revise Finished Basement proposal
Revisions: add stove to wet bar
extend closet in Family Room
install shelf closet for Office & Rec Rm.

FINISHED FAMILY ROOM

APPROVED

WALK-THRU BUILDING PERMIT

BP# 318-4139 A#

APP. SAN H. Oswald DATE: 12/13

DESC. OF WORK: Finish


basement

KEY

- steel beam
- - - Prehung door
- △△ double bifold door
- gas furnace
- Mechanical objects
- 2 squares = 1 foot
- W window

MATERIALS

- Pressure treated (Bottom Plates)
- SPRUCE (Studs, top plates)
- 1/2 inch 4'x12' drywall
- 1/2 inch 4'x8' Green board

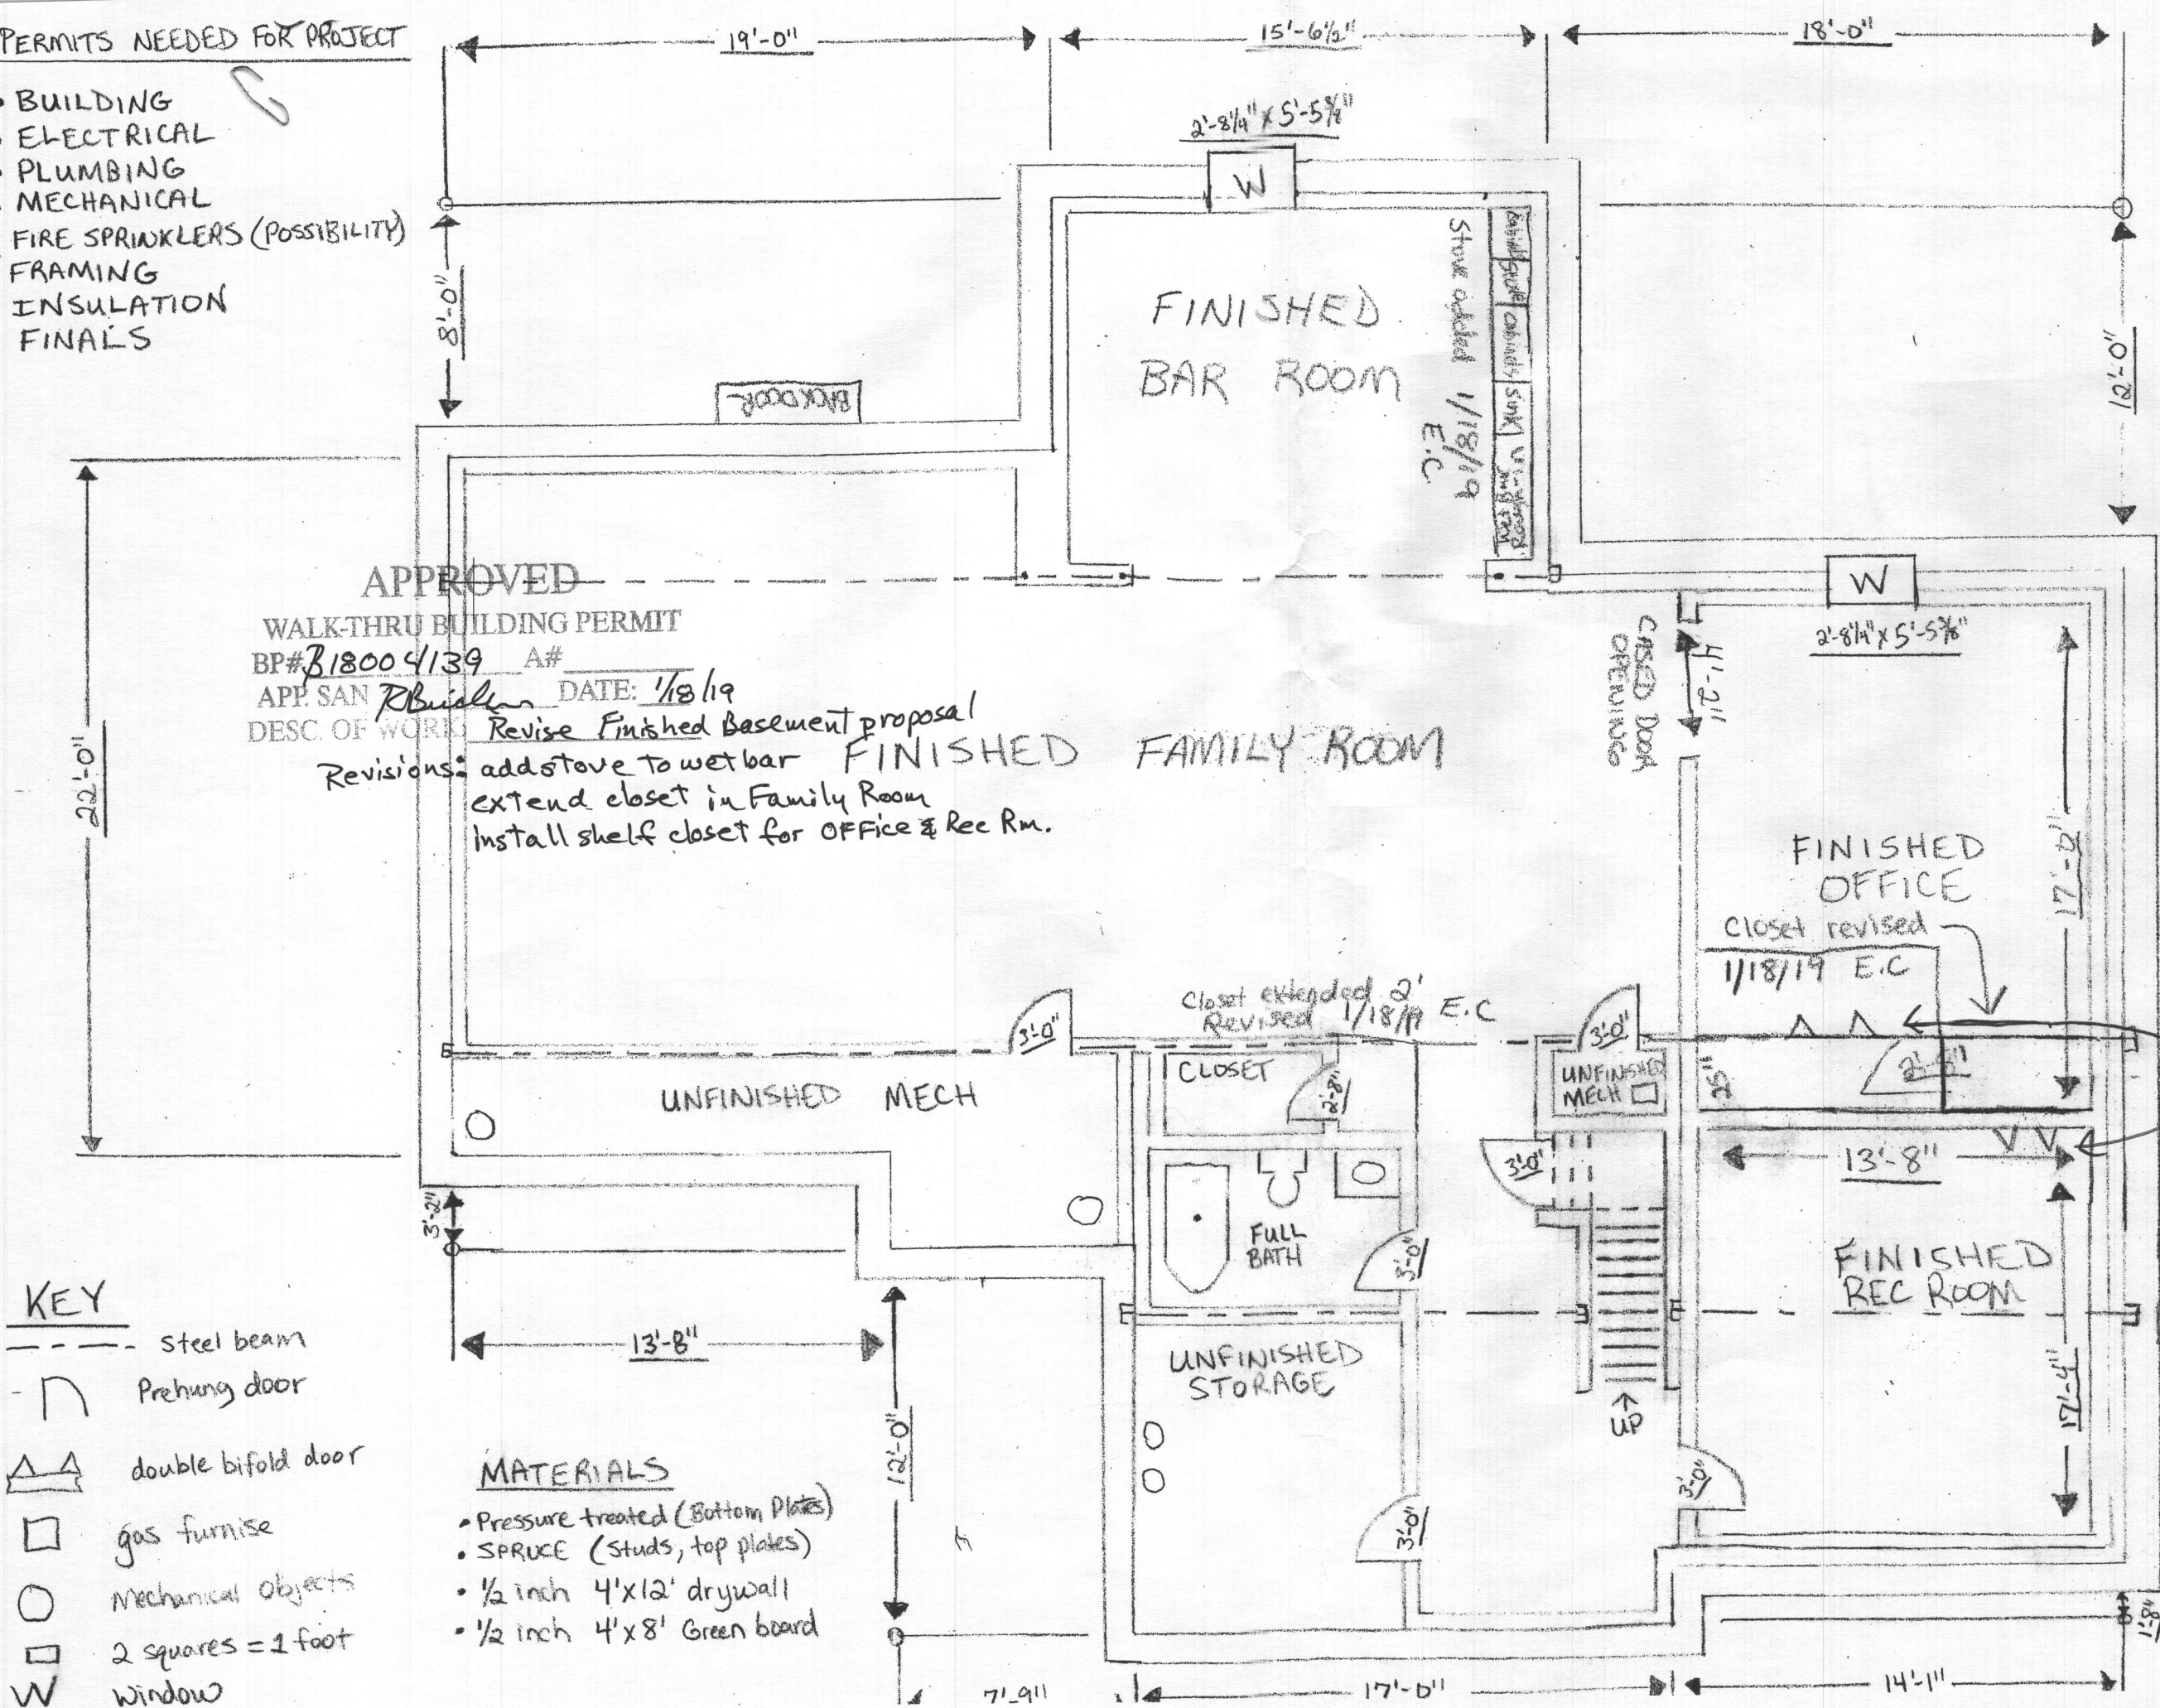

Finished office closet removed / changed to bi-fold 1/18/19