

SITE INSPECTION SHEET

OWNER: _____ PHONE #: _____


ADDRESS: 3270 Roscommon Dr. CONTRACTOR: _____

_____ WELL TAG #: _____

SUBDIVISION: _____ LOT: _____ COUNTY #: _____

PROPOSAL: Locate well to determine distance from new well drilled at
3255 Roscommon Dr.

LOCATION DIAGRAM

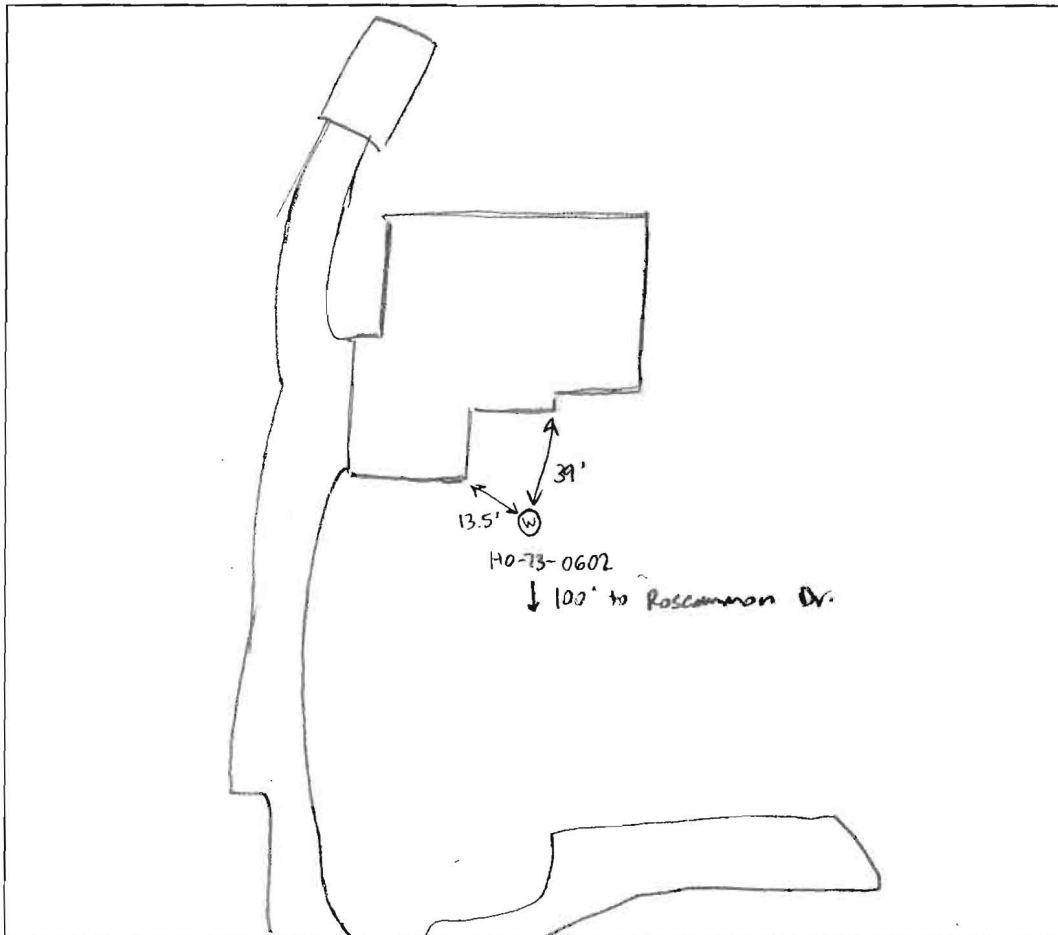

COMMENTS: _____

DATE: 1/16/19 INSPECTOR: Sarah Collins