



NOTES:

1. THE TOPOGRAPHY SLIGHT TERRAIN WAS FIELD-RUN BY SHANBERGER & LANE IN DECEMBER, 2005.
2. B.R.L. DESIGNATES BUILDING RESTRICTION LINE
3. C. DESIGNATES EX. UTIL.
4. THIS AREA DESIGNATES A PRIVATE SERVICE DISPOSAL AREA AS REQUIRED BY THE "DESIGNED STATE DEPARTMENT OF THE ENVIRONMENT FOR LANDFILL SERVICE DISPOSAL. IMPROVEMENTS OF ANY KIND IN THIS AREA ARE RESTRICTED. THIS DISPOSAL AREA SHALL BECOME NULL & VOID UPON CONNECTION TO A PUBLIC SERVICE SYSTEM. THE COUNTY HEALTH OFFICER SHALL HAVE THE AUTHORITY TO GRANT ADJUSTMENTS TO THE PRIVATE SERVICE DISPOSAL AREA.
5. THE LOTS SLIGHT TERRAIN COMPLY WITH THE MINIMUM GRADIENT PER LOT AREA AS REQUIRED BY THE MD STATE DEPARTMENT OF THE ENVIRONMENT.
6. SUBJECT PROPERTY ZONING: RC-CRO
7. TOTAL PROPERTY AREA PER 2005 SURVEY BY SHANBERGER & LANE: 10608 AC. ±
8. THE EXISTING PROPERTY IS SERVED BY PRIVATE WATER AND SEWER.
9. LIMIT OF DISURBANCE: 3107 SEE 3 3 3 3 3

B001579923
ENCLOSED
BUILDS
OK as
shown
2/9/06
8

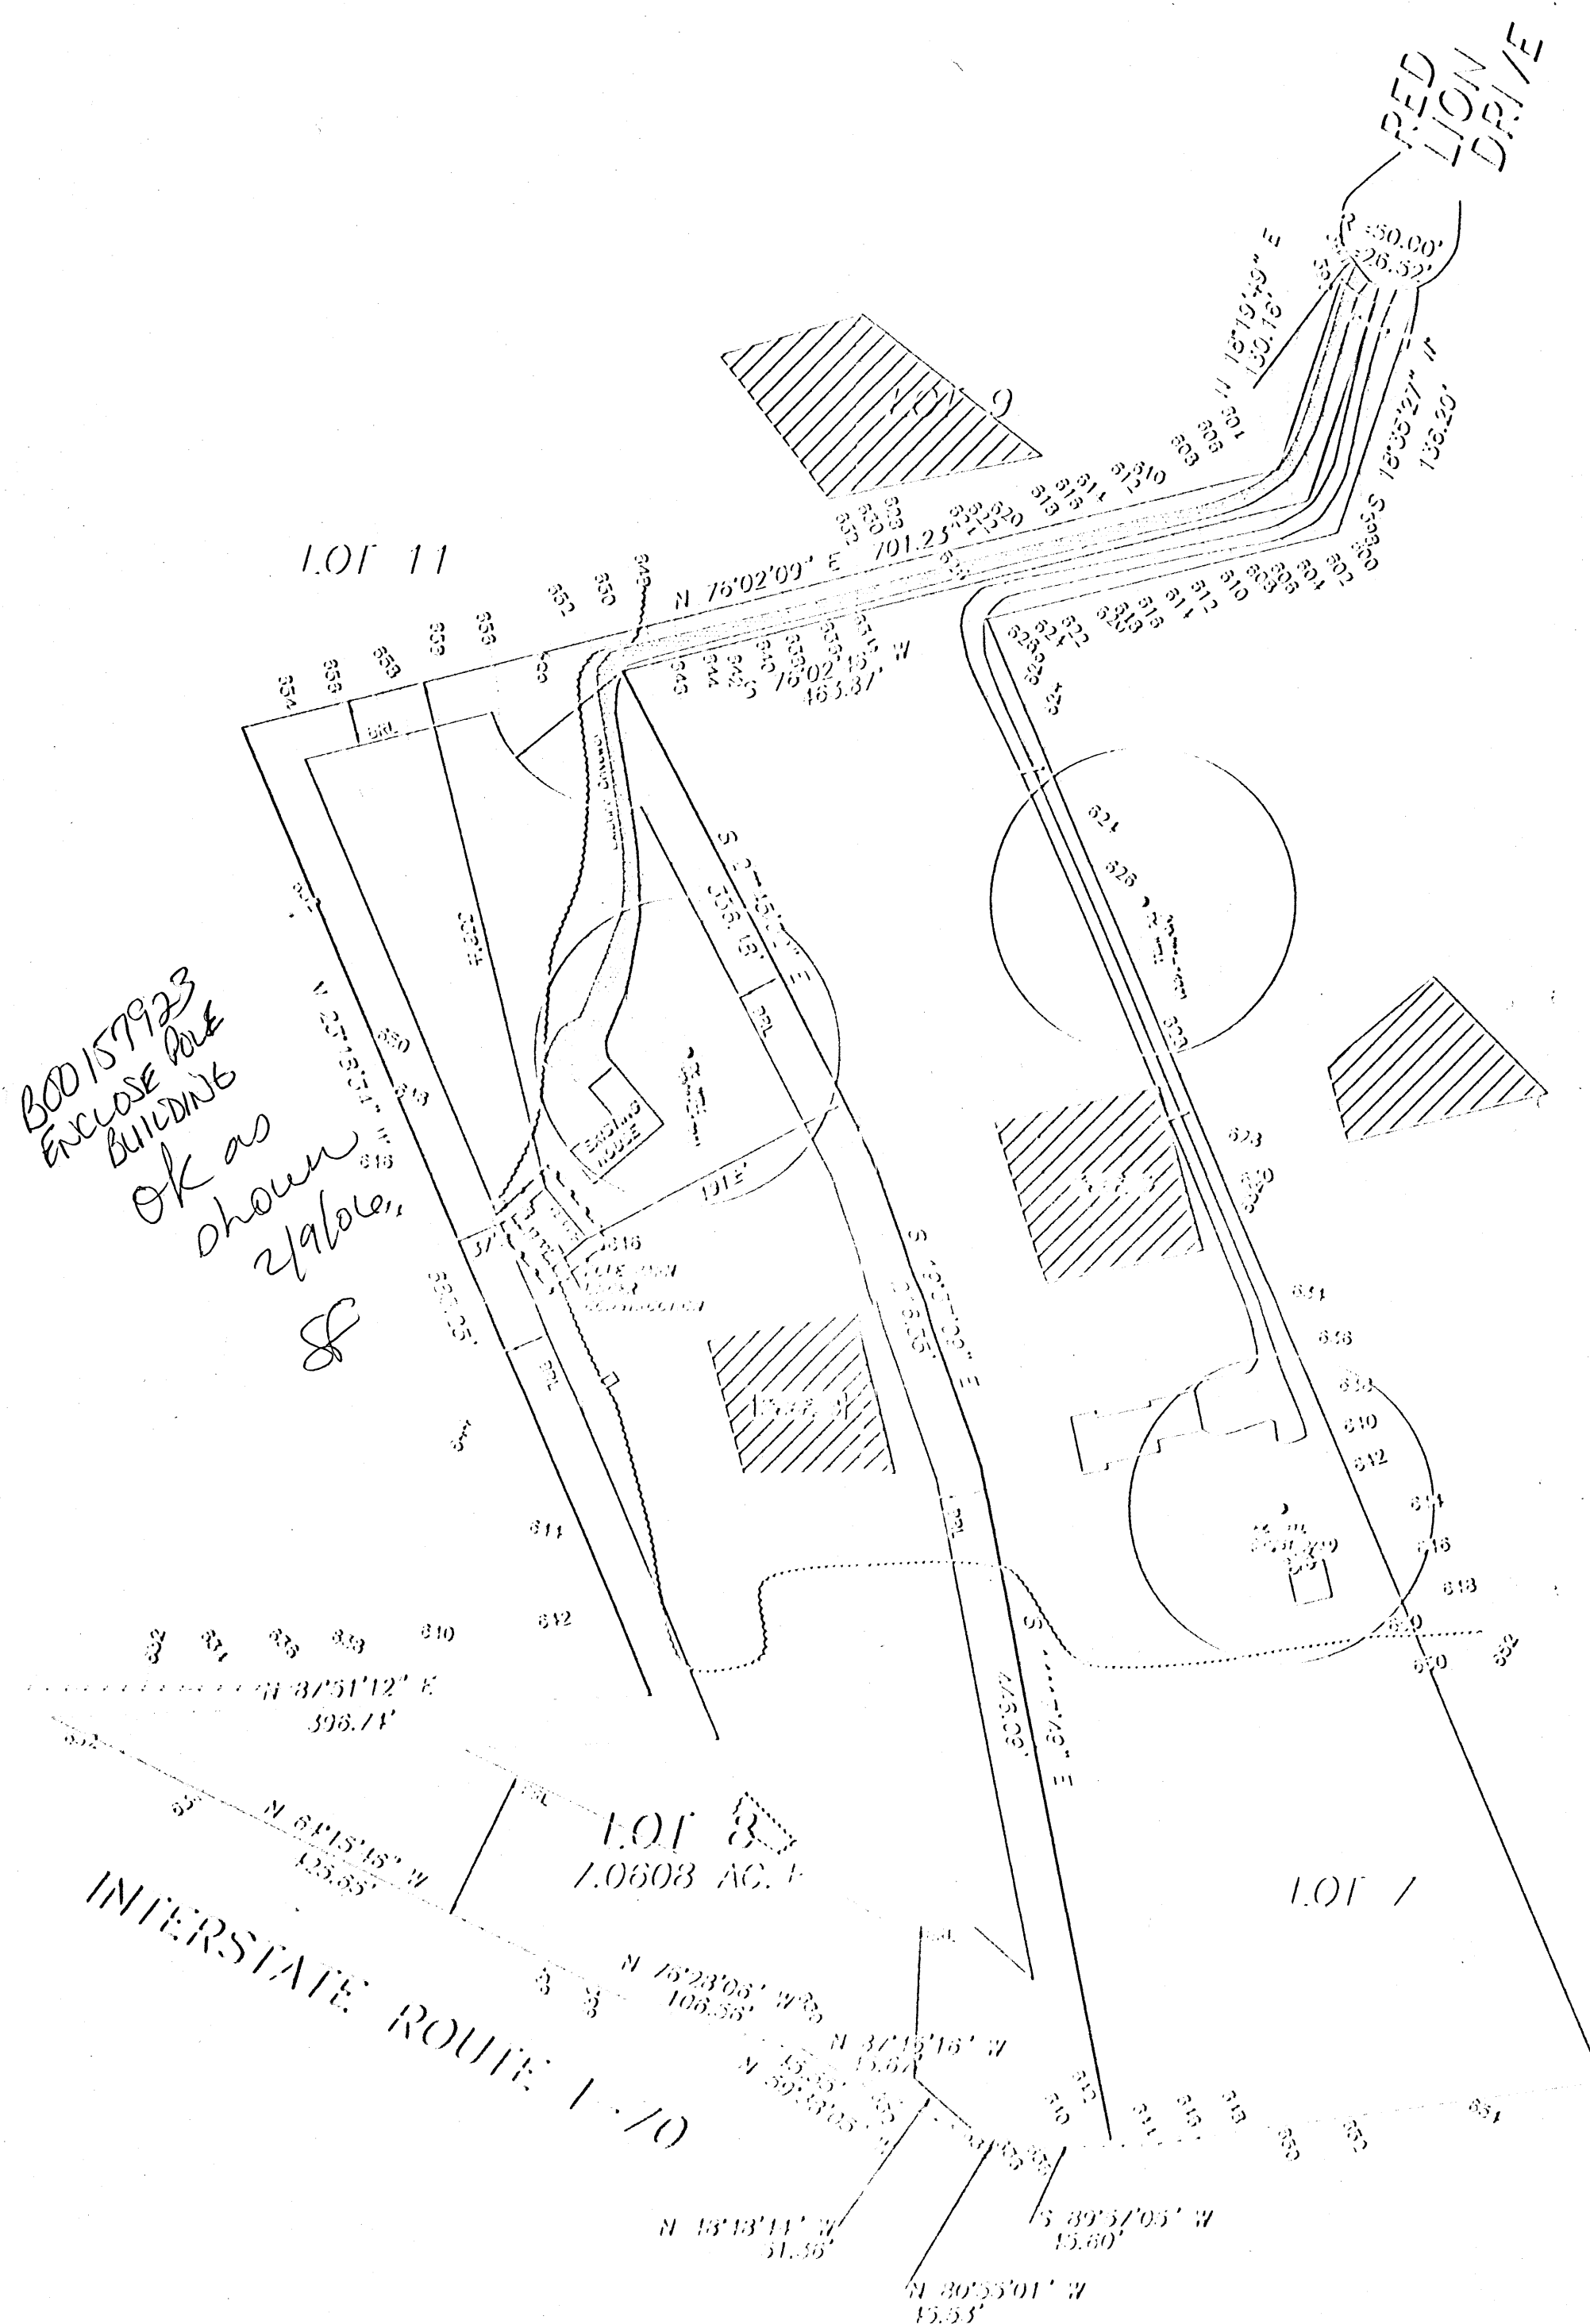

VICINITY MAP
SCALE: 1"=2000'

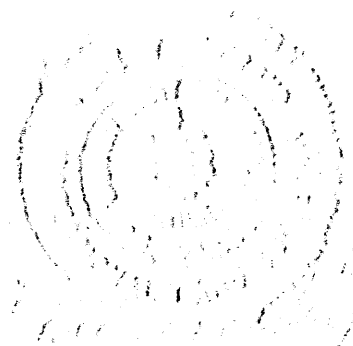

SHANABARGER & LANE
3726 TOWN & COUNTRY BLVD.
SUITE 201
FALLS CHURCH, MD. 21043
PHONE: 703-461-9563
FAX: 703-461-9693

SITE PLAN FOR BUILDING PERMIT APPLICATION

LOT 8

RED LION INN ESTATES

SHEET 2 OF 2, PLAT #5027

4TH ELECTION DIST. HOWARD CO., MD.

SCALE: 1"=100'

JANUARY 24, 2006

