
WATER WELL ABANDONMENT-SEALING REPORT FORM

SUBMIT COPIES OF COMPLETED FORM TO:

- * COUNTY ENVIRONMENT AGENCY (contact MDE, WMA if address needed)
- * WELL OWNER
- * MDE, WATER MANAGEMENT ADMINISTRATION, WELL PROGRAM

DATE WELL ABANDONED: JUNE 30 2009 (month/day/year)

* PERMIT NUMBER OF ABANDONED WELL (if any) N/A

* PERMIT NUMBER OF REPLACEMENT WELL HO - 95 - 1213

* PERSON ABANDONING WELL: RALPH E. MAYNE


WELL DRILLERS LICENSE NUMBER: 117

CIRCLE: MWD MSD MGD

* OWNER'S NAME: Land Marketing Consultants

SITE LOCATION MAP

* WELL LOCATION:
COUNTY: HOWARD
NEAREST TOWN: CLARKSVILLE
TAX MAP 28 BLOCK 18 PARCEL 21
SUBDIVISION: MARILLYN PARK
SECTION: LOT: 1
NEAREST ROAD: SHEPPARD'S LA.
5085 SHEPPARD'S LA.

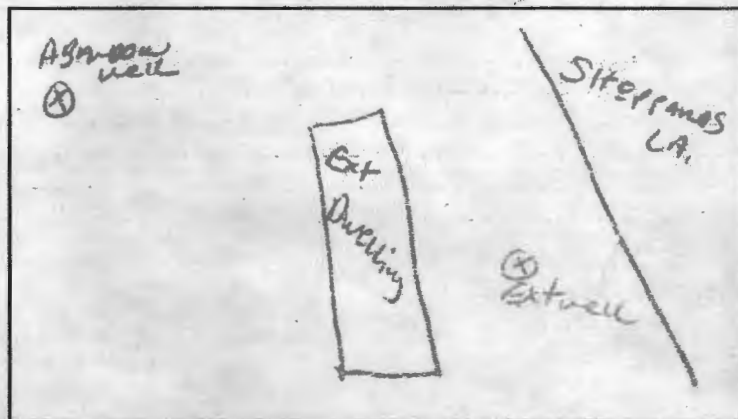

* TYPE OF WELL BEING ABANDONED:

☒ DRILLED ☐ JETTED
☐ BORED/AUGERED ☐ HAND DUG
☐ OTHER (specify) _____

* USE CODE:

☒ DOMESTIC ☐ MUNICIPAL/PUBLIC
☐ IRRIGATION ☐ INDUSTRIAL
☐ TEST/OBSERVATION ☐ GEOTHERMAL

* TYPE OF CASING:

☒ STEEL ☐ PLASTIC
☐ CONCRETE ☐ OTHER (specify) _____

* SIZE OF CASING: 6" INCHES IN DIAMETER

* DEPTH OF WELL: 100 FEET DEEP

* WAS ANY CASING REMOVED? ☐ YES ☒ NO
if yes, length removed, in feet: _____

* WAS CASING RIPPED OR PERFORATED? ☐ YES ☐ NO

LOG OF SEALING MATERIAL

MATERIAL	FEET	
	FROM	TO
Cement	100	9
TOP SOIL	85	0
VOLUME OF MATERIAL USED		
15.84 yds Cement		

SIGNATURE-MASTER WELL DRILLER OR SUPERVISING SANITARIAN Ralph E. Mayne

LICENSE # 117

MWD MSD MGD JUNE 30 2009

CIRCLE ONE

DATE