

Building Permit Application
Howard County Maryland
Department of Inspections, Licenses and Permits
3430 Court House Drive
Permits: 410-313-2455
www.howardcountymd.gov

ate	Received:	
Juic	ricceived.	

Building Address: 14					Property Own	ner's Name	Thomas .	DAGA	10000
City: Chenela	_md Zip Code	e: 21737	Property Owner's Name: Thomas Dana Lawson Address: 14005 Translephin Rd						
Suite/Apt. #	P/WP/BA #		City: herely State: nd Zip Code: 21737						
Census Tract:			C. L. J. L. C.	2011	Phone: Email:			_ Fax:	
Consus Hact:			_ Subdivision: 34	induction it	Linaii.				
Section:		Area	a: Lo	it:2	Applicant's N	ame & Mai	ling Address, (I	f other than	stated herein)
Tax Map: 24		Parcel:_	49 Grid	d: 18	Applicant's Na	ame: Je	ermy (1	anc	
Zoning:					City: Cld	rskur,	State: 0	-d 7	Zip Code: 2478
					Phone: 44	3-348-1	227 Fax:		
Existing Use: 50					Email: Jere	My O	spoked A.	od Appr	oved ion
Proposed Use:SF	0 4	10	mon Tak		Contractor Company: Valley NATIONAL CAS				
Estimated Construction					Contact Person	n: 64/1.	an Gew	- 120 ral	NET
Description of Work:		0 -			Address:	1201	nomevale	9 01	
					City: Jeste	0	State: md	7in Code	74.7911
_ instaus	00	gal	10- 11-grow	ind	City: <u>Jessep</u> <u>State:</u> <u>M.d.</u> Zip Code: 26.794 License No. : <u>C7793</u>				
0000	n	100	اد		Phone: 4/0-	774-111	f Fax:		
Occupant or Tenant:					Email:				
Was tenant space previo				□No	Engineer/Archi	tect Compa	ny:		
Contact Name:					Responsible De				
Address:									
City:	run	W.	tate: Zip Co						
					City:		itate:	_ Zip Code:	
Phone:		F	ax:		Phone:				
Email:					1				
					Email:				
Commercial Building Ch	aracter		Residential Building	Characteristics		Utilities		1507 1977 B	NE PER COMPANY
Height: No. of stories:			☐ SF Dwelling ☐ SF 1		V	Vater Supp	'v	THE COURSE OF THE COURSE	en de la Callera. Pour le company
Gross area, sq. ft./floor:			Depth	Width	☐ Public			Constitution	ly alterial actions.
0.033 area, sq. It./1100r:			1 st floor: 2 nd floor:		Private			P. C. Sandar	
Area of construction (sq.	ft.):				Sewage Disposal			William Service	
			Basement:		□ Public			1 WEST	100 M
Use group:			Unfinished Basement		Private				
			☐ Crawl Space					F-120	TO STATE OF
Construction type:			☐ Slab on Grade		Electric:				
Reinforced Concrete		1	No. of Bedrooms:		Gas: ☐ Yes ☐ No			LECTION OF	A REFER
Structural Steel			Multi-family Dwelling		<u>Heating System</u>			W/4/43	NAME OF STREET
☐ Masonry ☐ Wood Frame			No. of efficiency units:		☐ Electric	□ Oil		WHILE.	
☐ State Certified Modula			No. of 1 BR units:		☐ Natural Gas ☐ Propane Gas				
_ state certified Modula			No. of 2 BR units:		☐ Other:				
			No. of 3 BR units: Other Structure:		Spri	nkler Syster	<u>n:</u>	347#2#Y	
		D	Dimensions:		☐ Yes ☐ No			40.38.15	
> Roadside Tree Projec	t Permi	t F	Footings:						
□Yes ↓ (٠ کلار	R	Roof:			Grading Per	mit Number:	nuther strike	
Roadside Tree Project	Permit #	STATE TO STATE OF	☐ State Certified Modular						
			☐ Manufactured Home		Buildir	Building Shell Permit Number:			
HE UNDERSIGNED HEREBY CERTI VITH ALL REGULATIONS OF HOW	FIES AND	AGREES AS	FOLLOWS: (1) THAT HE/SH	E IS AUTHORIZED TO MA	AKE THIS APPLICATION; (2) THAT THE IN	IFORMATION IS CO.	RRECT: (3) THAT	HE/SHE WILL COMPLY
VITH ALL REGULATIONS OF HOW HIS APPLICATION; (S) THAT HE/S	HE GRANT	SCOUNTY	A ARE APPLICABLE THERETO OFFICIALS THE RIGHT TO FA	D; (4) THAT HE/SHE WILL	PERFORM NO WORK O	N THE ABOVE	REFERENCED PROP	ERTY NOT SPEC	IFICALLY DESCRIBED IN
1	ی	_	7	O THIS PROPER	TED AT	Clans	HE WORK PERMITT	ED AND POSTIN	G NOTICES.
Applicant's Signature			/	Print	Name	- laric	7		
Scene 6	2200	hed A	and Annoved	Lan	9/2	5/12			
Email Address	14		The same	Date	4-	11-			
DUM	T								
Title/Company				_					
			Checks Payable 1	to: DIRECTOR OF FINA	NCE OF HOWARD CO	UNTY		~	
TENNING STATES				PLEASE WRITE NEATLY	A LEGIBLY**	family provided a construction	THE POLICE		
LALE PROPERTY OF THE PARTY OF	1200	的地位	EMPRICA CON	-FOR OFFICE US	SE ONLY.				
AGENCY	DATE	SIGNAT	TURE OF APPROVAL	DPZ SETBACK INF	ORMATION		Filing Fee	\$	E - COLOR MENTAL SERVICES
State Highways				Front:			Permit Fee	\$	
Building Officials				Rear:			Tech Fee	\$	(*)
- Control Control				Side:			Excise Tax	\$	
PSZA (Zoning)				All minimum setb	acks met? Yes	□No	PSFS	\$	
PSZA (Engineering)		^				□No	Guaranty Fun Add'l per Fee		
Health /	2.10	Lpn	north more	Historic District?	□ Yes		Total Fees	\$	

Distribution of Copies: White: Building Officials

Is Sediment Control approval required for issuance? ☐ Yes ☐ No
☐ CONTINGENCY CONSTRUCTION START

Green: PSZA,Zoning

Yellow: PSZA, Engineering

Lot Coverage for New Town Zone:

SDP/Red-line approval date:


Balance Due Pink: Health

Check

Total Fees

Sub-Total Paid

CK# 12071

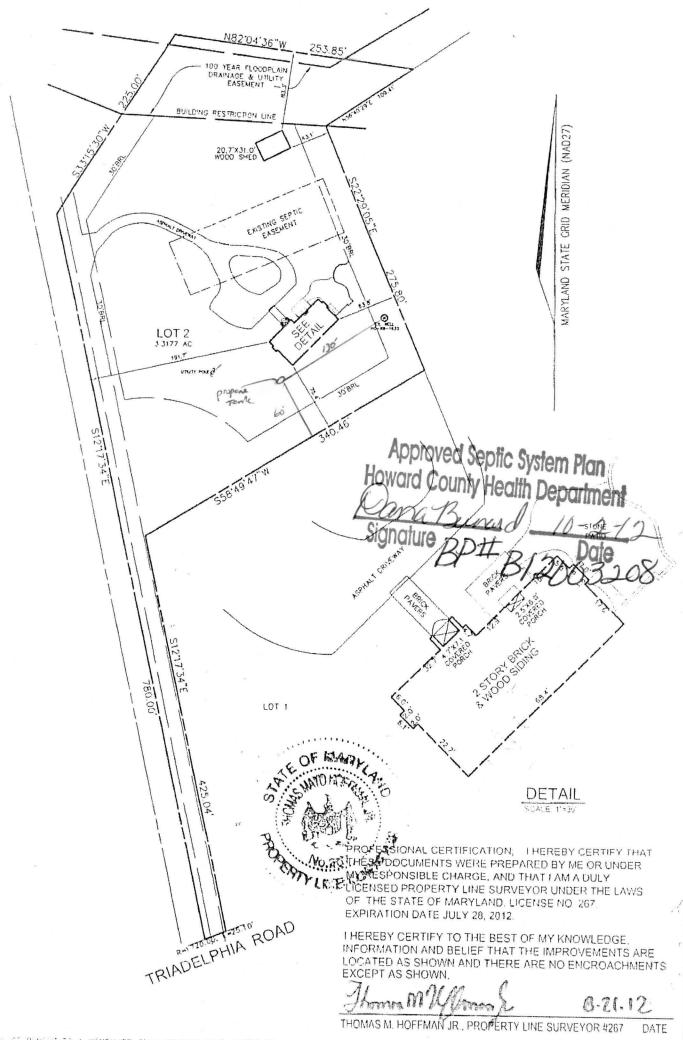

HS FLAT IS OF BENEFIT TO A CONSUMER ONLY INSUFAR AS IT IS REQUIRED BY THE LENDER OF THE HASHBANCE COMPANY OF ITS. AGENT IN CONTIECTED WITH INTERPOLATED DEMISTER, FINANCING OR REFINANCING, THIS PLAT IS NOT TO BE FELLED UPON FOR THE ESTABLISHMENT OF LOCATION OF FENCES, DARAGES, DULLDWIDS TOURIST IMPROVEMENTS, THE CHAIT POES NOT PROVIDE THE ACCURATE IDENTIFICATION OF PROPERTY BOUNDARY LINES, BUT SUCH DENTIFICATION MAY NOT BE CORRED FOR THE IDAMSFER OF THE OR SECURING FINANCING OF REFINANCING, THIS PLAT CONTAINS A TOLERANCE OF ACCURACY OF Q.2 MOPE OF LESS.

1"= 100'	08/20/2012
3.D.A.	CHECKED BY T.M.H.
J GOVER 3006	JOB NUMBER 12-49.00

ROBERT H. VOGEL ENGINEERING, INC. ENGINEERS - SURVEYORS - PLANNERS

8407 MAIN STREET ELLICOTT CITY, MARYLAND 21043

TEL:410-461-7666 FAX:410-461-8961

FINAL LOCATION DRAWING
14008 TRIADELPHIA ROAD
LOT 2
SADDLEBROOK
PLAT NO. 8006
FORTH ELECTION DISTRICT
HOWARD COUNTY, MARYLAND