



# Building Permit Application

Howard County Maryland  
Department of Inspections, Licenses and Permits  
3430 Court House Drive  
Permits: 410-313-2455  
www.howardcountymd.gov

Date Received: 02/21/13

Permit No.: B13000604

Building Address: 11910 Farside Rd

City: Ellicott City State: MD Zip Code: 21042

Suite/Apt. # \_\_\_\_\_ SOP/WP/BA #: \_\_\_\_\_

Census Tract: \_\_\_\_\_ Subdivision: \_\_\_\_\_

Section: \_\_\_\_\_ Area: \_\_\_\_\_ Lot: \_\_\_\_\_

Tax Map: \_\_\_\_\_ Parcel: \_\_\_\_\_ Grid: \_\_\_\_\_

Zoning: \_\_\_\_\_ Map Coordinates: \_\_\_\_\_ Lot Size: \_\_\_\_\_

Existing Use: HOUSE Single Family Dwelling

Proposed Use: Generator

Estimated Construction Cost: \$ 4,000

Description of Work: Install 50gal UG tank  
And Run 50' of 1/2" copper to  
Generator.

Occupant or Tenant: \_\_\_\_\_

Was tenant space previously occupied? ☐ Yes ☐ No

Contact Name: \_\_\_\_\_

Address: \_\_\_\_\_

City: \_\_\_\_\_ State: \_\_\_\_\_ Zip Code: \_\_\_\_\_

Phone: \_\_\_\_\_ Fax: \_\_\_\_\_

Email: \_\_\_\_\_

Commercial Building Characteristics

Height: \_\_\_\_\_

No. of stories: \_\_\_\_\_

Gross area, sq. ft./floor: \_\_\_\_\_

Area of construction (sq. ft.): \_\_\_\_\_

Use group: \_\_\_\_\_

Construction type:

☐ Reinforced Concrete

☐ Structural Steel

☐ Masonry

☐ Wood Frame

☐ State Certified Modular

\_\_\_\_\_

\_\_\_\_\_

Property Owner's Name: Floyd Maluene

Address: 11910 Farside Rd

City: Ellicott State: MD Zip Code: 21042

Phone: 301-596-5006 Fax: \_\_\_\_\_

Email: \_\_\_\_\_

Applicant's Name & Mailing Address, (If other than stated herein)

Applicant's Name: \_\_\_\_\_

Address: \_\_\_\_\_

City: \_\_\_\_\_ State: \_\_\_\_\_ Zip Code: \_\_\_\_\_

Phone: \_\_\_\_\_ Fax: \_\_\_\_\_

Email: \_\_\_\_\_

Contractor Company: J & R Plumbing & Heating

Contact Person: Chris Basciano

Address: 502 Carrick Lane

City: Severn State: MD Zip Code: 21144

License No.: 2002-0001365

Phone: 410-987-1084 Fax: 410-761-4202

Email: ChrisBasciano@MSN.com

Engineer/Architect Company: \_\_\_\_\_

Responsible Design Prof.: \_\_\_\_\_

Address: \_\_\_\_\_

City: \_\_\_\_\_ State: \_\_\_\_\_ Zip Code: \_\_\_\_\_

Phone: \_\_\_\_\_ Fax: \_\_\_\_\_

Email: \_\_\_\_\_

Utilities

Water Supply

☐ Public

☒ Private

Sewage Disposal

☐ Public

☒ Private

Electric: ☐ Yes ☐ No

Gas: ☐ Yes ☐ No

Heating System

☐ Electric ☐ Oil

☐ Natural Gas ☐ Propane Gas

☐ Other: \_\_\_\_\_

Sprinkler System:

☐ Yes ☐ No

Grading Permit Number: \_\_\_\_\_

Building Shell Permit Number: \_\_\_\_\_

THE UNDERSIGNED HEREBY CERTIFIES AND AGREES AS FOLLOWS: (1) THAT HE/SHE IS AUTHORIZED TO MAKE THIS APPLICATION; (2) THAT THE INFORMATION IS CORRECT; (3) THAT HE/SHE WILL COMPLY WITH ALL REGULATIONS OF HOWARD COUNTY WHICH ARE APPLICABLE THERETO; (4) THAT HE/SHE WILL PERFORM NO WORK ON THE ABOVE REFERENCED PROPERTY NOT SPECIFICALLY DESCRIBED IN THIS APPLICATION; (5) THAT HE/SHE GRANTS COUNTY OFFICIALS THE RIGHT TO ENTER ONTO THIS PROPERTY FOR THE PURPOSE OF INSPECTING THE WORK PERMITTED AND POSTING NOTICES.

\_\_\_\_\_

\_\_\_\_\_


\_\_\_\_\_

Distribution of Copies: White: Building Officials Green: PSZA, Zoning Yellow: PSZA, Engineering Pink: Health Gold: SHA

T:\Operations\Updated Forms\Building applmp 8.2012.docx

\_\_\_\_\_

\_\_\_\_\_

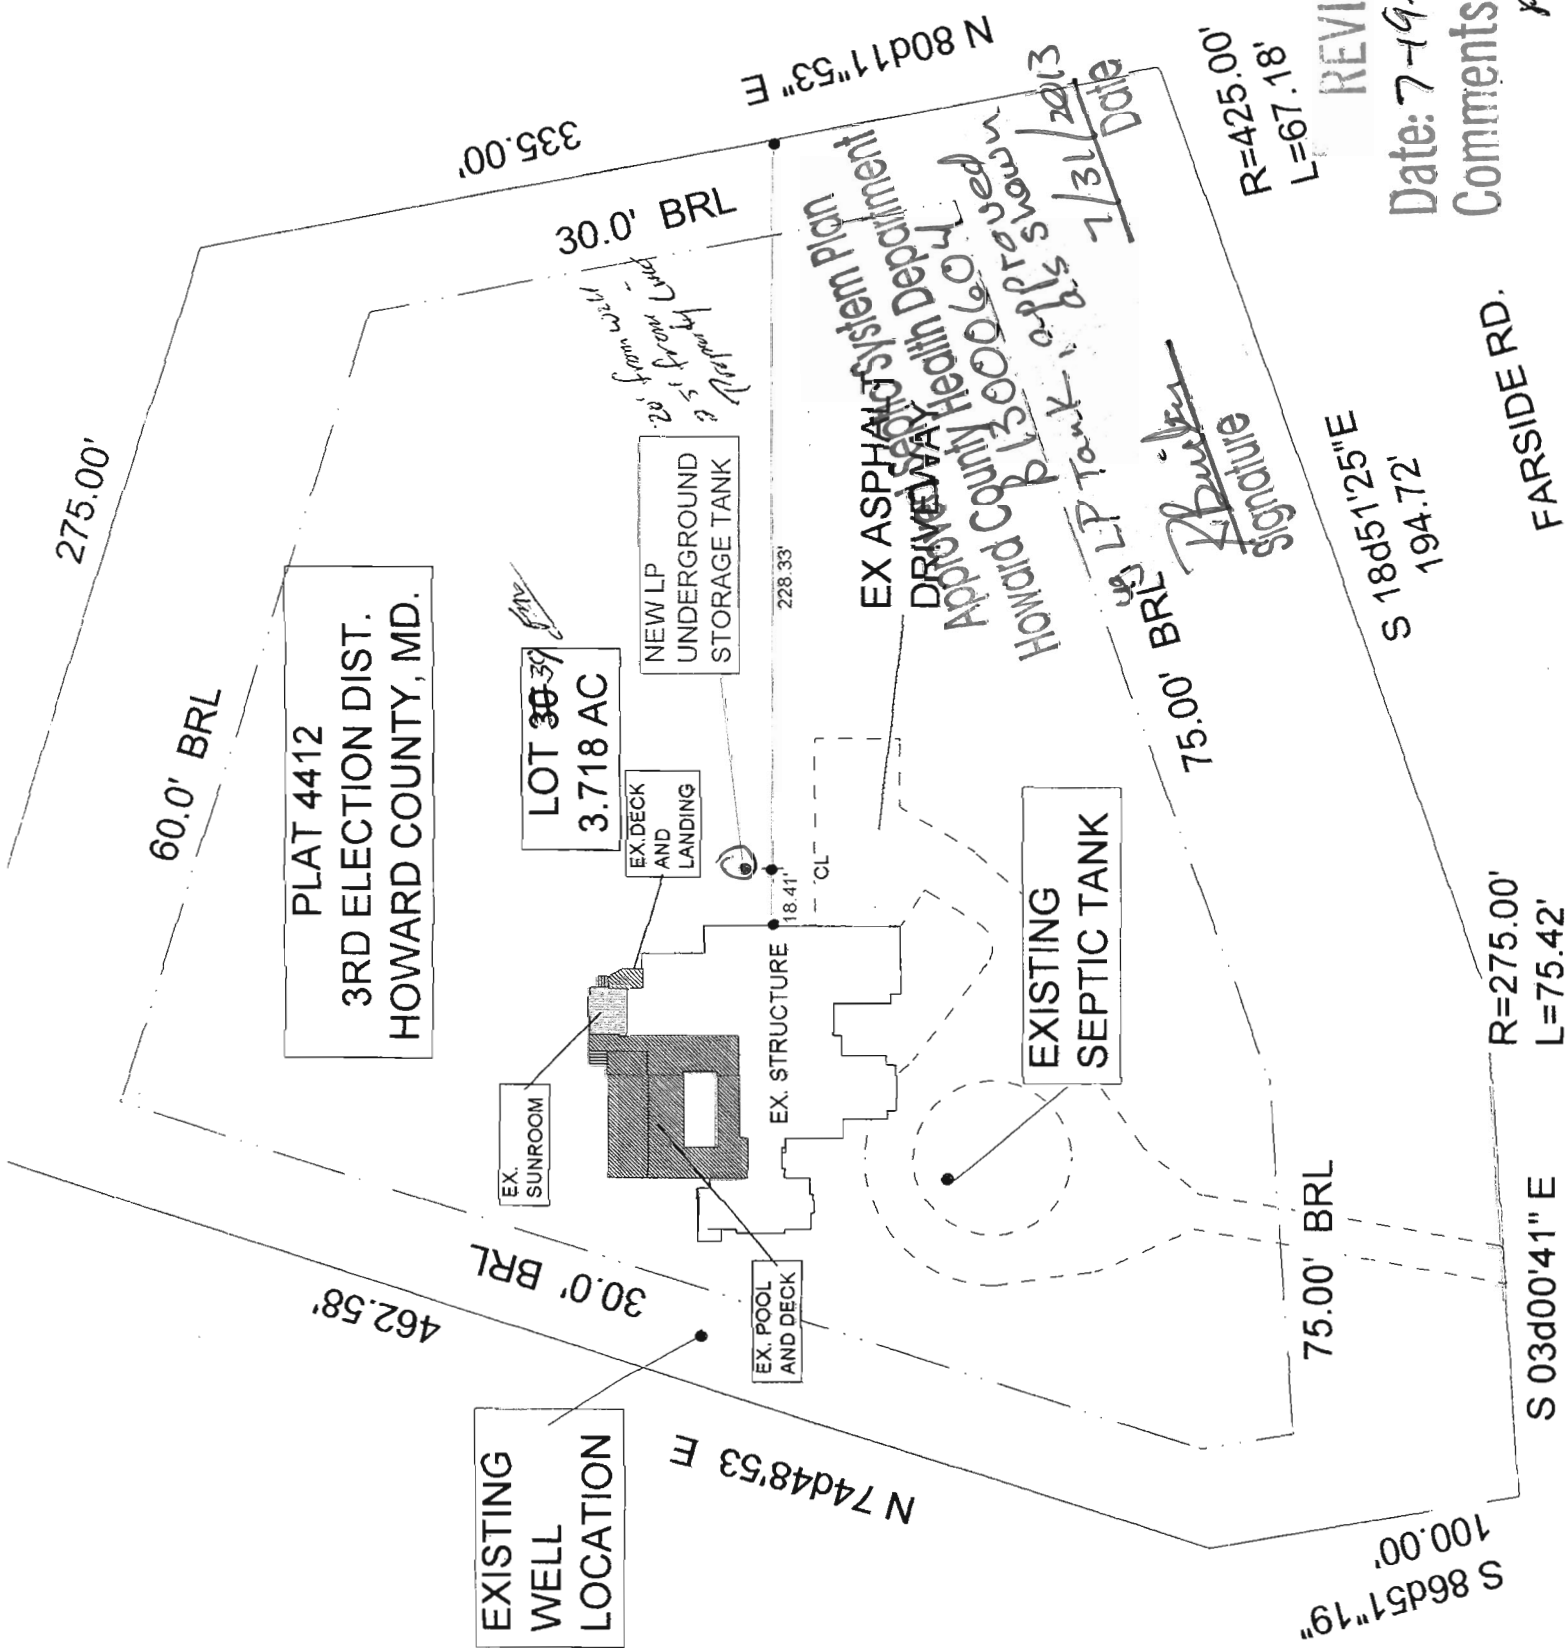

REVISED

Date: 7-19-13

Comments: new plot plan