



Building Permit Application

Howard County Maryland
Department of Inspections, Licenses and Permits
3430 Court House Drive
Permits: 410-313-2455
www.howardcountymd.gov

Date Received: _____

Permit No.: B11000574

Building Address: 3725 Shady Lane
City: Glenwood State: MD Zip Code: 21732
Suite/Apt. # _____ SDP/WP/BA #: _____
Subdivision: _____
Lot: 7 Tax Map: _____ Parcel: _____
Existing Use: SF
Proposed Use: Building
Estimated Construction Cost: \$ 568400
Description of Work: Install electrical supply 500gallon
underground tank for house
Occupant/Tenant Name: _____
Was tenant space previously occupied? ☐ Yes ☒ No
Contact Name: _____
Address: _____
City: _____ State: _____ Zip Code: _____
Phone: _____ Fax: _____
Email: _____

Property Owner's Name: Robert Sharp
Address: 3725 Shady Lane
City: Glenwood State: MD Zip Code: 21732
Phone: _____ Fax: _____
Email: _____
Applicant's Name & Mailing Address, (if other than stated herein)
Applicant's Name: _____
Address: _____
City: _____ State: _____ Zip Code: _____
Phone: _____ Fax: _____
Email: _____
Contractor Company: Thompson Co
Contact Person: Timothy Thompson
Address: 6702 Old National Pike
City: Bowie State: MD Zip Code: 21713
License No.: 60003
Phone: 301 432 6447 Fax: _____
Email: thompson@thompsonco.com
Engineer/Architect Company: _____
Responsible Design Prof.: _____
Address: _____
City: _____ State: _____ Zip Code: _____
Phone: _____ Fax: _____
Email: _____

Commercial Building Characteristics	Residential Building Characteristics
Height:	☐ SF Dwelling ☐ SF Townhouse
No. of stories:	Depth Width
Gross area, sq. ft./floor:	1 st floor:
Area of construction (sq. ft.):	2 nd floor:
Use group:	Basement:
	☐ Finished Basement
	☐ Unfinished Basement
	☐ Crawl Space
Construction type:	☐ Slab on Grade
☐ Reinforced Concrete	No. of Bedrooms:
☐ Structural Steel	Multi-family Dwelling
☐ Masonry	No. of efficiency units:
☐ Wood Frame	No. of 1 BR units:
☐ State Certified Modular	No. of 2 BR units:
	No. of 3 BR units:
	Other Structure:
	Dimensions:
	Footings:
	Roof:
	☐ State Certified Modular
	☐ Manufactured Home

Utilities
Electric: ☐ Yes ☐ No
Gas: ☒ Yes ☐ No
Water Supply
☐ Public
☐ Private
Sewage Disposal
☐ Public
☒ Private
Heating System
☐ Electric ☐ Oil
☐ Natural Gas ☒ Propane Gas
☐ Other:
Sprinkler System:
☐ Yes ☒ No
Grading Permit Number:
Building Shell Permit Number: <u>1001557069</u>

THE UNDERSIGNED HEREBY CERTIFIES AND AGREES AS FOLLOWS: (1) THAT HE/SHE IS AUTHORIZED TO MAKE THIS APPLICATION; (2) THAT THE INFORMATION IS CORRECT; (3) THAT HE/SHE WILL COMPLY WITH ALL REGULATIONS OF HOWARD COUNTY WHICH ARE APPLICABLE THERETO; (4) THAT HE/SHE WILL PERFORM NO WORK ON THE ABOVE REFERENCED PROPERTY NOT SPECIFICALLY DESCRIBED IN THIS APPLICATION; (5) THAT HE/SHE GRANTS COUNTY OFFICIALS THE RIGHT TO ENTER ONTO THIS PROPERTY FOR THE PURPOSE OF INSPECTING THE WORK PERMITTED AND POSTING NOTICES.

Applicant's Signature: [Signature] Print Name: Robert Sharp
Email Address: Robert@thompsonco.com Date: March 6, 2017
Title/Company: _____

Checks Payable to: DIRECTOR OF FINANCE OF HOWARD COUNTY
PLEASE WRITE NEATLY & LEGIBLY
-FOR OFFICE USE ONLY-


AGENCY	DATE	SIGNATURE OF APPROVAL
State Highways		
Building Officials		
PSZA (Zoning)		
PSZA (Engineering)		
Health	<u>3/8/17</u>	<u>[Signature]</u>

Is Sediment Control approval required for issuance? ☐ Yes ☒ No
☐ CONTINGENCY CONSTRUCTION START


DPZ SETBACK INFORMATION
Front:
Rear:
Side:
Side St.:
All minimum setbacks met? ☐ Yes ☐ No
Is Entrance Permit Required? ☐ Yes ☐ No
Historic District? ☐ Yes ☐ No
Lot Coverage for New Town Zone:
SDP/Red-line approval date:

Filing Fee	\$
Permit Fee	\$
Tech Fee	\$
Excise Tax	\$
PSFS	\$
Guaranty Fund	\$
Add'l per Fee	\$
Total Fees	\$
Sub- Total Paid	\$
Balance Due	\$
Check	#

COUNTY REGULATIONS MAY REQUIRE
SEPARATE AND DISTINCT DOOR ALARMS
ON ANY DOOR OPENING INTO THE POOL AREA

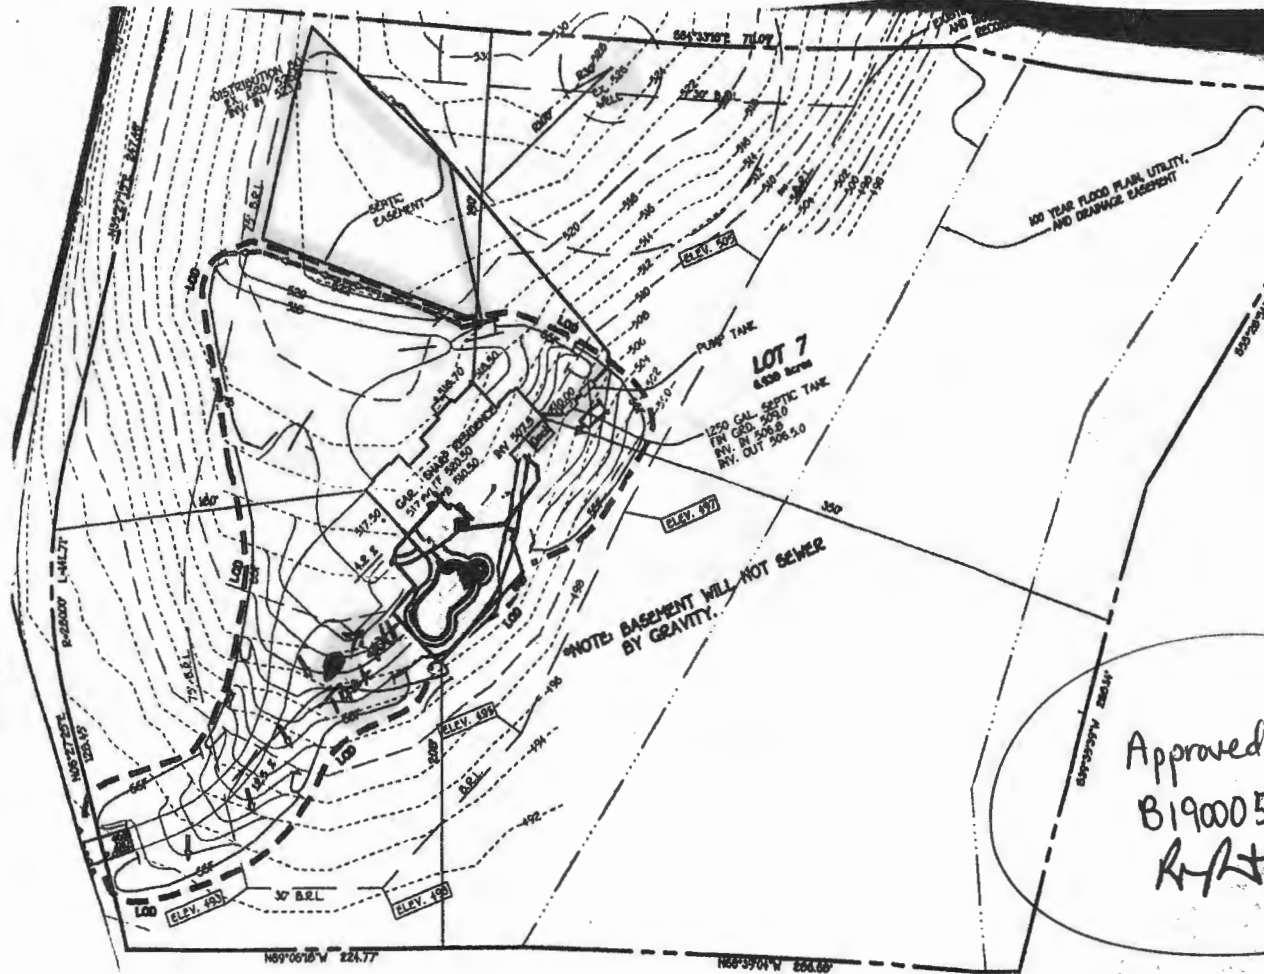

Survey Plan
NOT TO SCALE

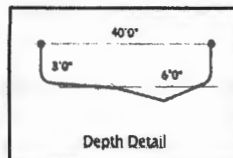

ANTHONY SYLVAN POOLS
It's Where America Rides™
© 2008 ANTHONY & SYLVAN POOLS CORP.

NOTE		NOTE:		REVISIONS	
Changes from the agreement are by addendum only, signed by both parties and paid in full at time of affixing signature. No changes will occur prior to signing addendum.		To be numbered and referred to on Plan via Symbol		Date	Description
		T.O.C. = ?		10-24-18	CONSTRUCTION DRAWING BY JRL

SHARP		JOB NO: 1803110166	
CUSTOMER INFORMATION			
LAST NAME:	SHARP	HOME PHONE:	410-489-6224
FIRST NAME:	BOB AND ANN	CELL PHONE:	A 443-812-9180 B 301-766-3706
ADDRESS:	3725 SHADY LANE	POOL/SPA TYPE:	Concrete Pool
CITY:	Greenwood	STATE:	MD
ZIP:	21778	COUNTY:	Howard
SUBDIVISION:	WDC	DAY TELE DESCR:	
EMAIL ADDRESS:	ANN@SHARPUS16@GMAIL.COM B@ROBERTSHARP702@GMAIL.COM		

Map



Directions

DIRECTIONS

HOWARD COUNTY
MAP PG NA GRID NA

CROSS STREET: WINDRICH

Approved for UPT
B19000574
R/R 3/18/19

SITE CONDITIONS		
ADJ. EXC. GRADING:	0	HIS WATER SOURCE:
DRY TYPE:	Standard	SEWER or SEPTIC:
DIRT HALL:	YES	SEPTIC:
FENCE REMOVAL:	0	DRAIN REQ'D / TYPE:
SLAB REMOVAL:	0	LAWN SPRINKLERS:
POWER LINES:	0	TEMP FENCE:
STUMP REMOVAL QTY:	0	BILT FENCE:
* No Stumps		
POOL SETBACKS		
REAR:	10	FT. EQUIPMENT:
SIDES:	10	FT. FENCE:
HOUSE:		FT. OTHER SETBACKS:

ANTHONY & SYLVAN CONTACT INFORMATION			
DESIGNER:	Mike Duffy	CELL PHONE NO:	(443) 994-3358
AKS OFFICE:	ServeMap@a367	OFFICE PHONE NO:	1 877 Say Seem est 8730
ADDRESS:	SAC: Glen Filche Hwy Secoma Park, MD 21146		
REGIONAL MANAGER:	Rolf Hyden	PERMIT OFFICE:	HOWARD
SHOW DATE:	10/22/2018	PERMIT OFFICE TEL:	
PM:	Diddy Ilean	PM CELL PHONE NO:	443 936 8109