

Search Result for HOWARD COUNTY

<https://sdat.dat.maryland.gov/RealProperty/Pages/viewdetails.aspx?County=14&SearchTyp...> 6/7/2019

10.30. 7-25-69
Preliminary

APPLICATION

SEWAGE DISPOSAL TESTING

A 14664

P _____

MARYLAND STATE DEPARTMENT OF HEALTH

HOWARD COUNTY

ELLICOTT CITY

DISTRICT 4

DATE 7/22/69

Septic Pond - 75 gal.

100'
dry well - 36" soft absorbent side with area below solid pipe. Intended
4' below orig. grade. No depth permitted for dry well is 10' below orig. grade.

Place dry well about 155' from rear lot line and about 68' from
right side line as seen when facing from front lot

TO: THE COUNTY HEALTH OFFICER
ELLICOTT CITY, MARYLAND

I, HEREBY, APPLY FOR THE NECESSARY TESTS IN ORDER TO CONSTRUCT (OR RECONSTRUCT) A SEWAGE DISPOSAL SYSTEM.

PROPERTY OWNER Walter V. Mathis and May E. Mathis

ADDRESS Fowler Heights, Mt. Airy, Md. PHONE _____

PROPERTY LOCATION:

SUBDIVISION _____ LOT NO. _____

ROAD AND DESCRIPTION St. Michael's Rd. off Rt. 144 - approx. 1/4 mile - first lane
turning right - (go past uninhabited
house the next more house then lane)
can easily be missed.

OCCUPANT _____ PHONE _____

PERSON TO CONSTRUCT SYSTEM _____

ADDRESS _____ PHONE _____

SIZE OF LOT 1 acre TYPE BLDG. 2

NUMBER OF BEDROOMS

IF NOT SINGLE RESIDENCE DESCRIBE Single Family Dwelling

SIGNATURE OF APPLICANT Jess C. Wilber

APPROVED BY DW. [Signature] FOR dry well DATE 7/25/69

(KIND OF SYSTEM)

REJECTED BY _____ FOR _____ DATE _____

(KIND OF SYSTEM)

HOLD PENDING FURTHER TESTS _____ DATE _____

REASONS FOR REJECTION OR HOLDING _____

THIS IS NOT A PERMIT

APPLICATION

SEWAGE DISPOSAL TESTING

MARYLAND STATE DEPARTMENT OF HEALTH

HOWARD COUNTY

A 14664

P _____

ELLICOTT CITY

DISTRICT 4

DATE 7/22/69

TO: THE COUNTY HEALTH OFFICER
ELLICOTT CITY, MARYLAND

I, HEREBY, APPLY FOR THE NECESSARY TESTS IN ORDER TO CONSTRUCT (OR RECONSTRUCT) A SEWAGE DISPOSAL SYSTEM.

PROPERTY OWNER Walter V. Mathis and May B. Mathis

ADDRESS Poplar Heights, Mt. Airy, Md. PHONE _____

PROPERTY LOCATION:

SUBDIVISION _____ LOT NO. _____

ROAD AND DESCRIPTION St. Michael's Rd. off Rt. 144 - approx. 1/2 mile - first lane turning right - (go past uninhabited house the one more house then lane) can easily be missed.

OCCUPANT _____ PHONE _____

PERSON TO CONSTRUCT SYSTEM _____

ADDRESS _____ PHONE _____

SIZE OF LOT 1 acre TYPE BLDG. 2

NUMBER OF BEDROOMS

IF NOT SINGLE RESIDENCE DESCRIBE Single Family Dwelling

SIGNATURE OF APPLICANT Jess C. Wilder

APPROVED BY [Signature] FOR [Signature] DATE 7/23/69

(KIND OF SYSTEM)


REJECTED BY _____ FOR _____ DATE _____

(KIND OF SYSTEM)

HOLD PENDING FURTHER TESTS _____ DATE _____

REASONS FOR REJECTION OR HOLDING _____

THIS IS NOT A PERMIT

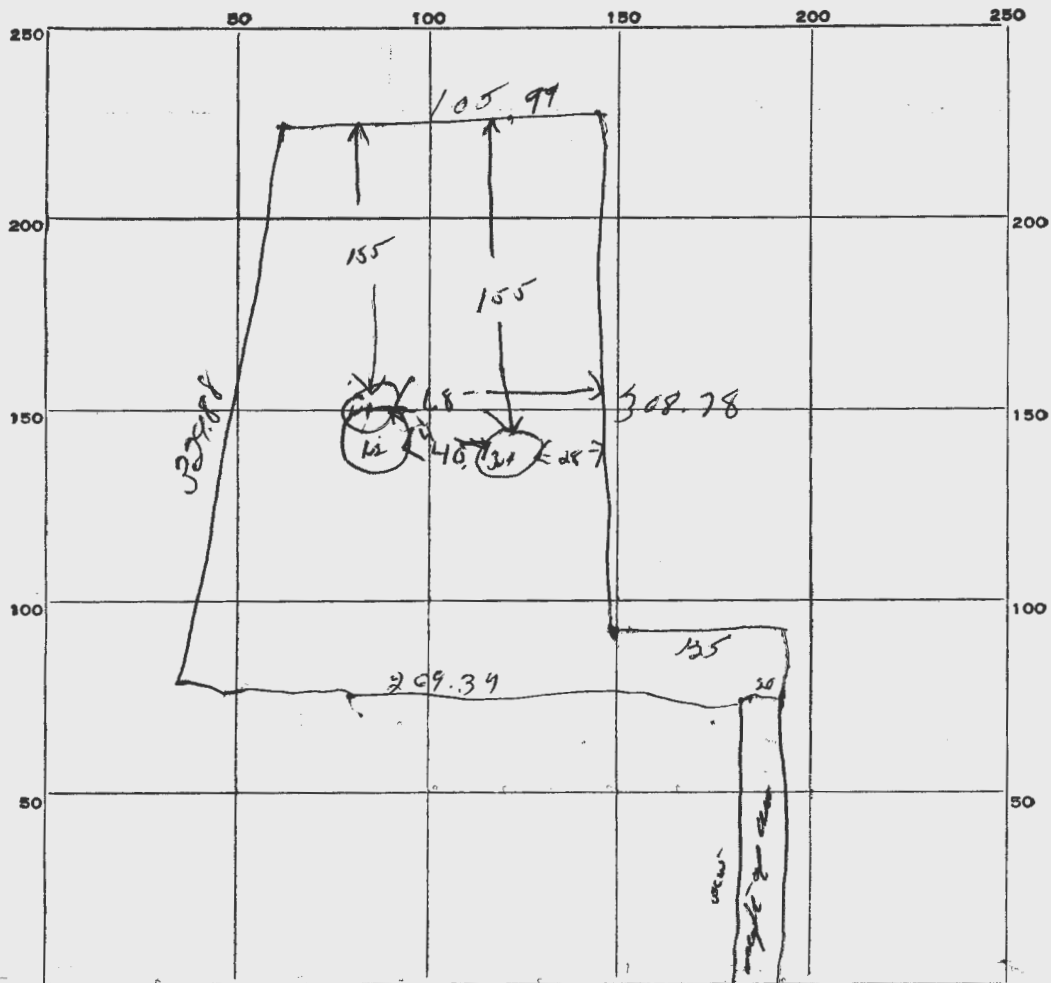


St Michael R,

[illegible]

SOIL AUGER FINDING.

TESTED BY.

REMARKS.

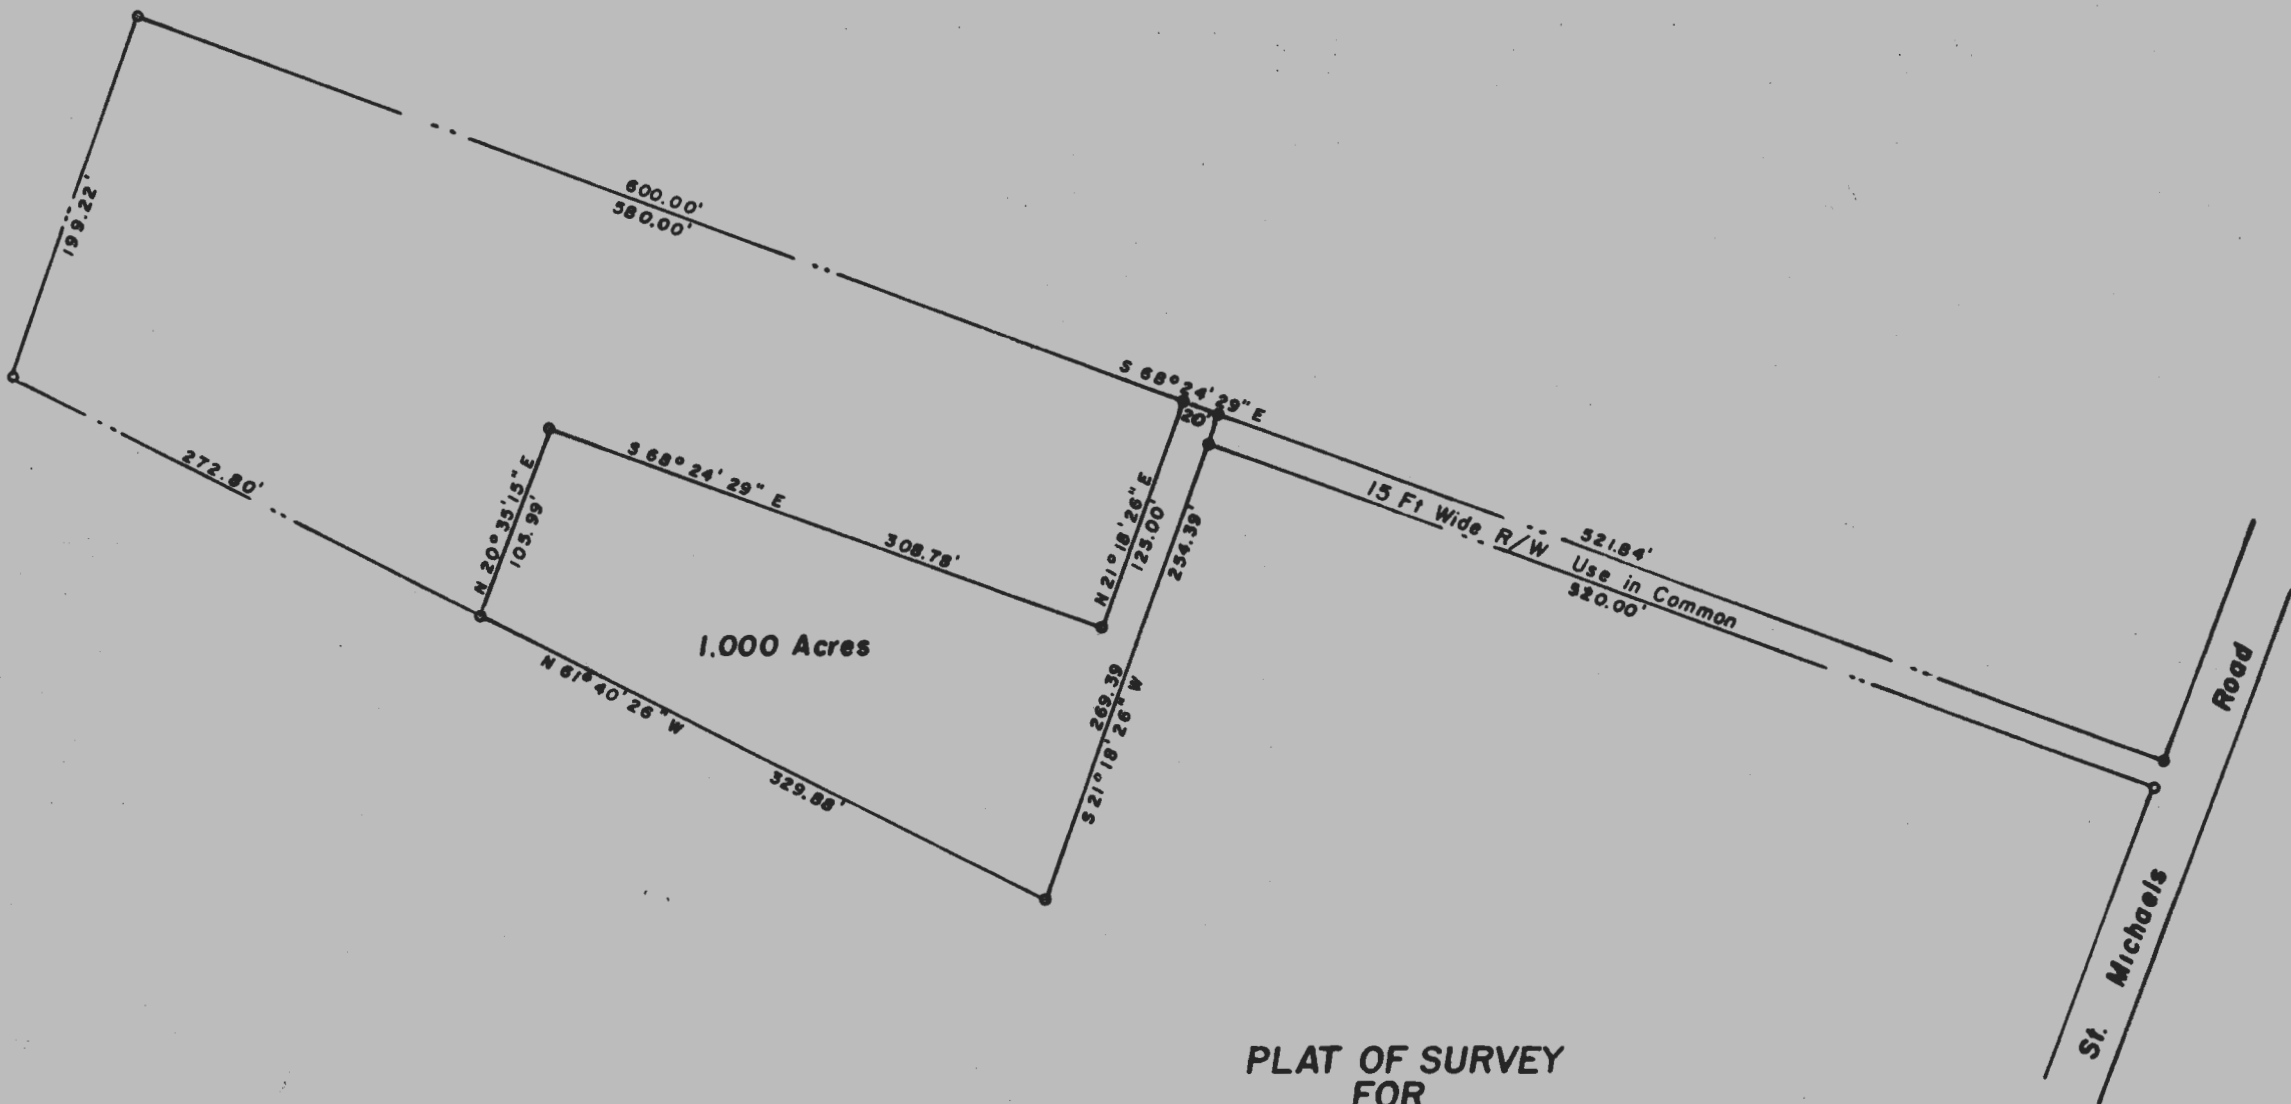

PLAT OF SURVEY
FOR
JESS C. WILDER
FOURTH ELECTION DISTRICT OF HOWARD COUNTY
POPLAR SPRING, MARYLAND
SCALE: 1 IN. = 100 FT. JULY 10, 1969

Claude M. Skinner Jr.
Claude M. Skinner Jr. Reg. Engineer & Land Surveyor No. 2237

