

Real Property Data Search (w1)

Search Result for HOWARD COUNTY

View Map		View GroundRent Redemption		View GroundRent Registration	
Tax Exempt:		Special Tax Recapture:			
Exempt Class:		NONE			
Account Identifier:		District - 05 Account Number - 344263			
Owner Information					
Owner Name:		SHIELDS ERIC ROBERT SHIELDS LORETTA HENRIKSEN WF		Use: RESIDENTIAL Principal Residence: NO	
Mailing Address:		4580 TEN OAKS RD DAYTON MD 21036-1129		Deed Reference: /01418/ 00064	
Location & Structure Information					
Premises Address:		4570 TEN OAKS RD DAYTON 21036-0000		Legal Description: LOT 10 5.024 ACRES 4570 TEN OAKS RD DAYTON	
Map:	Grid:	Parcel:	Sub District:	Subdivision:	Section: Block: Lot:
0028	0002	0219		0000	
Assessment Year:		Plat No:			
2017		Plat Ref:			
Special Tax Areas:		Town:		NONE	
		Ad Valorem:		100	
		Tax Class:			
Primary Structure Built	Above Grade Living Area	Finished Basement Area	Property Land Area	County Use	
			5.0200 AC		
Stories	Basement	Type	Exterior	Full/Half Bath	Garage
Last Major Renovation					
Value Information					
Base Value		Value		Phase-in Assessments	
		As of		As of	
		01/01/2017		07/01/2018	
				As of	
				07/01/2019	
Land:	272,600	272,600			
Improvements	0	0			
Total:	272,600	272,600		272,600	272,600
Preferential Land:	0				0
Transfer Information					
Seller: BROWN ALLEN M & WF		Date: 12/16/1985		Price: \$50,000	
Type: ARMS LENGTH IMPROVED		Deed1: /01418/ 00064		Deed2:	
Seller:		Date:		Price:	
Type:		Deed1:		Deed2:	
Seller:		Date:		Price:	
Type:		Deed1:		Deed2:	
Exemption Information					
Partial Exempt Assessments:	Class	07/01/2018		07/01/2019	
County:	000	0.00			
State:	000	0.00			
Municipal:	000	0.00 0.00		0.00 0.00	
Tax Exempt:		Special Tax Recapture:			
Exempt Class:		NONE			
Homestead Application Information					

APPLICATION

A 18635

P _____

SEWAGE DISPOSAL TESTING

STATE OF MARYLAND - DEPARTMENT OF HEALTH AND MENTAL HYGIENE

HOWARD COUNTY HEALTH DEPARTMENT 3 hr → 1000 gal ST DISTRICT 5
ENVIRONMENTAL HEALTH SERVICES 4 hr → 1250 gal ST DATE 6/29/73P. O. BOX 476, ELLICOTT CITY, MARYLAND 21043
TELEPHONE: 465-5000, EXT. 356

Dry well is to have 110 sq. ft effective absorbent sidewall area per bedroom below the first 5 1/2 ft of non-absorbent ground at original grade. Inlet may be 3-4 ft below grade. Maximum depth of DW to be 13 ft. Locate dry well 100 ft from left side line and 180 ft from front lot line as seen when facing lot from Ten Oaks Rd.

TO: THE COUNTY HEALTH OFFICER
ELLICOTT CITY, MARYLAND

I, HEREBY, APPLY FOR THE NECESSARY TEST IN ORDER TO CONSTRUCT (OR RECONSTRUCT) A SEWAGE DISPOSAL SYSTEM.

PROPERTY OWNER Allen M. BrownADDRESS Linthicum Road, Dayton, Md PHONE 286-2658

PROPERTY LOCATION:

SUBDIVISION _____ LOT NO. 10ROAD AND DESCRIPTION Ten Oaks Road, Dayton, Md MacadamSIZE OF LOT 5.024 Acres M/L TYPE BLDG. _____
NUMBER OF BEDROOMS _____

IF NOT SINGLE RESIDENCE DESCRIBE _____

THE SYSTEM INSTALLED UNDER THIS APPLICATION IS ACCEPTABLE ONLY UNTIL PUBLIC FACILITIES BECOME AVAILABLE.

SIGNATURE OF APPLICANT Allen M. BrownAPPROVED BY W. W. Zepp FOR D. W. DATE 7/16/73
(KIND OF SYSTEM)REJECTED BY _____ FOR _____ DATE _____
(KIND OF SYSTEM)HOLD PENDING FURTHER TESTS W. W. Zepp DATE 7/10/73REASONS FOR REJECTION OR HOLDING final plat

THIS IS NOT A PERMIT

INDICATE NORTH. - NAME ADJOINING ROADWAY AS BASE LINE

DATE	TEST NO.	DEPTH	PRE-WET		TEST - 1" DROP		TIME
			START	STOP	START	STOP	

REMARKS _____

TYPE OF SOIL _____

APPLICATION

A 18635

SEWAGE DISPOSAL TESTING

P _____

STATE OF MARYLAND - DEPARTMENT OF HEALTH AND MENTAL HYGIENE

HOWARD COUNTY HEALTH DEPARTMENT
ENVIRONMENTAL HEALTH SERVICES

P. O. BOX 476, ELLICOTT CITY, MARYLAND 21043
TELEPHONE: 465-5000, EXT. 356

DISTRICT 5

DATE 6/29/73

TO: THE COUNTY HEALTH OFFICER
ELLICOTT CITY, MARYLAND

I, HEREBY, APPLY FOR THE NECESSARY TEST IN ORDER TO CONSTRUCT (OR RECONSTRUCT) A SEWAGE DISPOSAL SYSTEM.

PROPERTY OWNER Allen M. Brown

ADDRESS Linthicum Road, Dayton, Md PHONE 286-2658

PROPERTY LOCATION:

SUBDIVISION _____ LOT NO. 10

ROAD AND DESCRIPTION Ten Oaks Road, Dayton, Md Macadam

SIZE OF LOT 5.024 Acres M/L TYPE BLDG. _____

NUMBER OF BEDROOMS _____

IF NOT SINGLE RESIDENCE DESCRIBE _____

THE SYSTEM INSTALLED UNDER THIS APPLICATION IS ACCEPTABLE ONLY UNTIL PUBLIC FACILITIES BECOME AVAILABLE.

SIGNATURE OF APPLICANT Allen M. Brown


APPROVED BY _____ FOR _____ DATE _____
(KIND OF SYSTEM)

REJECTED BY _____ FOR _____ DATE _____
(KIND OF SYSTEM)

HOLD PENDING FURTHER TESTS _____ DATE _____

REASONS FOR REJECTION OR HOLDING _____

THIS IS NOT A PERMIT

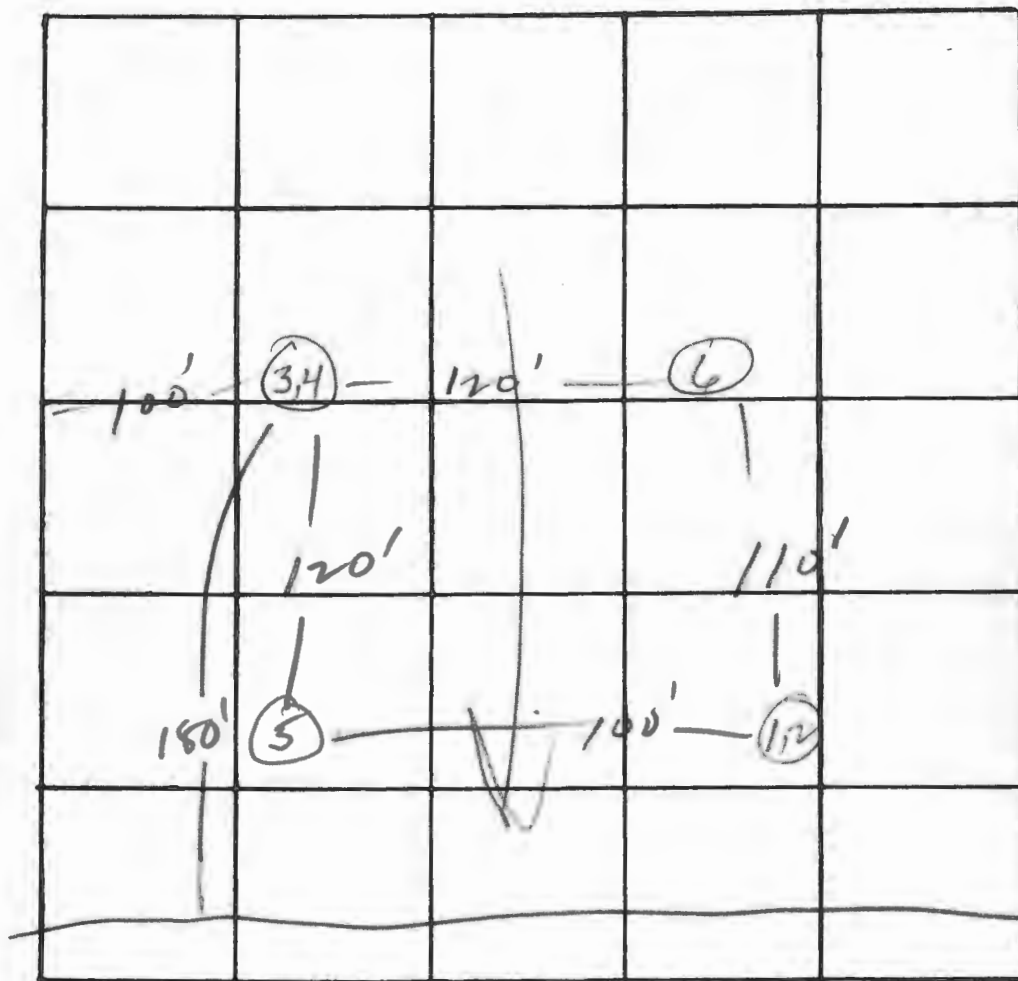

INDICATE NORTH. - NAME ADJOINING ROADWAY AS BASE LINE.

DATE	TEST NO.	DEPTH	PRE-WET		TEST - 1" DROP		TIME
			START	STOP	START	STOP	
7/10/73	1	5	10:15	10:28	10:28	10:43	15
long	2	13	10:17	10:19	10:19	10:32	3
5	3	6	10:23	10:26	10:26	10:33	7
4	4	13	10:23	10:28	10:28	10:35	7
	5	12	Visual, same as 3				
	6	12	Visual, same as 5				

7/10/73


9'

18
14

4
Inlet 3-4
Eff. Area 54
 $\bar{t} = 9\frac{1}{2}'$
110' per lot

REMARKS

TYPE OF SOIL

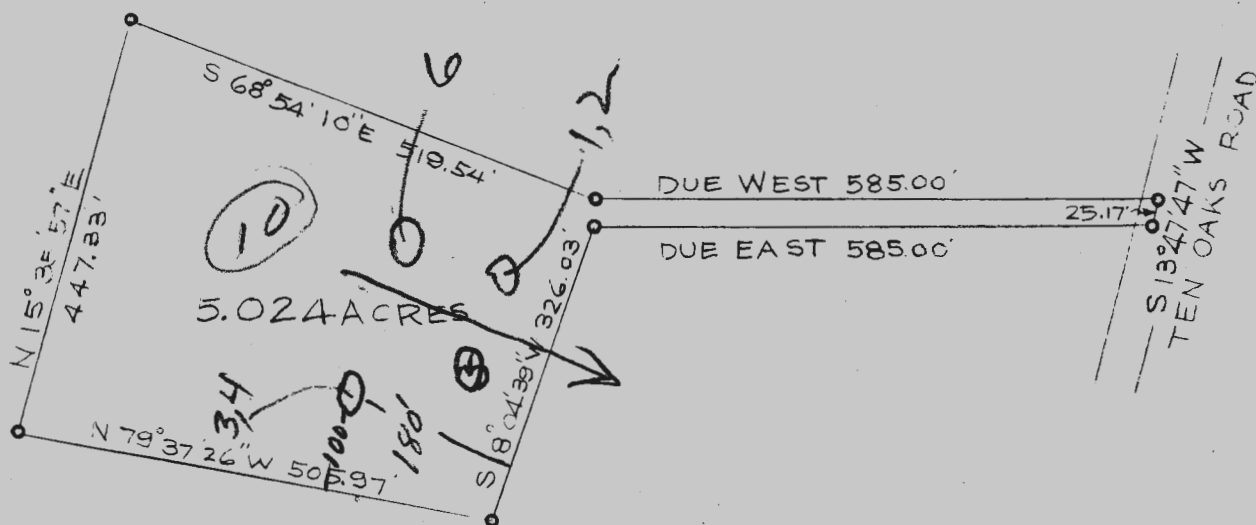

PLAT OF SURVEY
FOR
ALLEN M. BROWN
FIFTH ELECTION DIST, HOWARD CO.
DAYTON, MARYLAND
SCALE: 1 IN = 200 FT. JUNE 11, 1973

Claude M. Skinner, Jr.

Claude M. Skinner, Jr.
Reg. Professional Engineer &
Land Surveyor No. 2237


Note: The lot shown hereon complies with the minimum ownership and lot area as required by the Maryland State Health Department.

Approved: Private Water and Private Sewer

Howard County Health Officer

Date

A 362-10

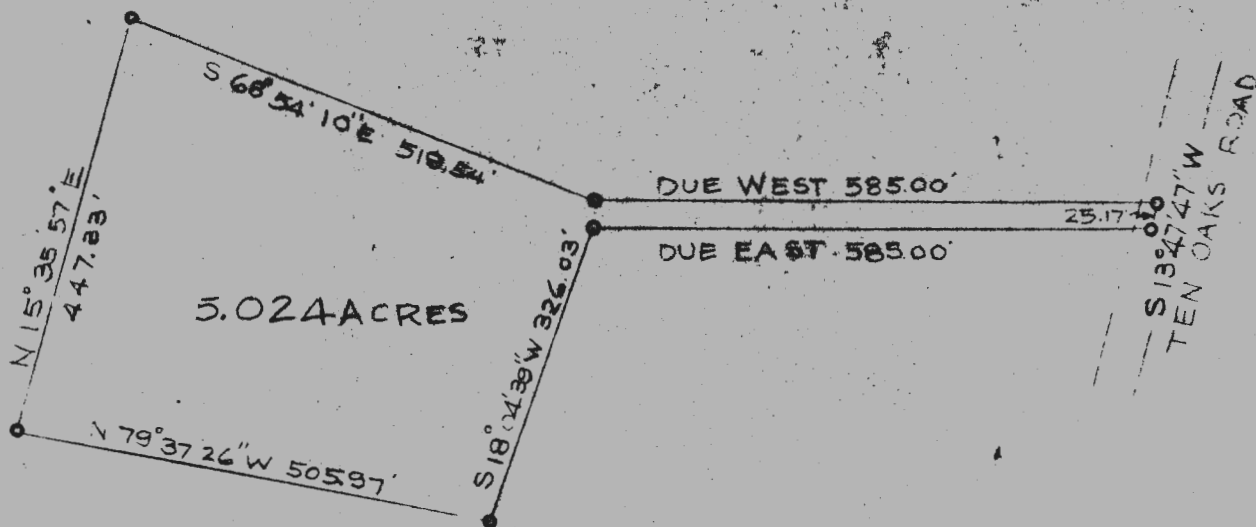

PLAT OF SURVEY
FOR
ALLEN M. BROWN
FIFTH ELECTION DIST, HOWARD CO.
DAYTON, MARYLAND
SCALE: 1 IN = 200 FT. JUNE 11, 1973

Claude M. Skinner, Jr.

Claude M. Skinner, Jr.
Reg Professional Engineer &
Land Surveyor No. 2237

Note: The lot shown hereon complies with the minimum ownership and lot area as required by the Maryland State Health Department.

Approved Private Water and Private Sewer

Robert E. Wine

7-11-73

Notary Public for the State of Maryland

Date

A 3.024 AC