

Real Property Data Search (w1)

Search Result for HOWARD COUNTY

View Map		View GroundRent Redemption		View GroundRent Registration					
Tax Exempt:		Special Tax Recapture:							
Exempt Class:		NONE							
Account Identifier:		District - 06 Account Number - 436919							
Owner Information									
Owner Name:		LOZAR ROSALINE WILLIE PATTERSON DELLA WILLIE ET AL J/T		Use: Principal Residence:					
Mailing Address:		9341 WHISKEY BOTTOM RD LAUREL MD 20723-1327		Deed Reference: /00000/ 00000					
Location & Structure Information									
Premises Address:		9598 WHISKEY BOTTOM RD LAUREL 20723-0000		Legal Description: 3.455 A 9598 WHISKEY BOTTOM RD LAUREL					
Map:	Grid:	Parcel:	Sub District:	Subdivision:	Section:	Block:	Lot:	Assessment Year:	Plat No:
0047	0022	0117		0000				2017	Plat Ref:
Special Tax Areas:				Town:		NONE			
				Ad Valorem:		104			
				Tax Class:					
Primary Structure Built		Above Grade Living Area		Finished Basement Area		Property Land Area		County Use	
1948		756 SF				3.4500 AC			
Stories	Basement	Type	Exterior	Full/Half Bath	Garage	Last Major Renovation			
1	NO	STANDARD UNIT	ASBESTOS SHINGLE	1 full	1 Carport				
Value Information									
		Base Value		Value		Phase-in Assessments			
				As of 01/01/2017		As of 07/01/2018		As of 07/01/2019	
Land:		345,500		310,900					
Improvements		48,500		62,000					
Total:		394,000		372,900		372,900		372,900	
Preferential Land:		0						0	
Transfer Information									
Seller: PATTERSON DELLA WILLIE				Date: 11/05/2004		Price: \$0			
Type: NON-ARMS LENGTH OTHER				Deed1: /00000/ 00000		Deed2:			
Seller: LOZAR ROSALINE WILLIE				Date: 05/06/2004		Price: \$0			
Type: NON-ARMS LENGTH OTHER				Deed1: /08300/ 00197		Deed2:			
Seller: WILLIE HELEN H ET AL				Date: 09/18/1995		Price: \$0			
Type: NON-ARMS LENGTH OTHER				Deed1: /03566/ 00532		Deed2:			
Exemption Information									
Partial Exempt Assessments:		Class		07/01/2018		07/01/2019			
County:		000		0.00					
State:		000		0.00					
Municipal:		000		0.00 0.00		0.00 0.00			

PERMIT

SEWAGE DISPOSAL SYSTEM

MARYLAND STATE DEPARTMENT OF HEALTH*

HOWARD COUNTY

BUREAU OF ENVIRONMENTAL HEALTH

992-2330

P 34626

A REPAIR

ELLICOTT CITY

DISTRICT _____

DATE 11/30/84

Olen Ketterman

IS PERMITTED TO INSTALL _____ ALTER X

ADDRESS _____ PHONE 442-1336

SUBDIVISION _____ ROAD 9598 Whiskey Bottom LOT _____

PROPERTY OWNER D. T. King (Dean S. Patterosn - Contractor Purchaser)

ADDRESS _____

IF GARBAGE GRINDER IS USED INCREASE SEPTIC TANK CAPACITY BY 50% AND ABSORPTION AREA BY 22%.

GARBAGE GRINDER? YES _____ NO _____

SEPTIC TANK CAPACITY _____ GALLONS NUMBER OF BEDROOMS _____

REPAIR - Observation holes needed for future repairs to existing septic system.

PLANS APPROVED BY Frank Skinner DATE 11/30/84

COVER NO WORK UNTIL INSPECTED AND APPROVED.

NEITHER THE HOWARD COUNTY COUNCIL NOR THE HEALTH DEPARTMENT IS RESPONSIBLE FOR THE SUCCESSFUL OPERATION OF ANY SYSTEM.

NOTE: IF TRENCH IS USED CALL FOR INSPECTION BEFORE AND AFTER PLACING GRAVEL IN TRENCH.

NOTE: NO DRY WELL SHALL EXCEED 15 FOOT IN DIAMETER. NO ABSORPTION TRENCH TO EXCEED 100 FEET IN LENGTH.

NOTE: ALL PIPE FROM HOUSE TO SEPTIC TANK MUST BE CAST IRON OR SCHEDULE 40 PVC OR ABS.


PERMIT VOID AFTER THREE YEARS.

NOTE: INSTALL STAND PIPE ON SEPTIC TANK AND DRY WELL. STAND PIPES MUST BE 6 INCHES IN DIAMETER. CAST IRON, CONCRETE OR TERRA COTTA, OR PVC OR ABS ACCEPTED. IF TOP OF SEPTIC TANK IS DEEPER THAN 3 FEET MANHOLE TO GRADE REQUIRED.

***INSTALLER IS RESPONSIBLE FOR OBTAINING FINAL APPROVAL ON THIS PERMIT**

*CALL 992-2330 FOR INSPECTION OF SEPTIC SYSTEMS.

EH - 2-1082

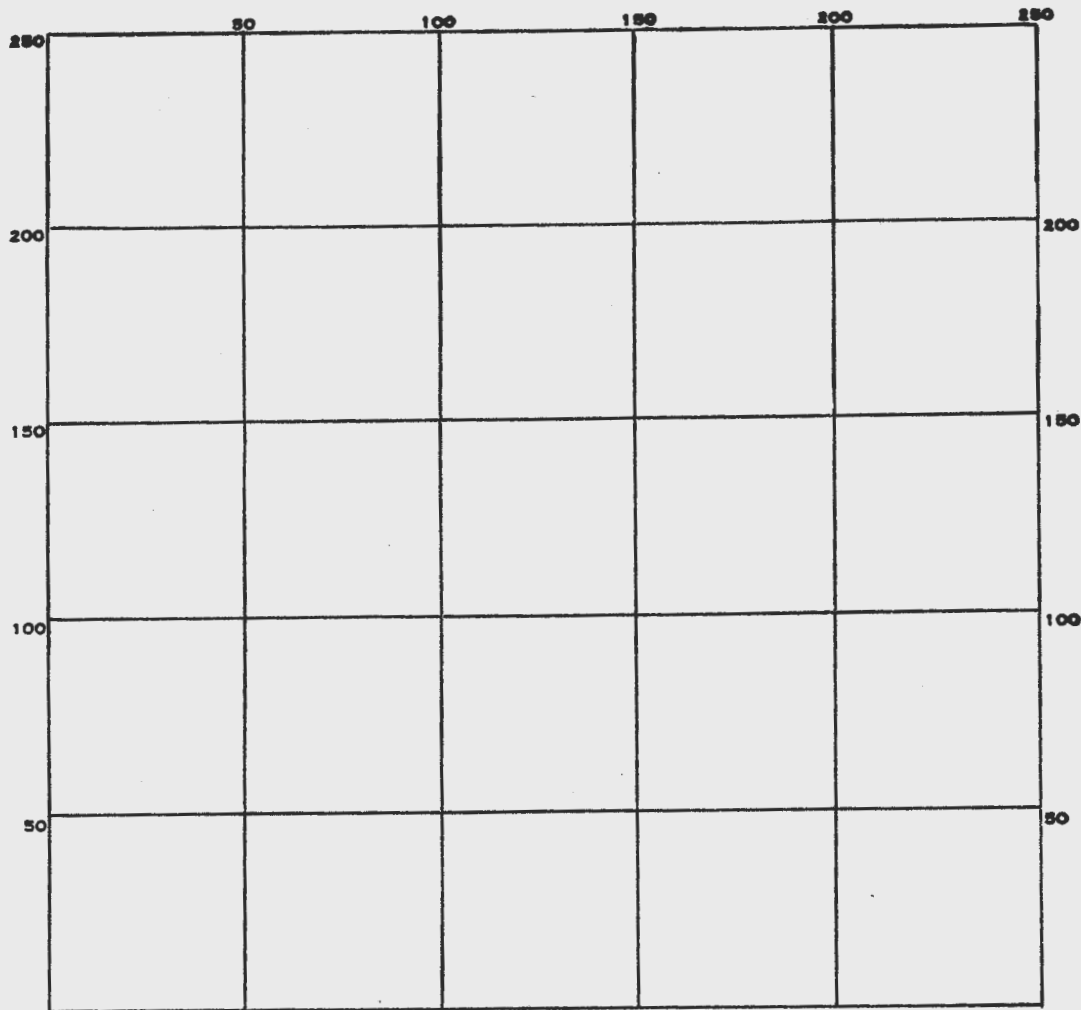

INDICATE NORTH. - NAME ADJOINING ROADWAY AS BASE LINE.

PERMIT CARD _____

SEPTIC TANK, LEVEL _____

CLEANOUTS _____

DISTRIBUTION BOX, LEVEL _____

TILE FIELD, DEPTH _____ FT. TRENCH WIDTH _____ FT.

GRAVEL DEPTH _____ IN. TOTAL LENGTH _____ FT.

NUMBER OF TRENCHES _____ TOTAL BOTTOM AREA _____

SEEPAGE PITS, INSIDE DIAMETER _____ FT. DEPTH BELOW INLET _____ FT.

ABSORBENT AREA _____ SQ. FT.

REMARKS _____

DATE SYSTEM APPROVED _____ INSPECTOR _____

County Road
M 8410

30

203'

95'

88'

16'
STONE

Center of County Road leading to Dairy Wmsh Blvd

116.8

932

1
STONE


193'

Cohen
Co

PROPERTY of J.T. KING

Howard County BM 165 F410 119

SCALE 1 in = 100 Feet

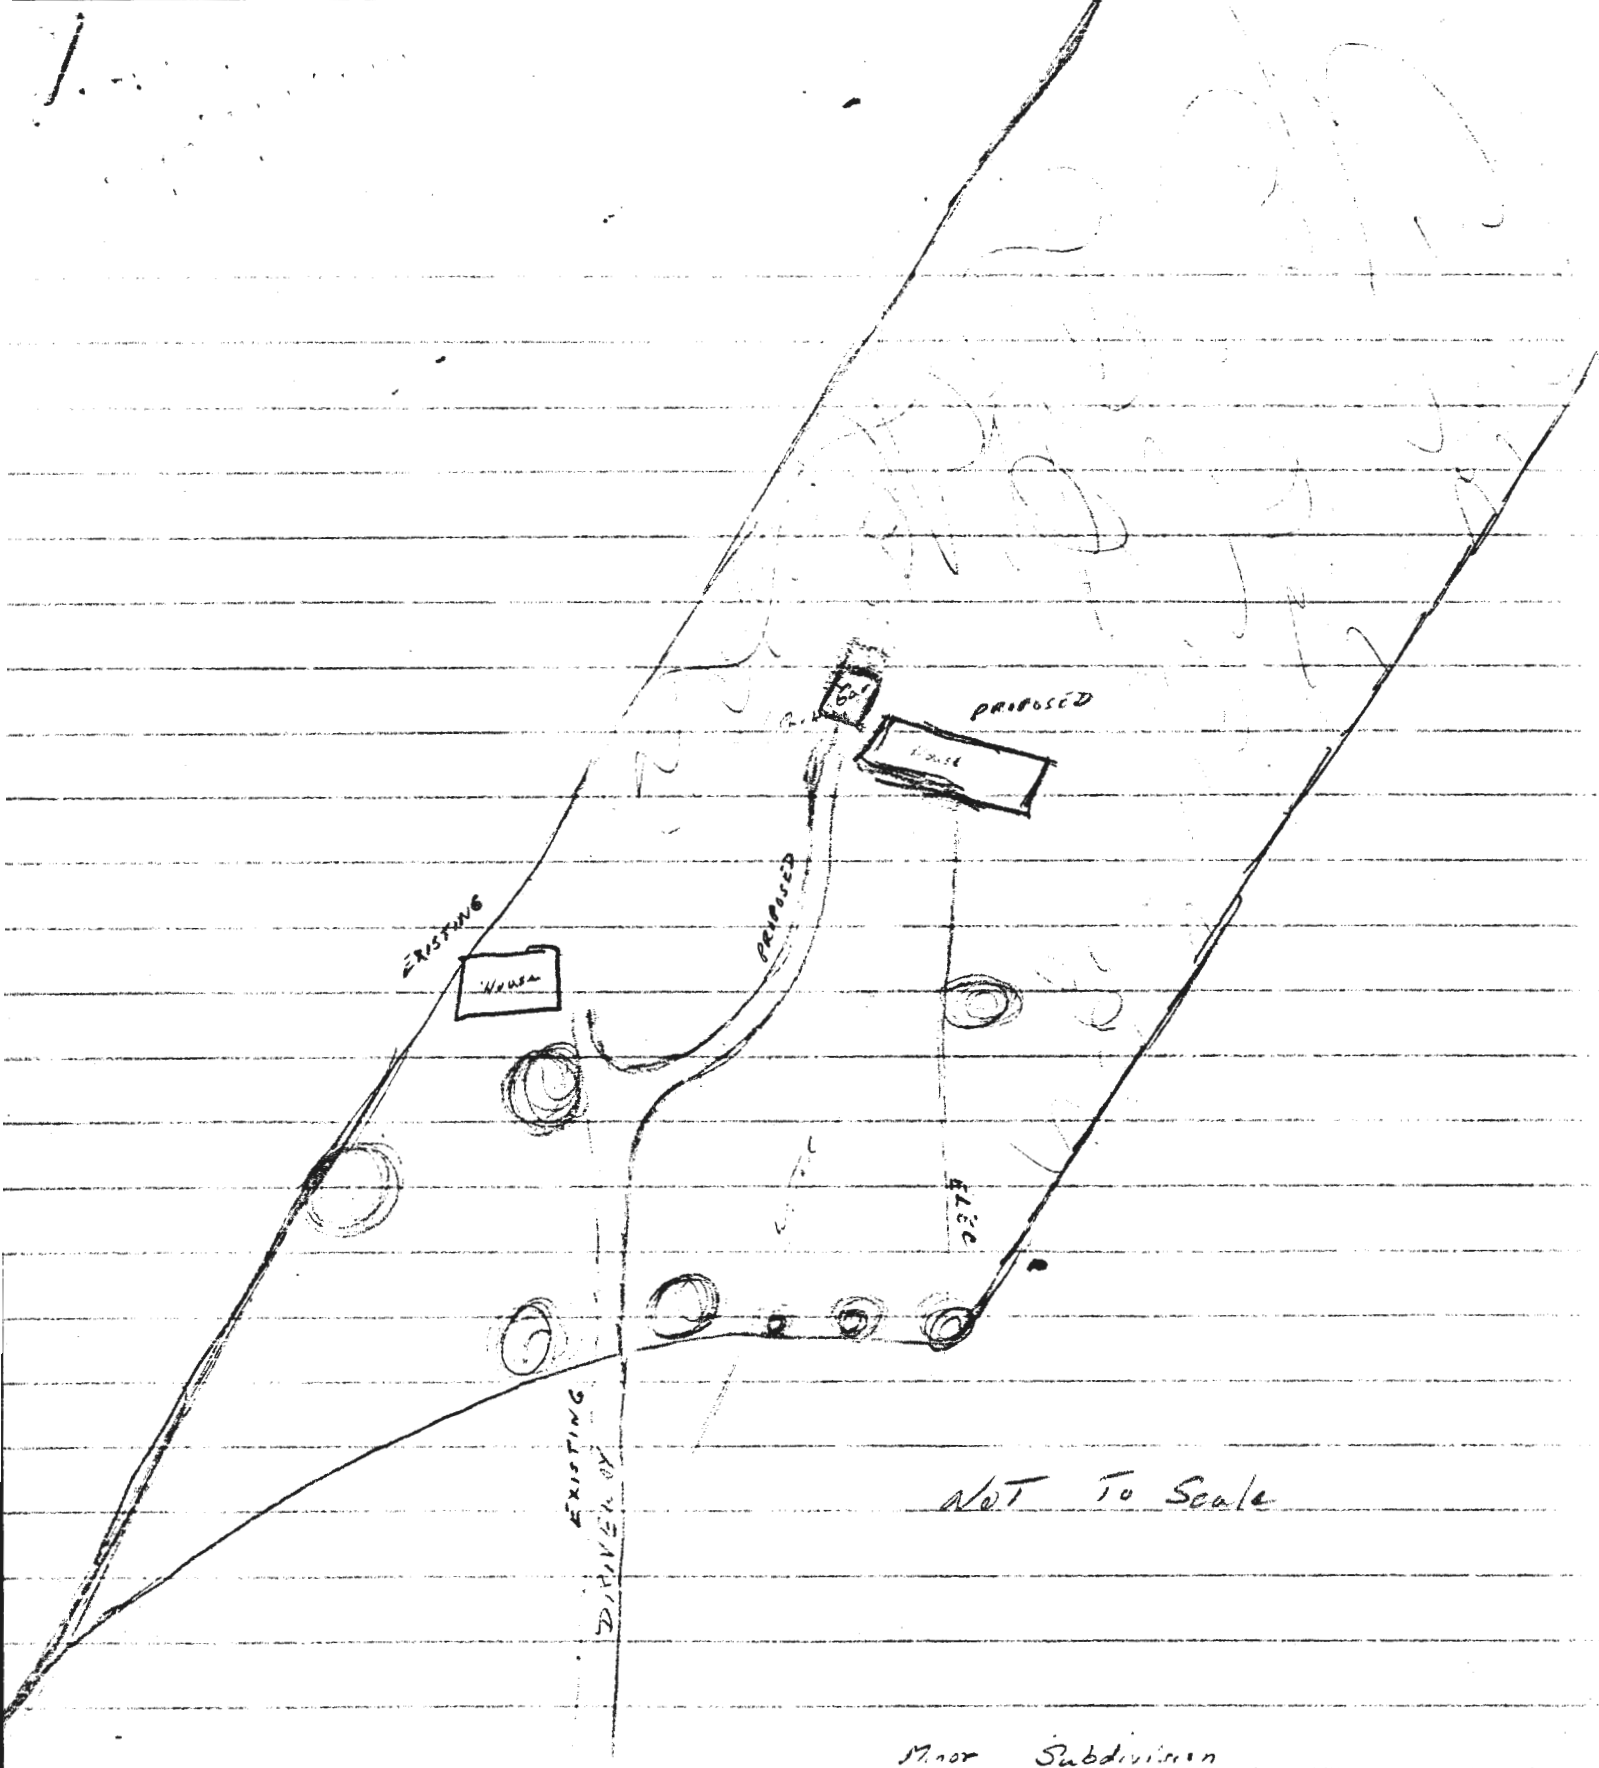

Minor Subdivision

Whole Survey

Pack Test

New Deeds

County Hearings/Permits

Note: The location of the house shown hereon is approximate, based on the stone found and the centerline of the old highway. Bottom road traveled away. The description of the tract of land conveyed to David T. King does not closely by over 15 ft. and the relative positions of the property lines shown is approximate. as is the location of the house.

Howard County, Md.
Scottdale, Ga.
Oct. 1984

LAVREL

WHISKEY BOTTOM ROAD

8656.

