

APPLICATION

18293

SEWAGE DISPOSAL TESTING

STATE OF MARYLAND - DEPARTMENT OF HEALTH AND MENTAL HYGIENE

HOWARD COUNTY HEALTH DEPARTMENT
ENVIRONMENTAL HEALTH SERVICES
P. O. BOX 476, ELLICOTT CITY, MARYLAND 21043
TELEPHONE: 465-5000, EXT. 356

DISTRICT 3rd

DATE 4/18/73

TO: THE COUNTY HEALTH OFFICER
ELLICOTT CITY, MARYLAND

I, HEREBY, APPLY FOR THE NECESSARY TEST IN ORDER TO CONSTRUCT (OR RECONSTRUCT) A SEWAGE DISPOSAL SYSTEM.

PROPERTY OWNER Adelphia Developers

ADDRESS 6931 Donachie Road, Balto., Md. 21239

Purdum & Jeschke
PHONE 465-1635

PROPERTY LOCATION:

SUBDIVISION Adelphia

LOT NO. 4

ROAD AND DESCRIPTION Unnamed road

SIZE OF LOT 40,000 sq. ft.

TYPE BLDG. 3 or 4 bedrooms
NUMBER OF BEDROOMS

IF NOT SINGLE RESIDENCE DESCRIBE _____

THE SYSTEM INSTALLED UNDER THIS APPLICATION IS ACCEPTABLE ONLY UNTIL PUBLIC FACILITIES BECOME AVAILABLE.

SIGNATURE OF APPLICANT /s/ Purdum & Jeschke

APPROVED BY _____ FOR _____ DATE _____
(KIND OF SYSTEM)


REJECTED BY _____ FOR _____ DATE _____
(KIND OF SYSTEM)

HOLD PENDING FURTHER TESTS _____ DATE _____

REASONS FOR REJECTION OR HOLDING _____

THIS IS NOT A PERMIT

APPLICATION

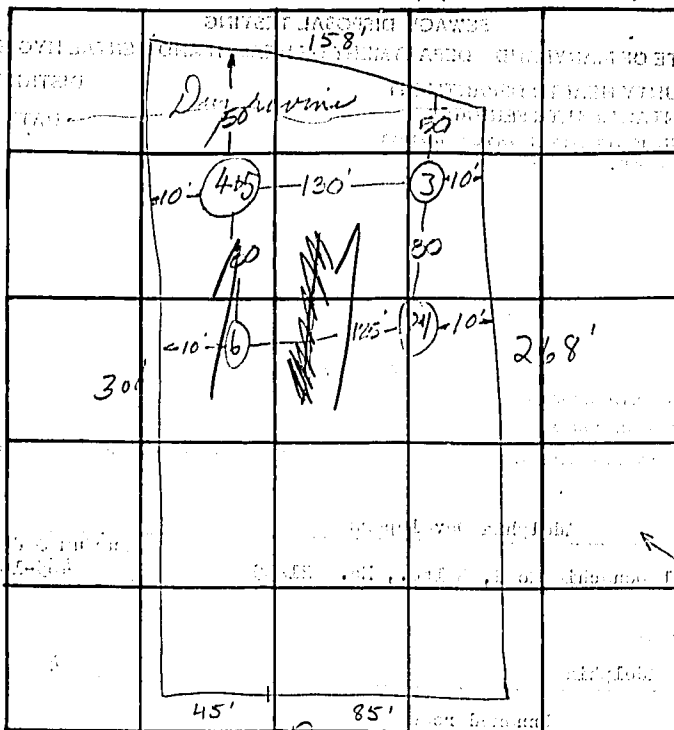

INDICATE NORTH - NAME ADJOINING ROADWAY AS BASE LINE.

DATE	TEST NO.	DEPTH	PRE-WET		TEST - 1" DROP		TIME
			START	STOP	START	STOP	
5/2/73	1 (high)	3 1/2	9:55	9:58	9:58	10:01	3
	2 (high)	10 1/2	9:55	9:58	9:58	10:05	7
	3	9	Visual	hole	10:05	10:12	11
	4	4	10:12	10:17	10:17	10:25	8
	5	10 1/2	10:12	10:14	10:14	10:18	4
	6	9 1/2	Visual	hole	10:18	10:22	5


Use 14"
united
3 1/2"
Hole depth
11"
to 14.2
5mm

REMARKS

TYPE OF SOIL

Sandy silt

Holes Certified
11.7 & 12.5 5/2/73

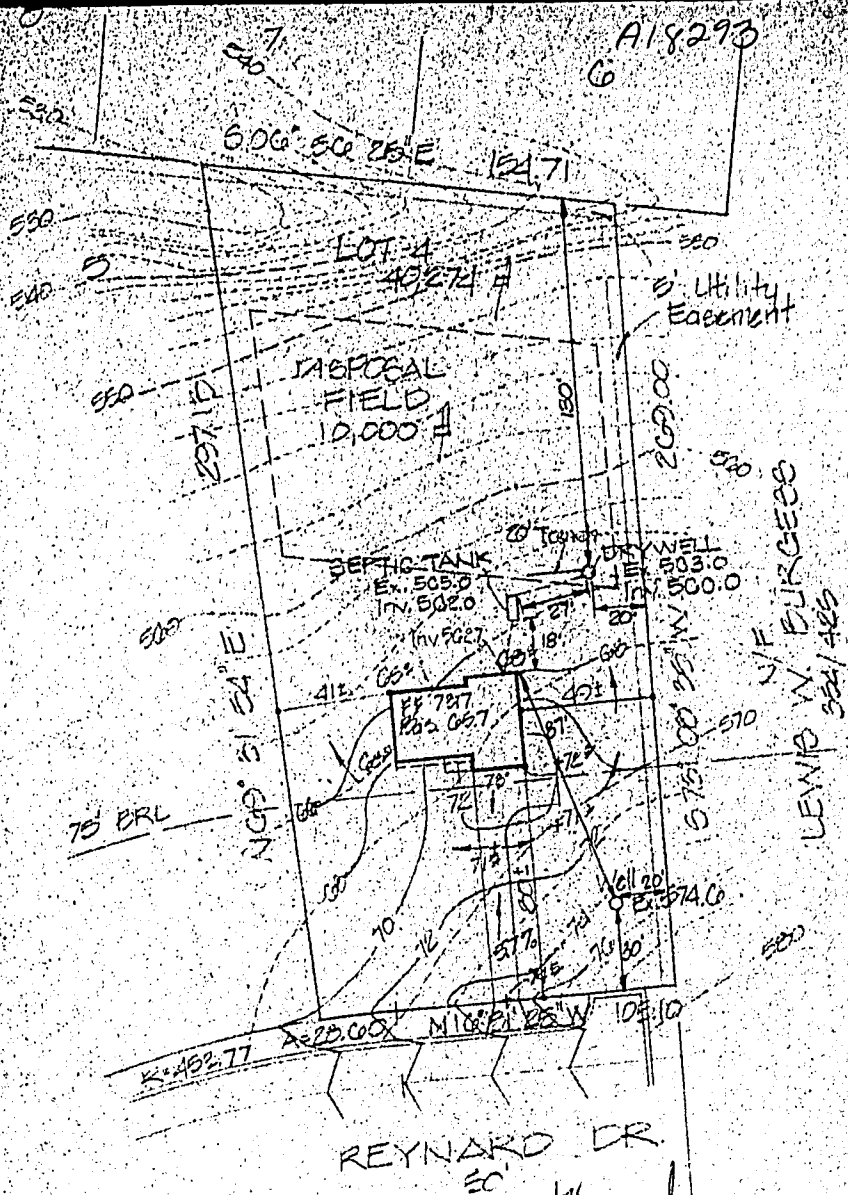

12/17/74
Approved
WWS