

6/30/77

PERMIT

SEWAGE DISPOSAL SYSTEM

MARYLAND STATE DEPARTMENT OF HEALTH

HOWARD COUNTY

ELLICOTT CITY

DISTRICT 3rd

DATE 6/28/77

INDEXED

Roland Barth

IS PERMITTED TO INSTALL ☒ ALTER

ADDRESS Clarksville Pike, Ellicott City, Md.

PHONE 730-3495

A SEWAGE DISPOSAL SYSTEM LOCATED AT

SUBDIVISION Eagles Loft

ROAD 3513 Reynard Drive

LOT 4

PROPERTY OWNER Nu-Homes, Inc.

ADDRESS 6655-H Dobbin Road, Columbia, Md. 21045

Phone: 997-7019

SPECIFICATIONS 3 bedrooms

DRAIN FIELD DEPTH FEET, BOTTOM AREA SQ. FT.

SEEPAGE PITS ABSORBENT SIDE-WALL AREA SQ. FT.

SEPTIC TANK CAPACITY 1000 GALLONS

FOR GARBAGE GRINDER, INCREASE DISPOSAL AREA 22% & TANK CAPACITY 50%.

OTHER DRY WELL - Dry well to have 390 sq. ft. absorbent sidewall area. Inlet at 3 1/2 ft. and maximum depth 11 ft. below original grade. Locate dry well 20 ft. off right 1st line and 130 ft. from Reynard Drive as seen when facing lot from Reynard Drive. Okay

NOTE: NO DRY WELL IS TO EXCEED 15 FOOT IN DIAMETER.

NOTE: ALL PIPE FROM HOUSE TO DISPOSAL AREA MUST BE CAST IRON.

PERMIT VOID AFTER THREE YEARS

NOTE: INSTALL STAND PIPE ON SEPTIC TANK AND DRY WELL. STAND PIPES MUST BE 6 INCHES IN DIAMETER. CAST IRON, CONCRETE OR TERRA COTTA ACCEPTED.


PLANS APPROVED BY William W. Zepp

DATE 2/18/76

FILL SEPTIC TANK AND DISTRIBUTION BOX WITH WATER BEFORE CALLING FOR AN INSPECTION. COVER NO WORK UNTIL INSPECTED AND APPROVED.

NEITHER THE HOWARD COUNTY COMMISSIONERS NOR THE HEALTH DEPARTMENT IS RESPONSIBLE FOR THE SUCCESSFUL OPERATION OF ANY SYSTEM.

18293

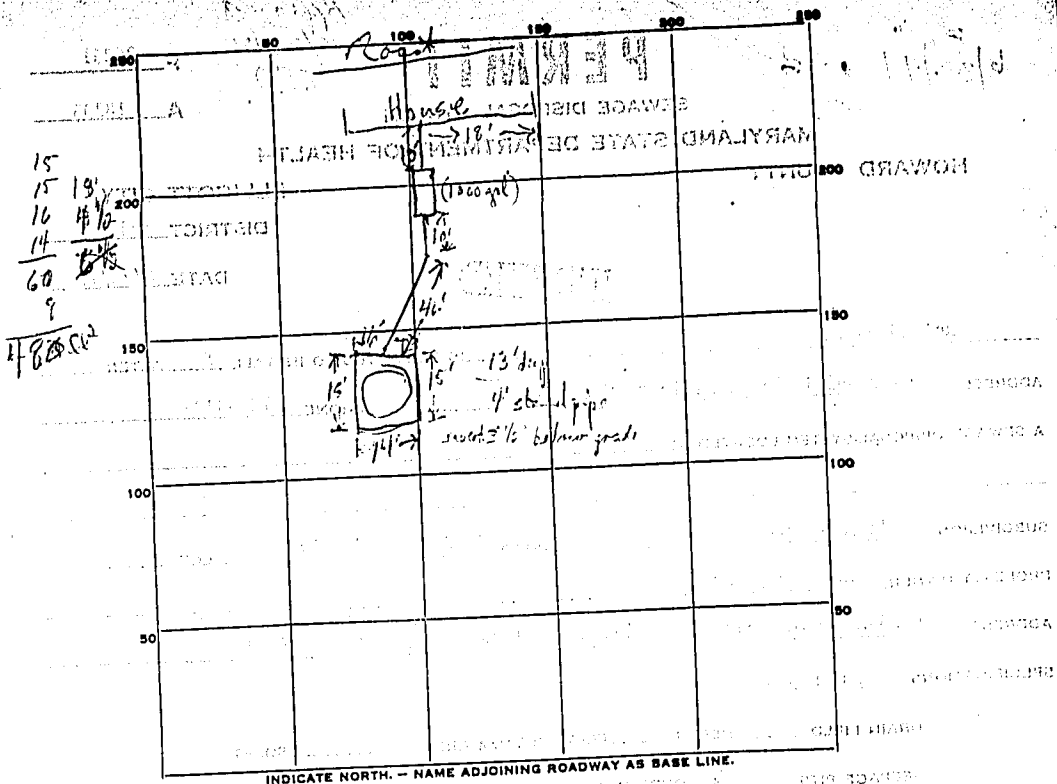

PERMIT CARD OK

CLEANOUTS ST DL

SEPTIC TANK, LEVEL _____

DISTRIBUTION BOX, LEVEL _____

TILE FIELD, DEPTH _____ FT. TRENCH WIDTH _____ FT.

GRAVEL DEPTH _____ IN. TOTAL LENGTH _____ FT.

NUMBER OF TRENCHES _____ TOTAL BOTTOM AREA _____

SEEPAGE PITS, INSIDE DIAMETER Perimeter 60 FT. DEPTH BELOW INLET 8 FT.

ABSORBENT AREA 480 SQ. FT.

REMARKS _____

DATE SYSTEM APPROVED 6/30/77

INSPECTOR Thomas L. DeJ