

DEPARTMENT OF INSPECTIONS, LICENSES AND PERMITS 3400 COURT HOUSE DRIVE ELICOTT CITY, MD 21043 PERMITS (410) 313-2100 INSPECTIONS (410) 313-1810 AUTOMATED INFORMATION (410) 313-3800		HOWARD COUNTY PERMIT APPLICATION		PERMIT NUMBER B07001562	
Building Address <u>3516 Reynard Drive</u> <u>Ellicott City, MD 21042</u>		Property Owner's Name <u>Patricia Palombo</u> Address <u>3516 Reynard Drive</u>		City <u>Ellicott City</u> State <u>MD</u> Zip Code <u>21042</u> Home Phone <u>(410) 531-3956</u> Work Phone <u>(301) 252-8312</u> Applicant's Name & Mailing Address, (if other than stated hereon): _____ _____ _____	
Suite/Apt. #: _____ SDP/NP/Petition #: _____ Census Tract _____ Subdivision _____ Section _____ Area _____ Lot _____ Tax Map _____ Parcel _____ Grid _____ Zoning _____ Map Coordinates _____ Lot size _____		Contractor Company <u>Capezio Contractors, Inc.</u> Contact Person <u>Lisa Warfield / Royce Garlund</u> Address <u>8550 Veterans Highway</u> City <u>Millersville</u> State <u>MD</u> Zip Code <u>21108</u> License No. <u>50552</u> Phone <u>(410) 729-2900</u> Fax <u>(410) 729-2998</u>		Existing Use <u>Single Family Home</u> Proposed Use <u>Single Family Home</u> Estimated Construction Cost <u>\$67,950.74</u> Description of Work <u>Replace 5 roof trusses,</u> <u>Vinyl Siding, 2 windows, replace</u> <u>bath fixtures, paint + carpet.</u>	
Occupant or Tenant _____ Contact Name <u>Patricia Palombo</u> Address <u>3516 Reynard Drive</u> City <u>Ellicott City</u> State <u>MD</u> Zip Code <u>21042</u> Phone <u>(410) 531-3956</u> Fax _____		Engineer or Architect Company <u>N/A</u> Contact Person _____ Address _____ City _____ State _____ Zip Code _____ Phone _____ Fax _____			

BUILDING DESCRIPTION - <u>COMMERCIAL</u>		BUILDING DESCRIPTION - <u>RESIDENTIAL</u>	
Building Characteristics Height: _____ No. of stories: _____ Gross area, sq. ft. per floor: _____ Use group: _____ Construction type: ☐ Reinforced Concrete ☐ Structural Steel ☐ Masonry ☐ Wood Frame ☐ State Certified Modular	Utilities Water Supply: ☐ Public ☐ Private Sewage Disposal: ☐ Public ☐ Private Electric Yes ☐ No ☐ Gas Yes ☐ No ☐ Heating System: Electric ☐ Oil ☐ Natural Gas ☐ Propane Gas ☐ Sprinkler system: <u>N/A</u> ☐ ☐ Full ☐ Partial ☐ Other Suppression # of Heads _____	Building Characteristics SF Dwelling ☒ SF Townhouse ☐ 1st floor: <u>34'</u> <u>38'</u> 2nd floor: <u>34'</u> <u>52'</u> Basement: <u>34'</u> <u>38'</u> Finished Basement ☐ Unfinished Basement ☒ Crawl space ☐ Slab on Grade ☐ No. of Bedrooms <u>4</u> Height: _____ Multi-family dwellings: No. of efficiency units: _____ No. of 1 BR units: _____ No. of 2 BR units: _____ No. of 3 BR units: _____ Other Structure: _____ Dimensions: _____ Footings: _____ Roof Height: _____ ☐ State Certified Modular ☐ Manufactured Home	Utilities Water Supply: ☐ Public ☒ Private Sewage Disposal: ☐ Public ☒ Private Electric Yes ☐ No ☐ Gas Yes ☐ No ☐ Heating System: Electric ☐ Oil ☐ Natural Gas ☐ Propane Gas ☐ Sprinkler system: <u>N/A</u> ☒ ☐ NFPA #13D ☐ NFPA #13R Other: _____

THE UNDERSIGNED HEREBY CERTIFIES AND AGREES AS FOLLOWS: (1) THAT HE/SHE IS AUTHORIZED TO MAKE THIS APPLICATION; (2) THAT THE INFORMATION IS CORRECT; (3) THAT HE/SHE WILL COMPLY WITH ALL REGULATIONS OF HOWARD COUNTY WHICH ARE APPLICABLE THERE TO; (4) THAT HE/SHE WILL PERFORM NO WORK ON THE ABOVE REFERENCED PROPERTY NOT SPECIFICALLY DESCRIBED IN THIS APPLICATION; (5) THAT HE/SHE GRANTS COUNTY OFFICIALS THE RIGHT TO ENTER ONTO THIS PROPERTY FOR THE PURPOSE OF INSPECTING THE WORK PERMITTED AND POSTING NOTICES

Applicant's Signature Lisa Warfield _____
 Title/Company Office Manager / Capezio Contractors, Inc. _____
 Date 3/28/07 _____

Checks payable to: **DIRECTOR OF FINANCE OF HOWARD COUNTY**

** PLEASE WRITE NEATLY AND LEGIBLY. **

- FOR OFFICE USE ONLY -

AGENCY	DATE	SIGNATURE APPROVAL	DPZ SETBACK INFORMATION	PROPERTY ID#
Land Development, DPZ			Front: _____	Filing fee \$ _____
State Highways			Rear: _____	Permit fee \$ _____
Building Official			Side: _____	Excise tax \$ _____
Dev. Engineering, DPZ			Side St.: _____	Add'l per. fee \$ _____
Health	<u>5/2/07</u>	<u>Collection</u>	All minimum setbacks met?	TOTAL FEES \$ _____
Fire Protection			YES ☐ NO ☐	Sub-total paid \$ _____
Is Sediment Control approval required prior to issuance?			Is Entrance Permit required?	Balance due \$ _____
YES ☐ NO ☐			YES ☐ NO ☐	Check \$ _____
CONTINGENCY CONSTRUCTION START: ☐ ONE STOP SHOP: ☐			Historic District?	Validation \$ _____
			YES ☐ NO ☐	
Lot Coverage for NewTown Zone _____ SDP/Red-line approval date _____			Accepted by _____	
Distribution of Copies: White: Building Official Green: LDD, DPZ Yellow: DED, DPZ Pink: Health Gold: SHA T:\norm\PERMIT.FRM				

Rev. 11/4/04

SITE PLAN
LOT 10, TRIDELPHIA RIDGE ESTATES
WEST FRIENDSHIP (3RD) DISTRICT
HOWARD COUNTY, MARYLAND
SCALE 1"=100' JULY, 1988


APPROVED

WALK-THRU BUILDING PERMIT

BP# B07001562 A# 38708

APP. SAN AT DATE 5/2/07

DESC. OF WORK: 3516 Reynard Dr
Replace 5200# trusses, vinyl
siding, 2 windows, Replace bath
fixtures, paint + carpet

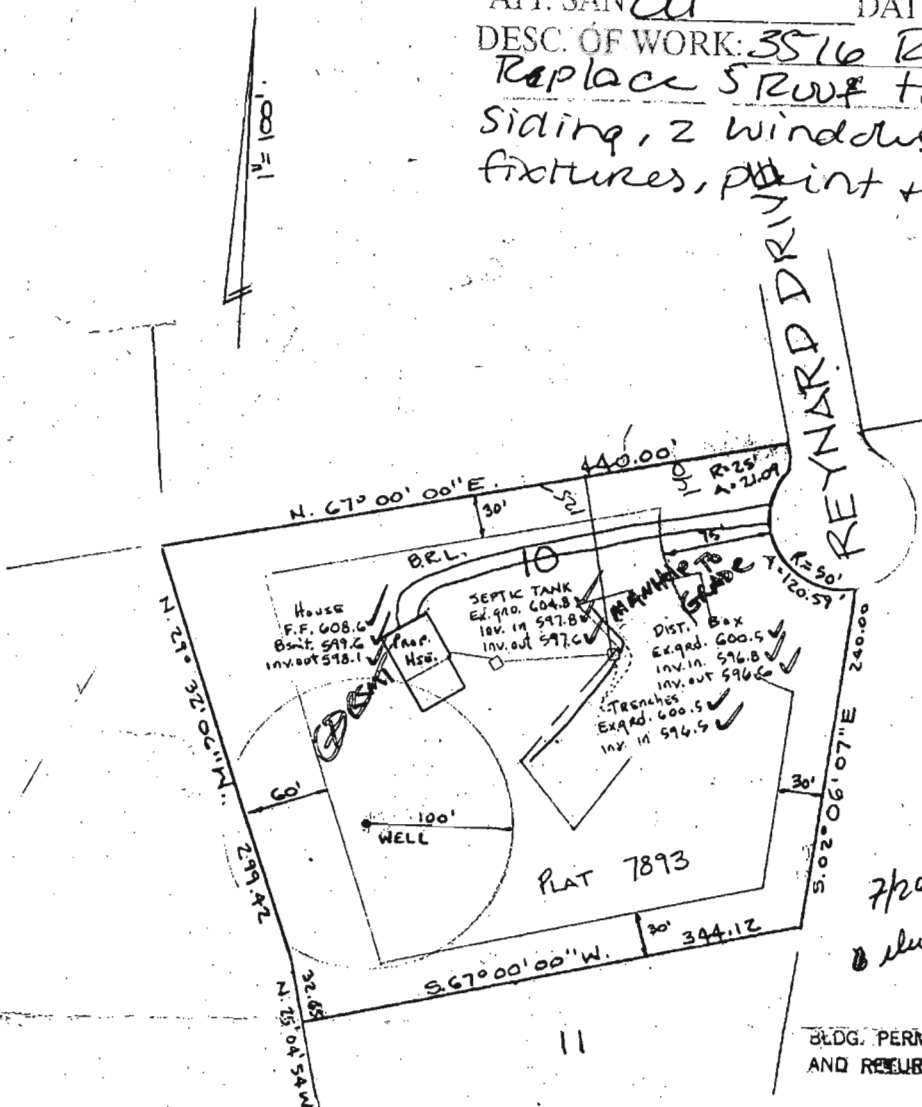

BLDG. PERMIT SIGNED
AND RETURNED 7-26-88

BP 20273
SK

THE BOUNDARY INFORMATION
SHOWN HEREON IS BASED UPON
DEED(S) AND/OR PLATS OF RECORD
AND DOES NOT REFLECT A
BOUNDARY SURVEY.

I CERTIFY TO THE BEST OF
MY KNOWLEDGE AND BELIEF
THAT THE PLAN SHOWN HEREON
IS CORRECT.

W. Allen Brown 7/20/88
MD. P.L.S. # 299

Al Brown Surveys Inc.

7308 MINK HOLLOW ROAD
HIGHLAND, MARYLAND 20777
RES. 301-854-0813