

PRELIMINARY

APPLICATION

A 21909

SEWAGE DISPOSAL TESTING

P _____

STATE OF MARYLAND - DEPARTMENT OF HEALTH AND MENTAL HYGIENE

HOWARD COUNTY HEALTH DEPARTMENT
ENVIRONMENTAL HEALTH SERVICES

DISTRICT 4th

P. O. BOX 476, ELLICOTT CITY, MARYLAND 21043
TELEPHONE: 465-5000, EXT. 356

DATE 7/31/75

TO: THE COUNTY HEALTH OFFICER
ELLICOTT CITY, MARYLAND

I, HEREBY, APPLY FOR THE NECESSARY TEST IN ORDER TO CONSTRUCT (OR RECONSTRUCT) A SEWAGE DISPOSAL SYSTEM.

PROPERTY OWNER Benjamin F. Clements

ADDRESS P. O. Box 355, Mt. Airy, Md.

PHONE 829-2257

PROPERTY LOCATION:

SUBDIVISION _____ LOT NO. _____

ROAD AND DESCRIPTION Penn Shop Road - right beside government observation tower

approx. 975 ft. back off road

(Turn in 4th road saw mill!!)

SIZE OF LOT 140.371 acres

TYPE BLDG. 3 bedrooms

NUMBER OF BEDROOMS

IF NOT SINGLE RESIDENCE DESCRIBE _____

THE SYSTEM INSTALLED UNDER THIS APPLICATION IS ACCEPTABLE ONLY UNTIL PUBLIC FACILITIES BECOME AVAILABLE.

SIGNATURE OF APPLICANT Donnie B. Clements

APPROVED BY _____ FOR _____ DATE _____

(KIND OF SYSTEM)

REJECTED BY _____ FOR _____ DATE _____

(KIND OF SYSTEM)

HOLD PENDING FURTHER TESTS W/WZ DATE 8/7/75

REASONS FOR REJECTION OR HOLDING 8/12/75 Hold for certified plat for

house plans.

C.B.D.

THIS IS NOT A PERMIT

INDICATE NORTH. - NAME ADJOINING ROADWAY AS BASE LINE

Form 100-1000 - Right hand side observation tower

DATE	TEST NO.	DEPTH	PRE-WET		TEST - 1" DROP		TIME
			START	STOP	START	STOP	
8/12/75	1 A	4' X	1:24	1:40	1:40	X	
	1 B	11'	1:32	1:39	1:39	1:58	19m
	2 A	3'	1:02	1:06	1:06	1:14	8m
	(L) 2 B	9 1/2'	1:03	1:26	1:26	1:55	29m
	3 B	5'	1:06	1:12	1:12	1:30	18m
	4	10'	Visual	similar	to other		disregard
	1 C	4'-5"	2:04	2:07	2:07	2:13	6m

close to base

disregard

REMARKS Below Clay
 TYPE OF SOIL Weathered shale below clay
 TESTED BY C. Theak ALSO PRESENT: Robert Clement

PRELIMINARY

APPLICATION

A 21909

SEWAGE DISPOSAL TESTING

P

STATE OF MARYLAND - DEPARTMENT OF HEALTH AND MENTAL HYGIENE

HOWARD COUNTY HEALTH DEPARTMENT
ENVIRONMENTAL HEALTH SERVICES

DISTRICT 4th

P. O. BOX 476, ELLICOTT CITY, MARYLAND 21043
TELEPHONE: 465-5000, EXT. 356

DATE 7/31/75

TO: THE COUNTY HEALTH OFFICER
ELLICOTT CITY, MARYLAND

I, HEREBY, APPLY FOR THE NECESSARY TEST IN ORDER TO CONSTRUCT (OR RECONSTRUCT) A SEWAGE DISPOSAL SYSTEM.

PROPERTY OWNER Benjamin F. Clements

ADDRESS P. O. Box 355, Mt. Airy, Md. PHONE 829-2257

PROPERTY LOCATION:

SUBDIVISION LOT NO.

ROAD AND DESCRIPTION Penn Shop Road - right beside government observation tower
approx. 975 ft. back off road

SIZE OF LOT 140.371 acres TYPE BLDG. 3 bedrooms
NUMBER OF BEDROOMS

IF NOT SINGLE RESIDENCE DESCRIBE

THE SYSTEM INSTALLED UNDER THIS APPLICATION IS ACCEPTABLE ONLY UNTIL PUBLIC FACILITIES BECOME AVAILABLE.

SIGNATURE OF APPLICANT Donnie B. Clements

APPROVED BY FOR DATE
(KIND OF SYSTEM)

REJECTED BY FOR DATE
(KIND OF SYSTEM)


HOLD PENDING FURTHER TESTS DATE

REASONS FOR REJECTION OR HOLDING 8/12/75 Hold for certified plat. CRS.

THIS IS NOT A PERMIT

① 0 1/2
soil
w some
shale
8
shaly
some soil
12

② 0
clayish
4
gray
w some rock
8
layered
shale
12

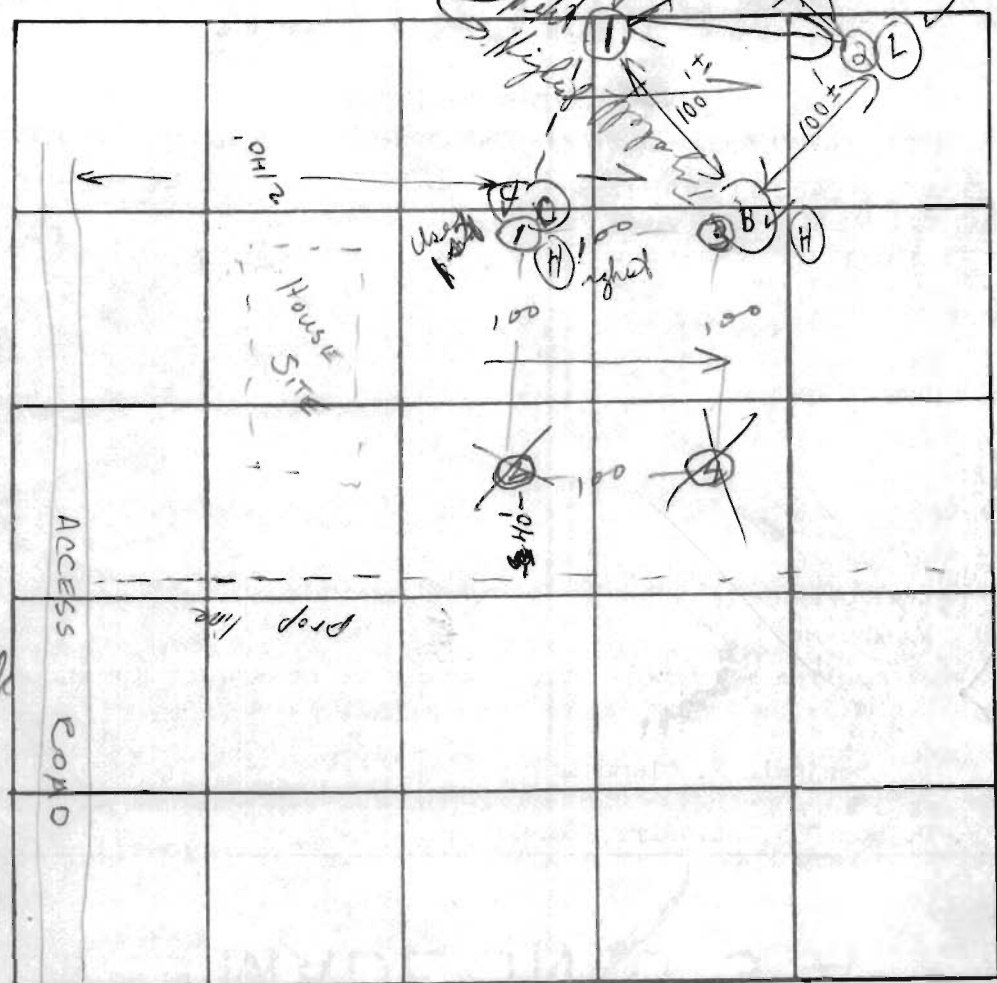

INDICATE NORTH - NAME ADJOINING ROADWAY AS BASE LINE
PENN SHOP RD

DATE	TEST NO.	DEPTH	PRE-WET		TEST - 1" DROP		TIME
			START	STOP	START	STOP	
7/75	1	4	10:33	Pulled peg	11:00	No PERC	
Use	1-A	12	10:34	10:48	10:48	11:13	25
	2	4	10:37	Pulled peg	11:15	No PERC	
	2-A	10	10:38	10:42	10:42	10:50	8
	3	4 1/2	10:58	Pulled peg	11:20	No PERC	
	3-A	12	10:59	11:07	11:07	11:25	18
	4	4		Clay; did not perc			
	4-A	11 1/2		TOO HARD TO DIG			
8/12	1C	5'	1:59	2:08	2:08	2:10	20
	1D	6'	2:30	2:37	2:37	2:57	20

2-A - shallow hole - loose mat. top of hole → not true test

REMARKS

TYPE OF SOIL


clay → hard shale Hold for certified holes

TESTED BY

WWZ

ALSO PRESENT:

Mrs Clements & son

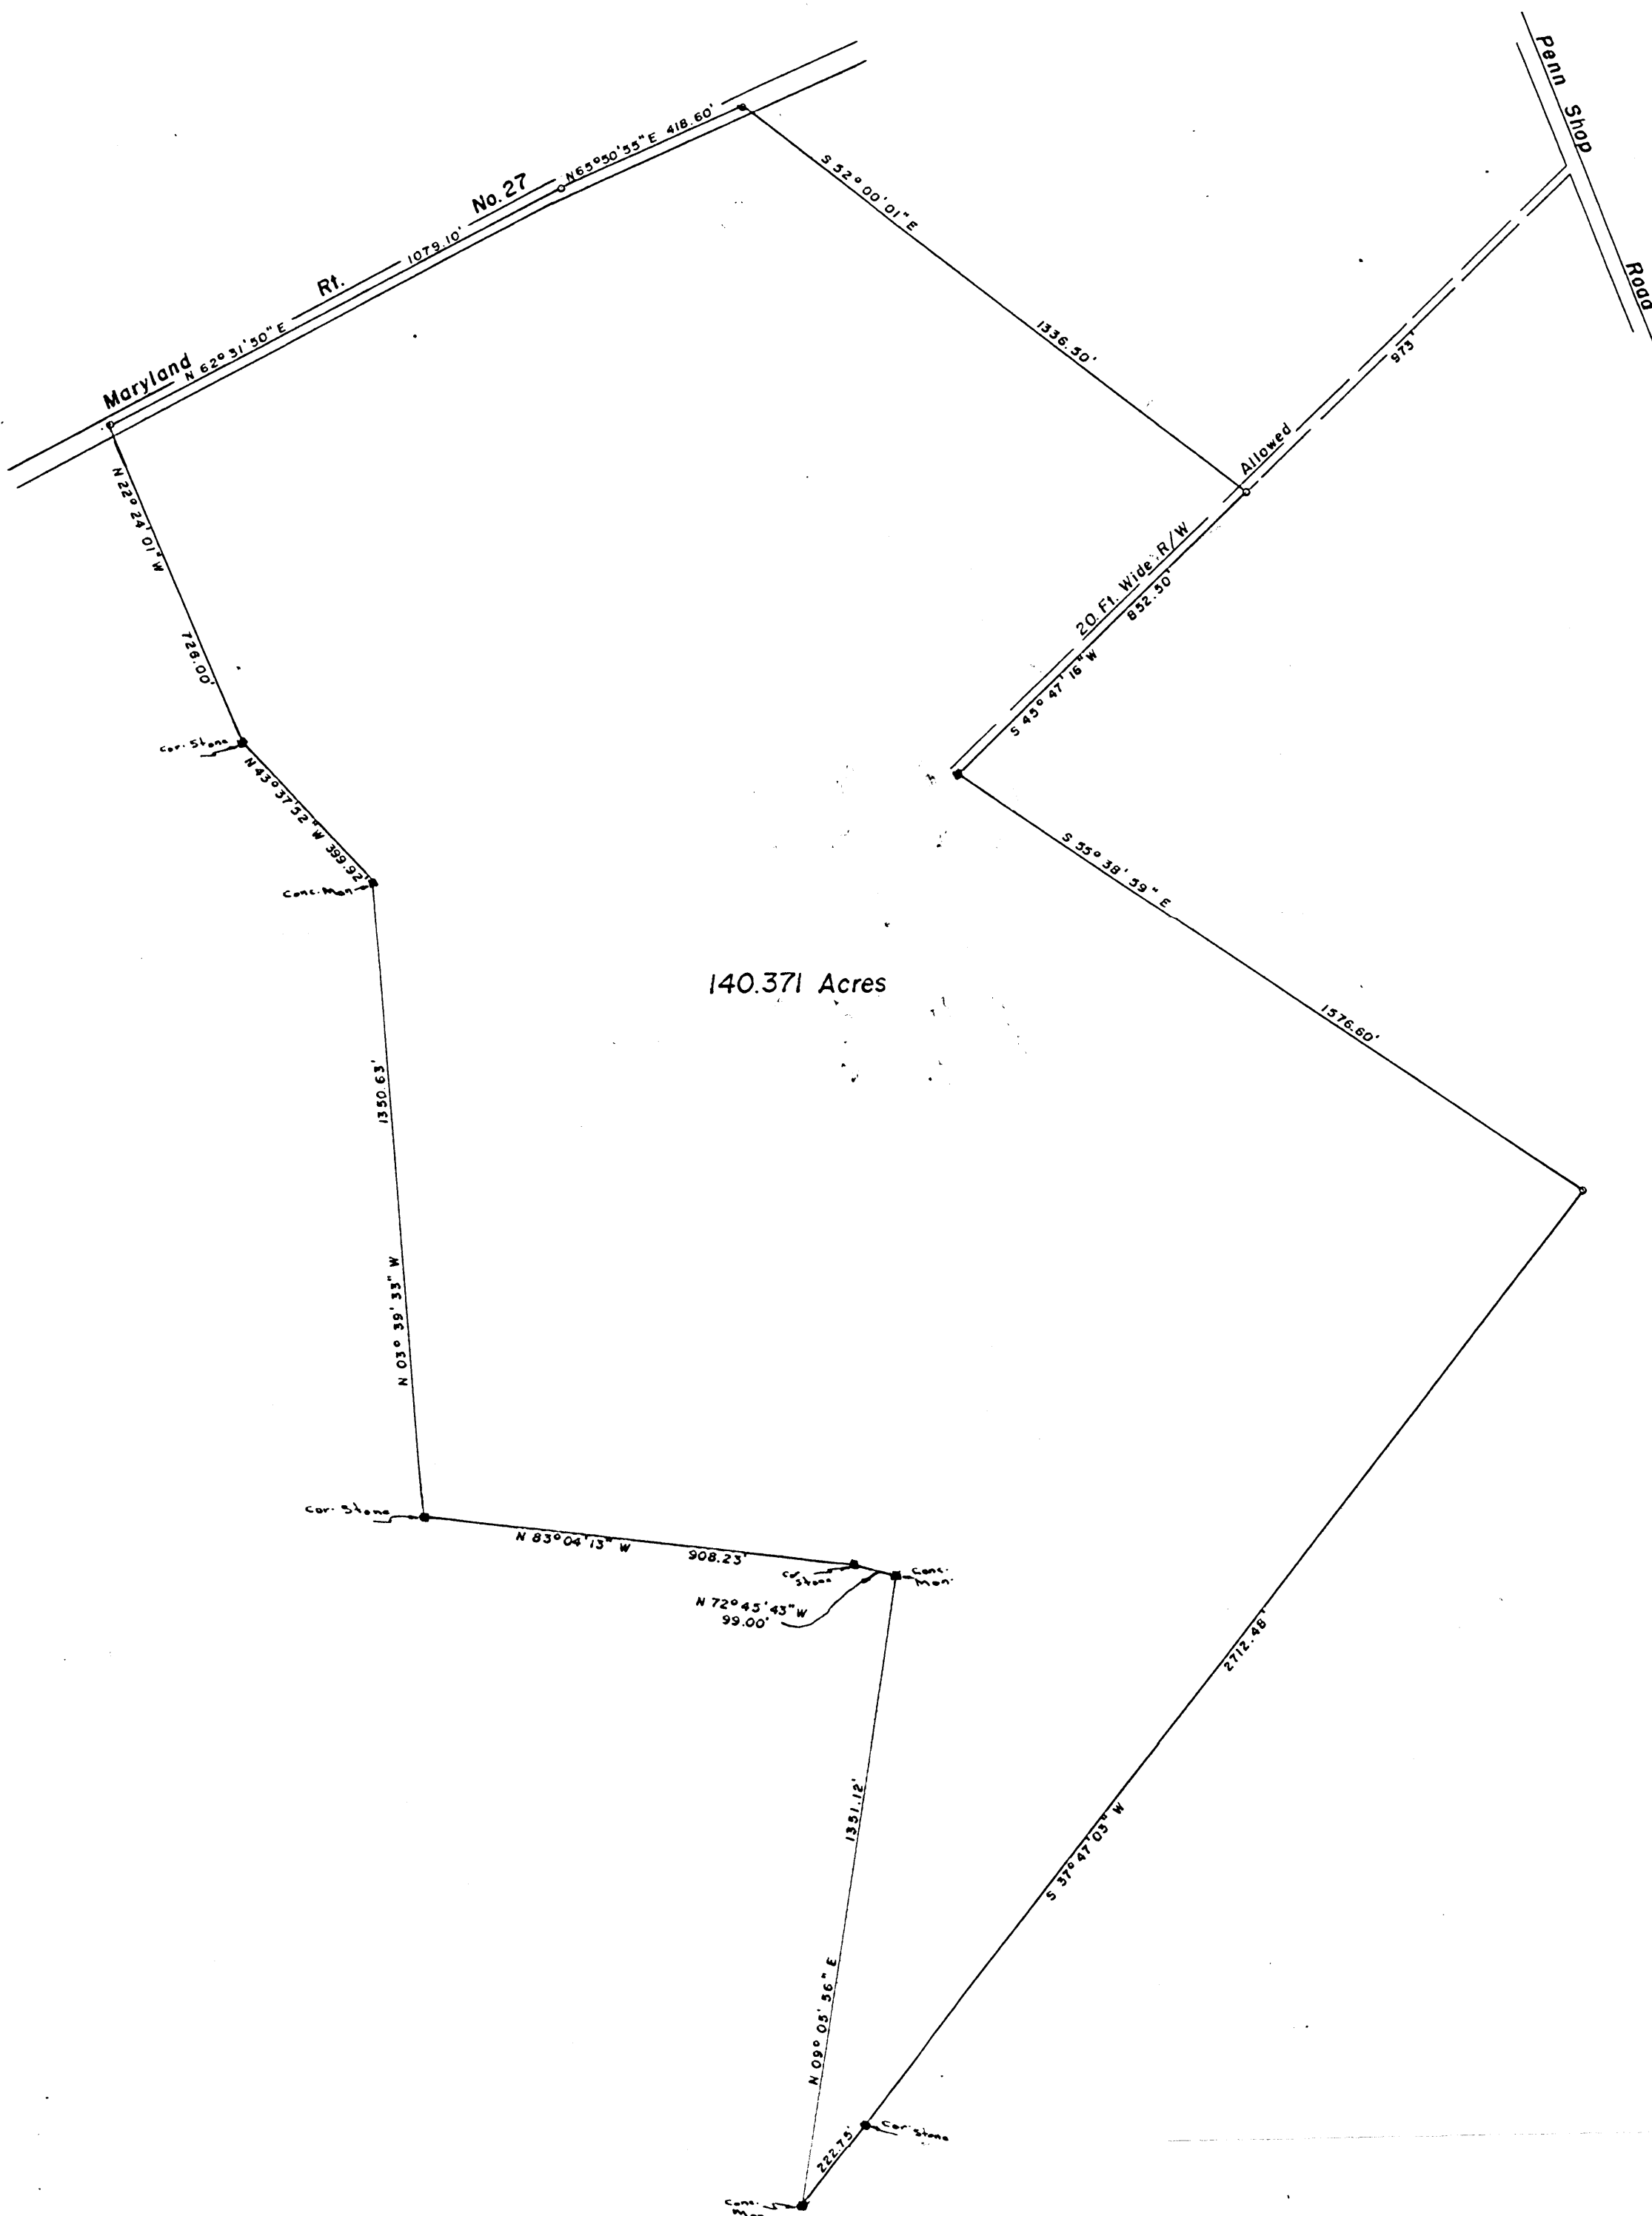

PLAT OF SURVEY
FOR
BENJAMIN F. CLEMENTS
FOURTH ELECTION DISTRICT OF HOWARD COUNTY
MT. AIRY, MARYLAND
SCALE: 1 IN. = 300 FT. AUGUST 7, 1970

Claude M. Skinner Jr.
Claude M. Skinner Jr. Reg. Engineer & Land Surveyor No. 2237

