

APPLICATION

PERCOLATION TESTING

A 38837

P _____

HOWARD COUNTY HEALTH DEPARTMENT
BUREAU OF ENVIRONMENTAL HEALTH
P.O. BOX 476 ELLICOTT CITY, MARYLAND 21043
TELEPHONE: 461-9933

DISTRICT _____

DATE 2/26/87

5-25-87
perks ok pending
plat approval JEN

Sheet 1 of 2

TO: THE COUNTY HEALTH OFFICER
ELLICOTT CITY, MARYLAND

I HEREBY APPLY FOR THE NECESSARY TEST IN ORDER TO CONSTRUCT (OR RECONSTRUCT) A SEWAGE DISPOSAL SYSTEM.

PROPERTY OWNER Royden A. Blunt VINTAGE HOMESTEADS 551-3047
c/o F.A.M. Equities, Inc. 233 E. Redwood Street.
ADDRESS Baltimore, MD 21202 PHONE _____

PROSPECTIVE BUYER F.A.M. Equities, Inc.
ADDRESS 802 Garrett Bldg., 233 E. Redwood Street
Baltimore, MD 21202 PHONE 301-685-8588

PROPERTY LOCATION: Intersection of Rt. 32 and Folly Quarter Road LOT 3 on Prelim

SUBDIVISION Ridgewood LOT NO. 2

ROAD AND DESCRIPTION Public CT. A and CT. B
13303 Springwood Dr.

TAX MAP 22 PARCEL # 160

SIZE OF LOT 3.0 AC TYPE BLDG. Single Family
(SINGLE FAMILY DWELLING OR COMMERCIAL)

THE SYSTEM INSTALLED UNDER THIS APPLICATION IS ACCEPTABLE ONLY UNTIL PUBLIC FACILITIES BECOME AVAILABLE. I FULLY UNDERSTAND THE

FEE CONNECTED WITH THE FILING OF THIS PERG-TEST APPLICATION IS NON-REFUNDABLE UNDER ANY CIRCUMSTANCES. I ALSO AGREE TO COMPLY

WITH ALL M.O.S.H.A. REQUIREMENTS IN TESTING THIS LOT. Wigand H. Theimer (Agent for FAM Eq.)
(SIGNATURE OF APPLICANT)

APPROVED BY B. Nixon FOR Shallow system only DATE 10/27/87

REJECTED BY _____ FOR _____ DATE _____

HOLD PENDING FURTHER TESTS _____ DATE _____

REASONS FOR REJECTION OR HOLDING for field located holes and subdivision plat

BUDG. PERMIT SIGNED

AND RETURNED 4/28/89
Serial # 24890
570 gal. propellant

BUDG. PERMIT SIGNED

AND RETURNED 12-15-88

6129855

THIS IS NOT A PERMIT

~~INLET 3k~~
~~MAX 5k~~
174 6/BD

SOIL PROFILE


0-2.0'	Brown sil cl 1m
2.0'-3.0'	Rd br sil cl 1m, < 30% broken schist
3.0'-	Refusal

(A)

0-3.5' Br sil lm
3.5'-11.0' Rd br sil
lm, < 10%
saprolite
11.0' Bottom

B

0-4.5 Rd br cl
sl lm
4.5-11.0 Br-yellow
micaceous
sl lm,
L 20%
saponite
11.0/ Bottom

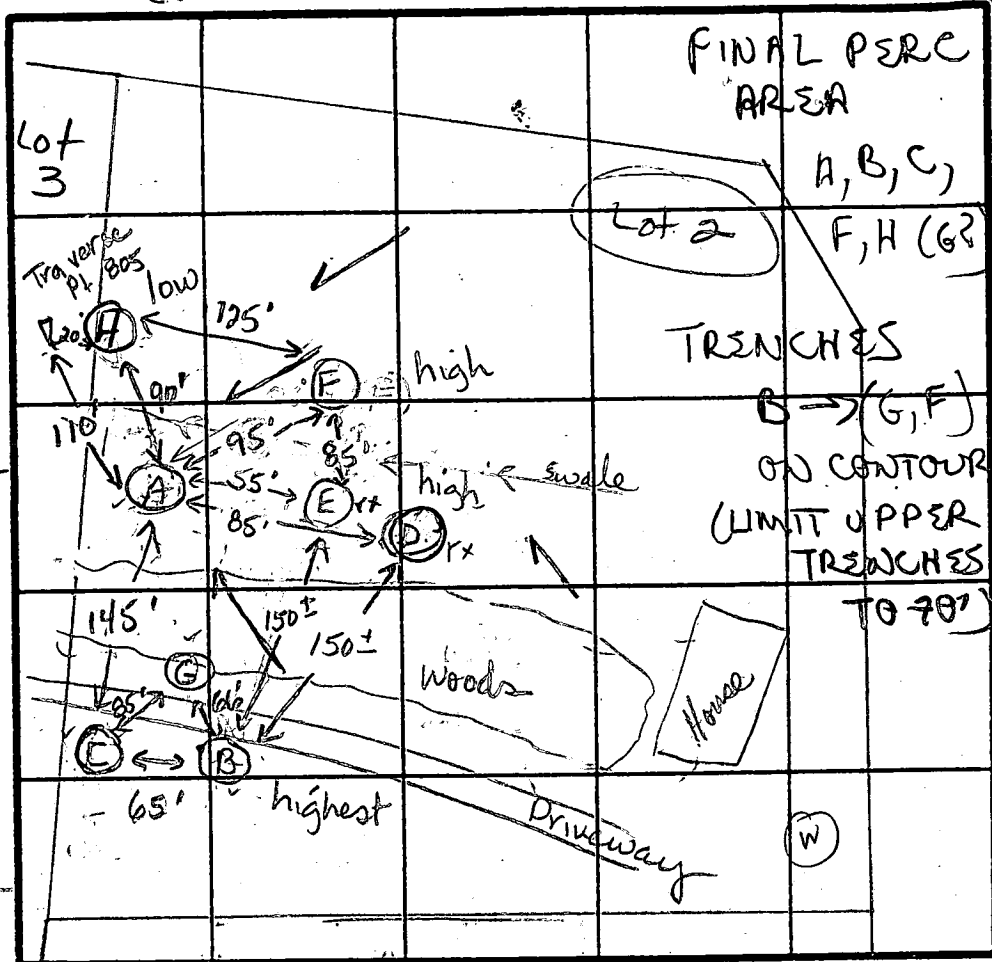

INDICATE NORTH - NAME ADJOINING ROADWAY AS BASE LINE

FOLLY QUARTER ROAD

DATE	TEST NO.	DEPTH	PRE-WET		TEST - 1" DROP		TIME
			START	STOP	START	STOP	
5-26-87	D	8.0' V	bottom (see profile)				
	A	3.0' S	11:04	11:06	11:06	11:08	2 min
		7.0' M	11:05	11:07	11:07	11:09	2 min
		11.0' D	bottom (see profile)				
	B	3.5' S	11:15	11:17	11:17	11:19	2 min
		7.0' M	11:15	11:17	11:17	11:19	2 min
		11.0' D	bottom (see profile)				
	C	3.5' S	11:23	11:25	11:25	11:27	2 min
		11.5' D	bottom (see profile)				
	E	8.5' V	bottom (see profile)				

REMARKS

REMARKS (B) moved 30' up slope, (A) moved 50' down slope (D) moved 40' up slope
from orig. A. (C) As located on plat. (E)(F)(G)(H) new locations
TYPE OF SOIL Br si cl lm; rd br si sa lm, Br-gray si sa lm & 30% saprolite.

TESTED BY

J. Nordmann / BN

ALSO PRESENT

Jeff & Chris, Jeff (eng)

APPLICATION

PERCOLATION TESTING

A 38837

P _____

HOWARD COUNTY HEALTH DEPARTMENT
BUREAU OF ENVIRONMENTAL HEALTH
P.O. BOX 476 ELLICOTT CITY, MARYLAND 21043
TELEPHONE: 461-9933

DISTRICT _____

DATE 2-26-87

sheet 2 of 2

TO: THE COUNTY HEALTH OFFICER
ELLICOTT CITY, MARYLAND

I HEREBY APPLY FOR THE NECESSARY TEST IN ORDER TO CONSTRUCT (OR RECONSTRUCT) A SEWAGE DISPOSAL SYSTEM.

PROPERTY OWNER _____

ADDRESS _____ PHONE _____

PROSPECTIVE BUYER _____

ADDRESS _____ PHONE _____

PROPERTY LOCATION:

SUBDIVISION Ridgewood LOT NO. 2

ROAD AND DESCRIPTION _____

TAX MAP _____ PARCEL # _____

SIZE OF LOT _____ TYPE BLDG _____
(SINGLE FAMILY DWELLING OR COMMERCIAL)

THE SYSTEM INSTALLED UNDER THIS APPLICATION IS ACCEPTABLE ONLY UNTIL PUBLIC FACILITIES BECOME AVAILABLE. I FULLY UNDERSTAND THE
FEE CONNECTED WITH THE FILING OF THIS PERC TEST APPLICATION IS NON-REFUNDABLE UNDER ANY CIRCUMSTANCES. I ALSO AGREE TO COMPLY
WITH ALL M.O.S.H.A. REQUIREMENTS IN TESTING THIS LOT.

(SIGNATURE OF APPLICANT)

APPROVED BY _____ FOR _____ DATE _____

REJECTED BY _____ FOR _____ DATE _____

HOLD PENDING FURTHER TESTS _____ DATE _____

REASONS FOR REJECTION OR HOLDING _____

HD-216

THIS IS NOT A PERMIT

Lot 2

(F)

SOIL PROFILE

0-3.0' Br si lm
 3.0-4.0 Yellow br
 sa si lm
 trc schist
 4.0-11.0 Br-gray
 si sa lm
 <10%
 saprolite
 11.0 Bottom


(G)

0-4.5' Rd si cl lm

4.5-7.0 Rd si sa
 lm

7.0-11.5 Br sa si
 lm, <10%
 saprolite

11.5 Bottom

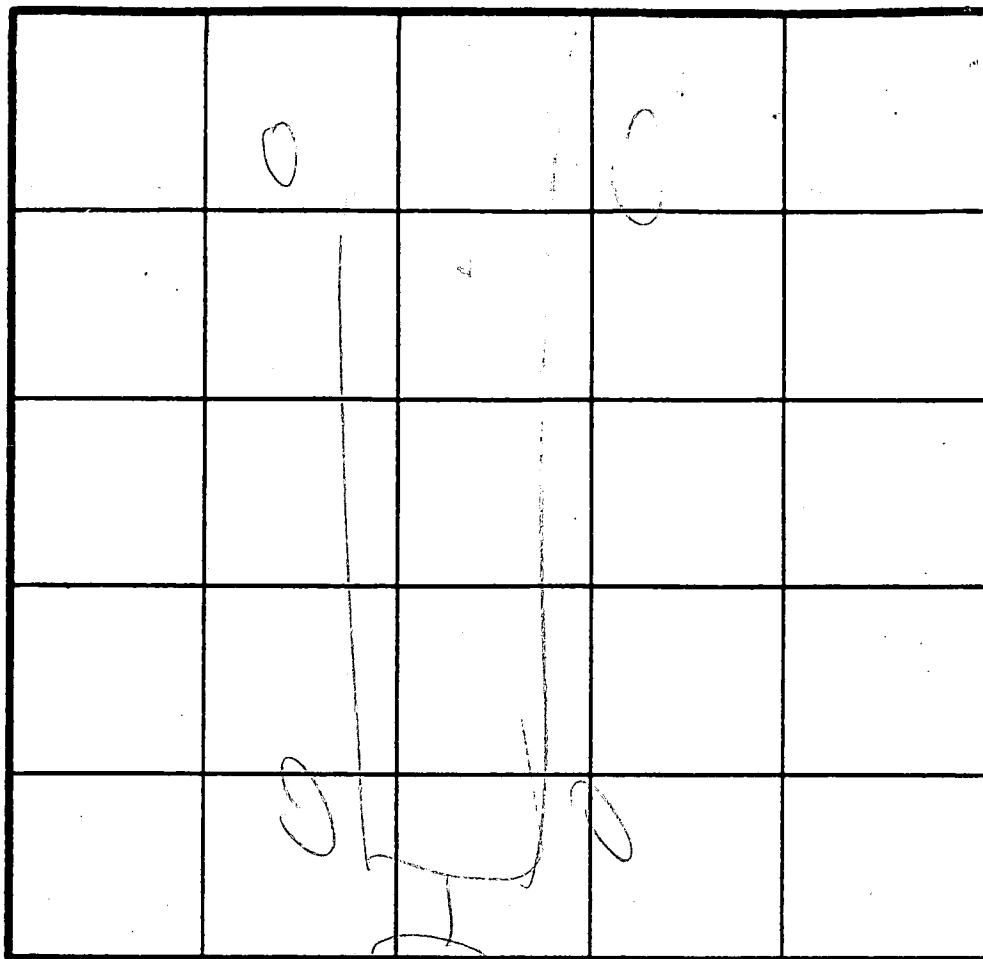

INDICATE NORTH - NAME ADJOINING ROADWAY AS BASE LINE.

(H)

0-4.0' Dk br si
 cl lm
 4.0-6.0' Rd br sa
 si lm
 6.0-12.6' Br si sa
 lm, <10%
 Saprolite
 12.6' Bottom

DATE	TEST NO.	DEPTH	PRE-WET		TEST - 1" DROP		TIME
			START	STOP	START	STOP	
5-25-87	F	3.0' S	12:00	12:02	12:02	12:04	2 min
		11.0' D	bottom	(see profile)			
	G	11.5' V	bottom	(see profile)			
	H	12.6' V	bottom	(see profile)			

ok

ok

ok

REMARKS _____

TYPE OF SOIL _____

TESTED BY _____ ALSO PRESENT _____