



Bureau of Environmental Health

8930 Stanford Boulevard, Columbia, MD 21045

Main: 410-313-2640 | Fax: 410-313-2648

TDD 410-313-2323 | Toll Free 1-866-313-6300

www.hchealth.org

Facebook: www.facebook.com/hocohealth

Twitter: HowardCoHealthDep

Dr. Maura J. Rossman, M.D., Health Officer

INFORMATION FORM - SEPTIC SYSTEM REPAIR/UPGRADE

Reason for Request:

- ☒ Failing System
- ☐ System relocation for proposed addition
- ☐ System upgrade for proposed addition
- ☐ Inadequate treatment zone
- ☐ Collapsed septic tank
- ☐ Collapsed drywell

Has the septic tank been pumped within the last month?

- ☒ Yes Date pumped: _____
- ☐ No

Was a visual inspection of the septic tank and/or drain fields conducted?

- ☒ Yes Explain observations: _____
- ☐ No

Existing system design

- ☐ Drywell
- ☒ Trench
- ☐ Mound
- ☐ Unknown
- ☐ Other: _____

Was a visual inspection of the sewage line conducted?

- ☒ Yes
 - Blockage leading to the tank
 - ☐ Yes. Explain: _____
 - ☐ No
 - Blockage leading to the field
 - ☐ Yes. Explain: _____
 - ☐ No
- ☐ No

Is discharge surfacing on the ground?

- ☐ Yes
- ☒ No

Additional Comments: Parked by Sara

*For REPAIRS, are the owners proposing, or do they plan to add in the future, any additions or modifications to the property, i.e. pools, living space additions, garages, etc? This information must be disclosed at the time of this application. The Health Department will not be able to accommodate requests in the field for property modifications unrelated to the repair request. Such requests may require an additional fee, testing, and submittal of a Percolation Certification Plan, if the property does not meet current Code and Regulation.

Septic Contractor: Hatfield's Equipment Contractor's Phone: 301 490 4289
Contractor's Address: PO Box 519 Annapolis Junction MD 20701

Property Address: 8536 Reservoir Rd County file: _____
Subdivision: _____ Lot: _____ Year Built: _____
Owner's Name: Charles Lyons Owner's Phone: _____

Name of previous owners: _____ Existing bedrooms: 4
Proposed bedrooms: _____

Has this request been previously discussed with a Sanitarian? (Name): Sara
Public Sewer available/nearby: _____

*A Sanitarian will be in contact within three business days, depending upon the urgency of the situation, to coordinate the scheduling/review of the repair or upgrade.

Prior to scheduling inspections, scaled plans should be submitted to clarify the nature of the addition.

Print out a copy of Real Property Data via Dept. of Taxation website _____ Indexed file found _____

If public sewer may be nearby, verify whether sewer is technically "available" through the Bureau of Engineering.

If sewer is available and the property is within the Metropolitan District, connection to sewer is required. If the owner believes reason for exemption exists, the owner should justify the request in writing.


If soil/site conditions are limited and sewer and/or Metro District status is not conducive to connection, the Sanitarian may recommend pursuit of Emergency Sewer Extension or Emergency Metro District Inclusion. The Owner should contact the Bureau of Utilities for details.

No permit is to be issued nor inspection to be scheduled without prior fee collection at the office unless an emergency situation exists. The contractor is to notify office of the emergency situation as soon as possible.

A/P

0' (A)
 8" brn loam
 rocky, roots
 old driveway
 stone + stone
 dust
 2' yel brn sct
 mica
 dense
 4' red brn fst
 weak platy
 many mica
 pockets of
 yel brn sct
 "8-10" on
 NW side of hole
 roots
 14.5'

0' (B)
 8" dk brn loam
 msbk, roots
 yel brn sct
 roots
 4' red brn fst
 weak platy
 many mica
 10% rock
 roots
 consistent
 ↓
 13.5'

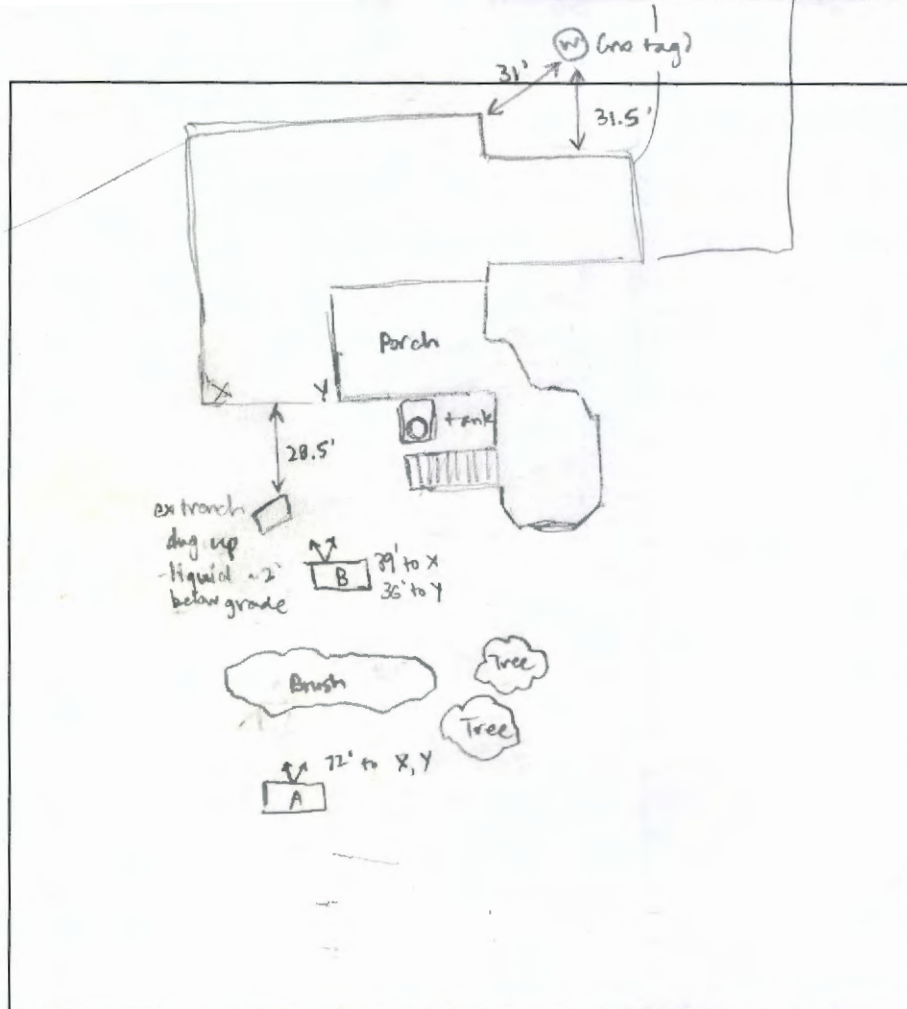

DATE	TEST #	DEPTH	START	BREAK 1" DROP	STOP 2" DROP	TIME OF 2ND INCH	P/F/H
1/3/19	A	6' / 14.5'	0:00	4:50	13:15	8:25	P
		H ₂ O poured at bottom				10-15 mins/ inch	
	B	13.5'	(visual)				

REMARKS

SANITARIAN Sarah Collins BACKHOE Dorothy Simpson OTHERS Todd Tracy, helpers ~ 2
 TEST HOLES USED IN SDA A, B AVG. PERC TIME 8:25 SQ. FT/BR 4 BR
 TRENCH WIDTH 2' INLET DEPTH 4' MAX. BOT DEPTH 10' EFFECTIVE SW at 4'



HOWARD COUNTY HEALTH DEPARTMENT

64094

P5

DATE 12/13/18

Received From

Hatfield's Equipment

PHONE #

301-490-487

For

Septic Repair (PERC)

8536 Reservoir Rd.

☐ CASH

☒ CHECK

NO.

4020

One Hundred Sixty Five

Dollars

\$

165.00

Received By

Shah Beatty