DEPARTMENT OF INSPECTIONS, LICENSES AND PERMITS 3430 COURT HOUSE DRIVE ELLICOTT CITY, MO 21043 PERMITS (410) 313-3458 INSPECTIONS (410) 313-3810 AUTOMATED INFORMATION (410) 313-3800

Distribution of Copies-

T:Vorms\PERMIT.FRM

White: Building Official

Green: LDD, DPZ

HOWARD COUNTY PERMIT APPLICATION

PERMIT NUMBER

	1 -1 (14)11 / (1	00 1000	
Building Address 12207	RICLAUD GOR	Property Owner's Name WITTIN	E + ELEABATH
HOUARD COUTY 21047		Address 12207 RALLAND COURD	
Suite/Apt. #: SDP/WP/Pet	tition #:		
Census Tract Subdivision	was mark	City House Con VIII State MD Zip Code 21647	
Section Area		Home Phone 40 53/564/ Work Phone Applicant's Name & Mailing Address, (if other than stated hereon):	
Tax Map Parcel	Grid	*	,
Zoning Map Coordinates Lot size		Phone Fax	
Existing Use Have DECK Proposed Use DECK		Contractor Company KoBS Hone	
Proposed Use DECK Estimated Construction Cost \$ /6 000 %		Contact Person Ros RINEMAN	
Description of Work REMOVE OUS DECK			
FRUIT OF HOISE BEED NEW		Address 26 MACTUTOSH CT	
DECK 16x12' 4 STEPS		City BACTAMORS State My Zip Code 2/220 License No. 85657	
BACK DECK 12×34 4 STERS		Phone 4/0 39/ 6776 Fax 4 SAUF	
Occupant or Tenant Home OWNER		Engineer or Architect Company	
Contact Name BETSY BA		Contact Person	
Address 12207 RILLA City Hoursell Cost T State 1		Address	
City HowARD Court State MD Zip Code 21047		City State Zip Code	
Phone 410 531-564 Fax		Phone Fax	
BUILDING DESCRIPTION - COMMERCIAL		BUILDING DESCRIPTION - RESIDENTIAL	
Building Characteristics	Utilities	Building Characteristics	Utilities
Height:	Water Supply:	SF Dwelling	Water Supply:
No. of stories:	Private	Depth Width 1st floor:	Public Private Sewage Disposal:
Gross area, sq. ft, per floor:	Sewage Disposal: Public	2nd floor: Basement:	Private
Gross area, sq. it. per moor:	Private Electric Yes □ No □	Finished Basement ☐ Unfinished Basement☐ Crawl space ☐ Slab on Grade ☐	Electric Yes No
Use group:	Gas Yes D No D	No. of Bedrooms Height: Multi-family dwellings:	Gas Yes□ No□
Construction type:	Heating System:	No. of efficiency units: No. of 1 BR units:	Heating System: Electric □ Oil □
Reinforced Concrete Structural Steel	Natural Gas □ Propane Gas □	No. of 2 BR units: No. of 3 BR units:	Natural Gas ☐ Propane Gas ☐
Masonry Wood Frame	Sprinkler system: N/A	Other Structure: Dimensions:	Sprinkler system: N/A
- Vissa Framo	Full Partial	Footings: Roof Height:	NFPA #13D NFPA #13R Other:
State Certified Modular	Other Suppression # of Heads	State Certified Modular	ouler.
THE UNDERSIGNED HEREBY CERTIFIES AND AGREES AS FOLLOWS: HOWARD COUNTY WHICH ARE PPLICABLE THERETO (4) THAT HER THE RIGHT TO ENTER CAUSE MANDENDED TO SERVE THE PROPERTY OF	(1) THAT HE/SHE IS AUTHORIZED TO MAKE THIS API SHE-MALL PERFORM NO WORK ON THE ABOVE REFI	PLICATION; (2)THAT THE INFORMATION IS CORRECT; (3) THAT HE/SHE ERENCED PROPERTY OUT SPECIFICALLY DESCRIBED IN THIS APPLICAT NOTICES	ION; (5) THAT HE/SHE GRANTS COUNTY OFFICIALS
Twent !	INSPECTING THE WORK PERMITTED AND POSTING	LOBERT KINE	intr
Applicant's Signature De Hour July	ACCOUNT IN/C	Print Name	1-10-0)
I file/Company	Checks payable to: DIRECTOR O	Date OF FINANCE OF HOWARD COUNTY EATLY AND LEGIBLY.**	
AGENCY DATE		CE USE ONLY - DPZ SETBACK INFORMATION	PROPERTY ID#:
Land Development, DPZ		Front: Filin	g fee \$
State Highways Building Official	1		mit fee \$ise tax \$
Dev. Engineering, DPZ	MOL		ise tax \$
Health 1/10/07	MUA! HER		TAL FEES \$
Fire Protection			-total paid \$
is Sediment Control approval required prior to it	ssuance?	Is Entrance Permit required? Bala	ance due \$
YES NO			
		YES NO D Che	STEEL
CONTINGENCY CONSTRUCTION	I START:		dation #

SDP/Red-line approval date


Pink: Health

Yellow: DED, DPZ

Accepted by___

Rev. 11/4//04

Gold: SHA

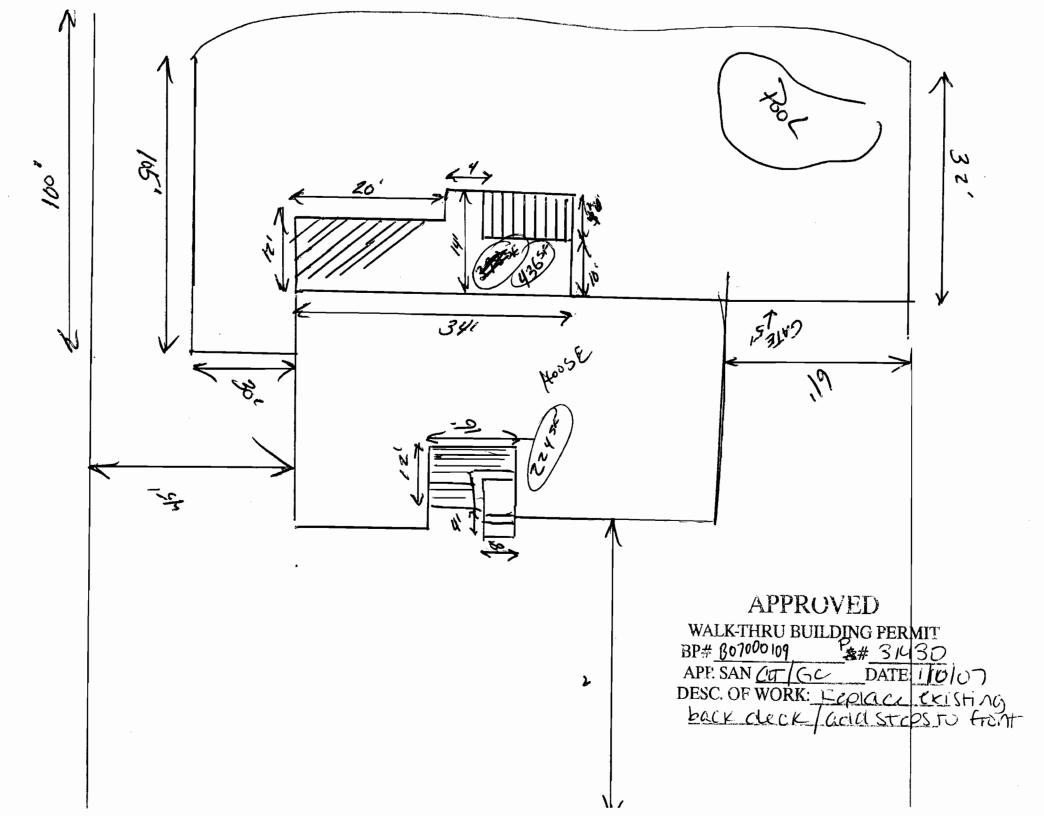

officeral lines Lunch

PERMIT. Sytil

Approxis 1-9-3-3/4

18410

SEWAGE DISPOSAL SYSTEM

MARYLAND STATE DEPARTMENT OF HEALTH'

HOWARD COUNTY

Inderted

DATE 6/12/81

	Thomas G. Harris	IS PERMITTED TO INSTAL	ALTER
DDRESS_	Box 6, Monkton, Maryland 21111	PHONE1	72-4613
OISIVIGEU	NWoodmark	ROAD_12207 Rilland Court	LOT 32. Blk F.,
ROPERTY	OWNERShelley & Price		
DDRESS_	529 Gifford Lane, Fonkton, Ma	ryland 21111	
PECIFICATIO	ns 4 Bedrooms		÷.
	SEPTIC TANK CAPACITY 1250 GALLONS		4.
	DRAIN FIELD DEPTH FEET, BOTT	OM AREASQ. FT.	
	DEEP TRENCH DEPTH FEET, BOTT	TOM AREA SQ. FT.	
Well	SEEPAGE PITS X ABSORBENT SIDE-WALL AR	EA 125 SO. FT. Per bedroom	/-
	INLET PIPE FT. BELOW ORIGINAL GRADE,	MAXIMUM DEPTH <u>8</u> FT. BELOW ORIGINA	L GRADE ZID
	EFFECTIVE DEPTH AT5_FT. BELOW ORIGINAL	L GRADE.	
	LOCATE DISPOSAL AREA 10 FT. FROM 10	FL LOT LINE AND 280 FT. FROM	rcar corner point Notune astronom es
	FACINICULTEROM (Perc Hole 1 & 2) when facing lot from Pillard	Court.
NO.	The second secon		to other considerations
NOT	E: OKAY TO USE TRENCH OFF DPY WEL	at to make the mandragery sideman	di ARIGA IN SYSTEM.
	en a company of the contract o		
E 5 FT.	EARTH BUFFER DETWIEN TRENCH AND D	DRY WELL. TREMEN TO FOLLOW CON	TOUR OF THE LAND.
/E_5_FT.		RY WELL. TREMEN TO FOLLOW CON	TOUR OF THE LAND.
FOR 2	EARTH BUFFER DETVICEN TRENCH AND D INSPECTIONS - BEFORE AND AFTER GRA	The state of the s	TOUR OF THE LAND.
E 5 FF.	INSPECTIONS - BEFORE AND AFTER GFA	The state of the s	Li Li Trad Junuar II
FOR 2	INSPECTIONS - BEFORE AND AFTER GFA	vol is installed.	Li Li Trad Junuar II
	INSPECTIONS - BEFORE AND AFTER GFA	vol is installed.	ili un tradiția un ili. Lifetia vara
ANS APP	INSPECTIONS - BEFORE AND AFTER GFA	OATE	ili ile Tedd (dum) - Millay dra
ANS APP	INSPECTIONS - BEFORE AND AFTER GFA	VIL IS INSTALIAD. DATE	1.5
ANS APP	ROVED BY C. B. Streaker	DATE	1.5
ANS APP	INSPECTIONS - BEFORE AND AFTER GFA ROVED BY ORK UNTIL INSPECTED AND APPROVED. HOWARD COUNTY COUNCIL NOR THE HEALTH DEPART	DATE	1.5
ANS APP	ROVED BY C. B. Streaker ORK UNTIL INSPECTED AND APPROVED. HOWARD COUNTY COUNCIL NOR THE HEALTH DEPART RENCH IS USED CALL FOR INSPECTION BEFORE PLACE	DATE TMENT IS RESPONSIBLE FOR THE SUCCESSFUL OR GRAVEL IN TRENCH.	1.5
ANS APP OVER NO WI THER THE OTE: IF TO OTE: NO	TUSPECTIONS - BEFORE AND DETER GEA ROVED BY ORK UNTIL INSPECTED AND APPROVED. HOWARD COUNTY COUNCIL NOR THE HEALTH DEPART RENCH IS USED CALL FOR INSPECTION BEFORE PLACE DRY WELL SHALL EXCEED 15 FOOT IN DIAMETER.	DATE TMENT IS RESPONSIBLE FOR THE SUCCESSFUL OR GRAVEL IN TRENCH.	1.5
ANS APP DVER NO WI SITHER THE DTE: IF TO DTE: NO DTE: ALL SRMIT VOID	C. B. Stierker ROVED BY C. B. Stierker ORK UNTIL INSPECTED AND APPROVED. HOWARD COUNTY COUNCIL NOR THE HEALTH DEPART RENCH IS USED CALL FOR INSPECTION BEFORE PLACH DRY WELL SHALL EXCEED 15 FOOT IN DIAMETER. PIPE FROM HOUSE TO DISPOSAL AREA MUST BE CAST AFTER THREE YEARS.	DATE DATE THENT IS RESPONSIBLE FOR THE SUCCESSFUL COORDINATE OF THE SUCC	CONTRACTOR OF ANY SYSTEM OF ANY SYSTEM
LANS APP DVER NO WE EITHER THE DTE: IF T DTE: NO DTE: ALL ERMIT VOID DTE: INS	C. B. Streaker ORK UNTIL INSPECTED AND APPROVED. HOWARD COUNTY COUNCIL NOR THE HEALTH DEPART RENCH IS USED CALL FOR INSPECTION BEFORE PLACIF DRY WELL SHALL EXCEED 15 FOOT IN DIAMETER. PIPE FROM HOUSE TO DISPOSAL AREA MUST BE CAST AFTER THREE YEARS. TALL STAND PIPE ON SEPTIC TANK AND DRY WELL STAN	DATE DATE THENT IS RESPONSIBLE FOR THE SUCCESSFUL COORDINATE OF THE SUCC	CONTRACTOR OF ANY SYSTEM OF ANY SYSTEM
ANS APP DVER NO WE EITHER THE DTE: IF TO DTE: ALL ERMIT VOID DTE: INS	TIISPECTIONS - BEFORE AND AFTER GFA C. B. Streaker ORK UNTIL INSPECTED AND APPROVED. HOWARD COUNTY COUNCIL NOR THE HEALTH DEPART RENCH IS USED CALL FOR INSPECTION BEFORE PLACIF DRY WELL SHALL EXCEED 15 FOOT IN DIAMETER. PIPE FROM HOUSE TO DISPOSAL AREA MUST BE CAST AFTER THREE YEARS. TALL STAND PIPE ON SEPTIC TANK AND DRY WELL STAN TAL ACCEPTED.	DATE TMENT IS RESPONSIBLE FOR THE SUCCESSFUL C NG GRAVEL IN TRENCH. T IRON. ND PIPES MUST BE 6 INCHES IN DIAMETER. CAST	CONCRETE OR TERR
LANS APP DVER NO WE EITHER THE OTE: IF TO OTE: ALL ERMIT VOID OTE: INS	C. B. Streaker ORK UNTIL INSPECTED AND APPROVED. HOWARD COUNTY COUNCIL NOR THE HEALTH DEPART RENCH IS USED CALL FOR INSPECTION BEFORE PLACIF DRY WELL SHALL EXCEED 15 FOOT IN DIAMETER. PIPE FROM HOUSE TO DISPOSAL AREA MUST BE CAST AFTER THREE YEARS. TALL STAND PIPE ON SEPTIC TANK AND DRY WELL STAN	TAINING FINAL APPROVAL O	PERATION OF ANY SYSTEM TRON, CONCRETE OR TERR.
LANS APP OVER NO WE EITHER THE OTE: IF TO OTE: ALL ERMIT VOID OTE: INS	TIISPECTIONS - BEFORE AND AFTER GFA C. B. Streaker ORK UNTIL INSPECTED AND APPROVED. HOWARD COUNTY COUNCIL NOR THE HEALTH DEPART RENCH IS USED CALL FOR INSPECTION BEFORE PLACIF DRY WELL SHALL EXCEED 15 FOOT IN DIAMETER. PIPE FROM HOUSE TO DISPOSAL AREA MUST BE CAST AFTER THREE YEARS. TALL STAND PIPE ON SEPTIC TANK AND DRY WELL STAN TAL ACCEPTED.	TAINING FINAL APPROVAL O	PERATION OF ANY SYSTEM FIRON, CONCRETE OR TERRA N THIS PERMIT.
LANS APP OVER NO WE EITHER THE OTE: IF TO OTE: ALL ERMIT VOID OTE: INS	C. B. Streaker ORK UNTIL INSPECTED AND APPROVED. HOWARD COUNTY COUNCIL NOR THE HEALTH DEPART RENCH IS USED CALL FOR INSPECTION BEFORE PLACE DRY WELL SHALL EXCEED 15 FOOT IN DIAMETER. PIPE FROM HOUSE TO DISPOSAL AREA MUST BE CAST AFTER THREE YEARS. TALL STAND PIPE ON SEPTIC TANK AND DRY WELL STAN TA ACCEPTED. ALLER IS RESPONSIBLE FOR OBT	TAINING FINAL APPROVAL O	PERATION OF ANY SYSTEM OF THE CONCRETE OR TERRA N THIS PERMIT.
LANS APP OVER NO WE EITHER THE OTE: IF TO OTE: ALL ERMIT VOID OTE: INS	TIISPECTIONS - BEFORE AND AFTER GFA C. B. Streaker ORK UNTIL INSPECTED AND APPROVED. HOWARD COUNTY COUNCIL NOR THE HEALTH DEPART RENCH IS USED CALL FOR INSPECTION BEFORE PLACIF DRY WELL SHALL EXCEED 15 FOOT IN DIAMETER. PIPE FROM HOUSE TO DISPOSAL AREA MUST BE CAST AFTER THREE YEARS. TALL STAND PIPE ON SEPTIC TANK AND DRY WELL STAN TAL ACCEPTED.	TAINING FINAL APPROVAL O	PERATION OF ANY SYSTEM IRON, CONCRETE OR TERRA N THIS PERMIT. Y SIGNED ED 6/29/84
LANS APP OVER NO WI IEITHER THE IOTE: IF TI IOTE: NO IOTE: ALL ERMIT VOID IOTE: INS	C. B. Streaker ORK UNTIL INSPECTED AND APPROVED. HOWARD COUNTY COUNCIL NOR THE HEALTH DEPART RENCH IS USED CALL FOR INSPECTION BEFORE PLACE DRY WELL SHALL EXCEED 15 FOOT IN DIAMETER. PIPE FROM HOUSE TO DISPOSAL AREA MUST BE CAST AFTER THREE YEARS. TALL STAND PIPE ON SEPTIC TANK AND DRY WELL STAN TA ACCEPTED. ALLER IS RESPONSIBLE FOR OBT	TAINING FINAL APPROVAL O	PERATION OF ANY SYSTEM FIRON, CONCRETE OR TERR. N THIS PERMIT.