



PLAN
SCALE: 1"=50'

SLOPES, MODERATELY ERODED.
DERATELY ERODED.

APPROVED: FOR PRIVATE WATER AND PRIVATE SEWER
SYSTEMS, HOWARD COUNTY HEALTH DEPARTMENT.

COPY OF APPROVED DRAWING



ORIGINAL RECORD PLAT SENT
1/25/11 FOR SIGNATURE

COUNTY HEALTH OFFICER

DATE

SITE PLAN

VICINITY MAP

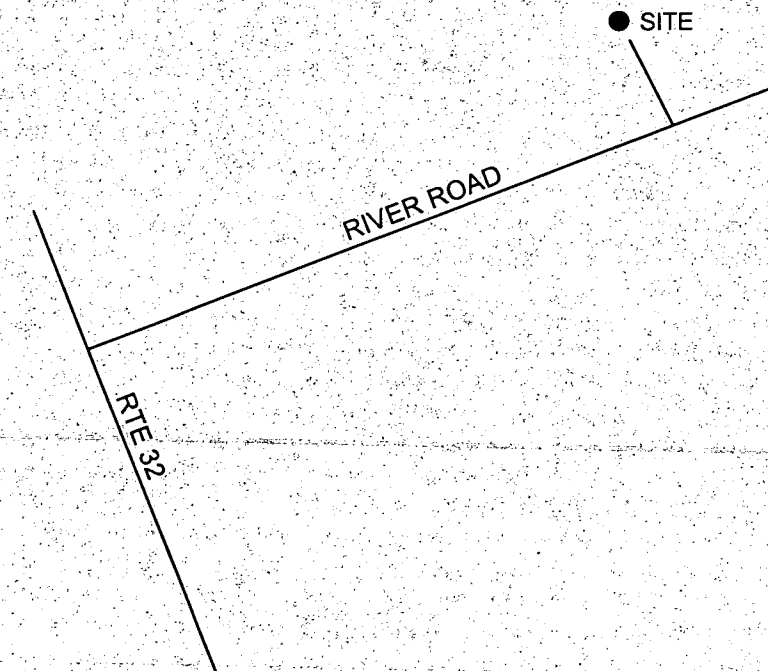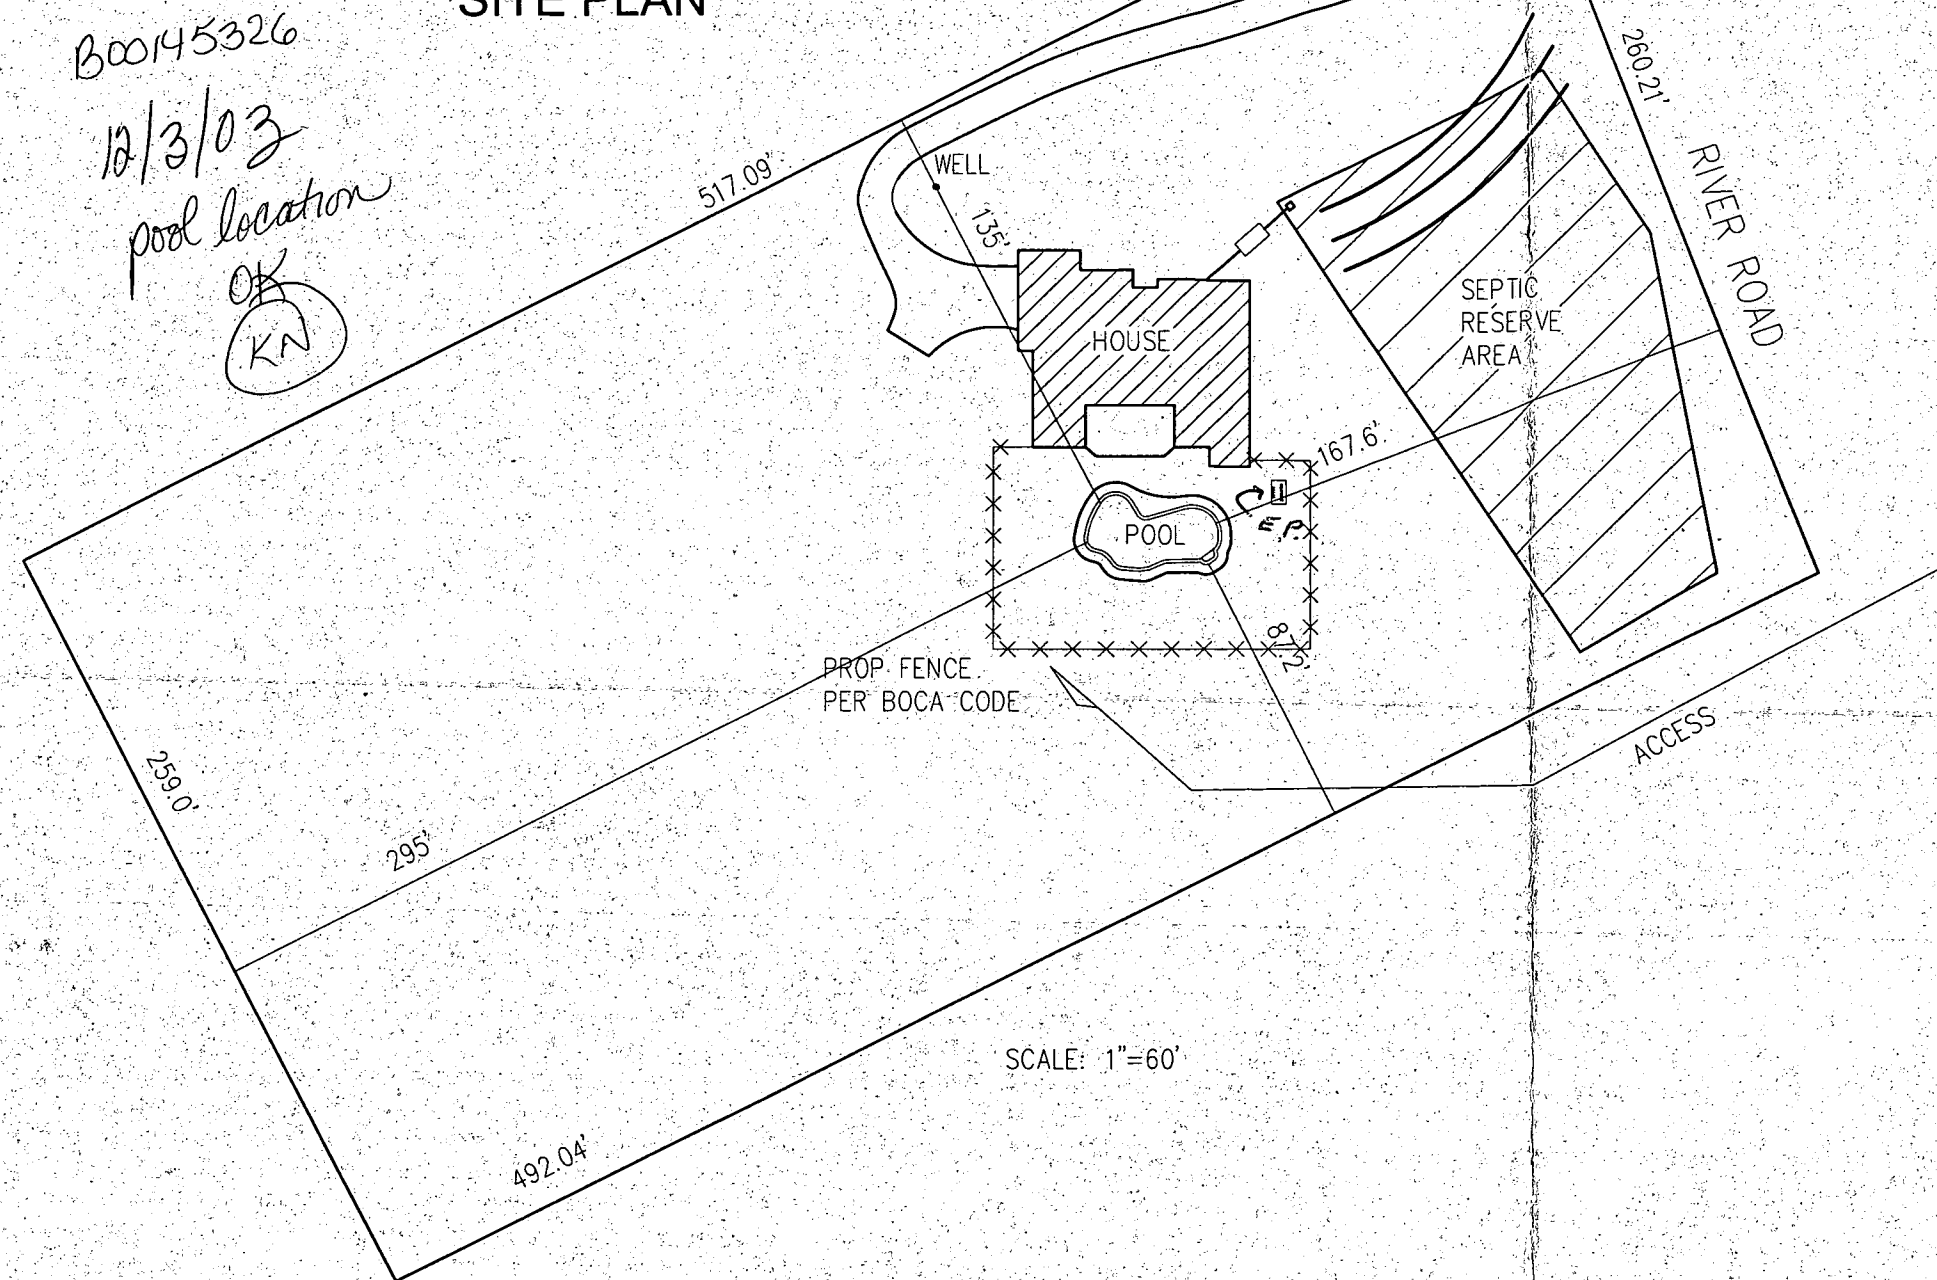

HOWARD COUNTY
MAP PG 5 GRID D-7

DIRECTIONS: FROM LAUREL

RTE 32 NORTH TO
(R) RIVER ROAD



APPLICATION

HOWARD COUNTY

PERMIT APPLICATION

DEPARTMENT OF INSPECTIONS, LICENSES & PERMIT
3430 COURT HOUSE DRIVE, ELLICOTT CITY, MARYLAND 21043

SERIAL NUMBER

52156

BUILDING ADDRESS (HOUSE NO., STREET, TOWN OR AREA)

638 River Road
Sykesville Md.GRADING/SEDIMENT CONTROL ☐ YES ☐ NO

SDP #

DESCRIPTION OF WORK AUTHORIZED

new single family home
with attached 2 car garage

3BR

LOT NO. PARCEL NO. SEC. AREA BLOCK NO. LIBER FOLIO

8 103 N/A N/A 23

SUB DIVISION ZONE ZONE MAP ELEC. DIST. CENSUS TR.

Bendale Estates BR 4 3 6035

OWNER NAME AND ADDRESS

Richard L. Geraldine F. McQuaid
11 University Ave. Baltimore Md 21228

PHONE NO.

747-5766

OCCUPANT'S NAME AND ADDRESS

PHONE NO.

ARCHITECT OR ENGINEER'S NAME AND ADDRESS

PHONE NO.

CONTRACTOR'S NAME AND ADDRESS

PHONE NO.

EXISTING USE

Vacant lot

PROPOSED USE

Single family home

EST. CONSTRUCTION COST

170,000

LICENSE NUMBER

PERMIT FEE

W/S CODE

FOR OFFICE USE ONLY

DISTRICT IN FEET FROM R/W LINE TO FRONT BUILDING LINE

SIDE YARD

(DISTANCE IN FEET FROM SIDE BLDG. LINE TO SIDE PROPERTY LINE)

TO SIDE BUILDING LINE

DISTANCE IN FEET, REAR YD. REQUIRING SET

BACK (CORNER LOT ONLY)

SDP #

Check payable to: DIRECTOR OF FINANCE OF HOWARD COUNTY

CAUTION

To begin construction before a permit placard has been issued
and displayed on the job is a violation of the law.Use and occupancy permit must be applied for two weeks
before it will be issued.

IMPORTANT: PLEASE SHOW ZIP CODES AND AREA CODES WHEREVER REQUIRED.

LP-69-591

SIZE OF BLDG.	FRONT	DEPTH	HEIGHT
TYPE OF BLDG.	AREA	VOLUME	ROOF
B. ROOMS			
ROOMS			
BATHS			
FIREPLACES			
FOOTINGS	FOUNDATION	S. WALLS	

UTILITIES			
WATER/WELL	SEWER/SEPTIC	GAS	ELECTRICITY

I have carefully examined and read this application and know the same is true and correct, and that is doing this work, all provisions of Howard County Ordinances and the State Laws of Maryland will be complied with, whether specified or not; and I will notify the Department of Inspections, and Permits twenty-four hours in advance when I am ready for the inspections called for elsewhere in the application; and that no work will be covered up until such inspections have been complied with.

Signature: *Richard L. Geraldine F. McQuaid*
TITLE: *Owner* DATE: *12-29-93*

FUNCTION	DATE	SIGNATURE APPROVAL
ZONING/PLANNING	☒	
SHA	☒	
SEDIMENT/GRADING	☒	
BUILDING OFFICIAL	☒	
WATER & SEWER		
HEALTH DEPT.	☒ 1/12/94	<i>Mark E. Ripken</i>
FIRE PROTECTION		
STORM WATER MGM.	☒	

APPROVED

DATE

Distribution of Copies:
White - Building Official
Green - Planning & ZoningYellow - Engineering
Pink - Health Dept.
Gold - S.H.A.