


SALOPHA LOT 4

Well + SEPTIC. PLAN

(1)

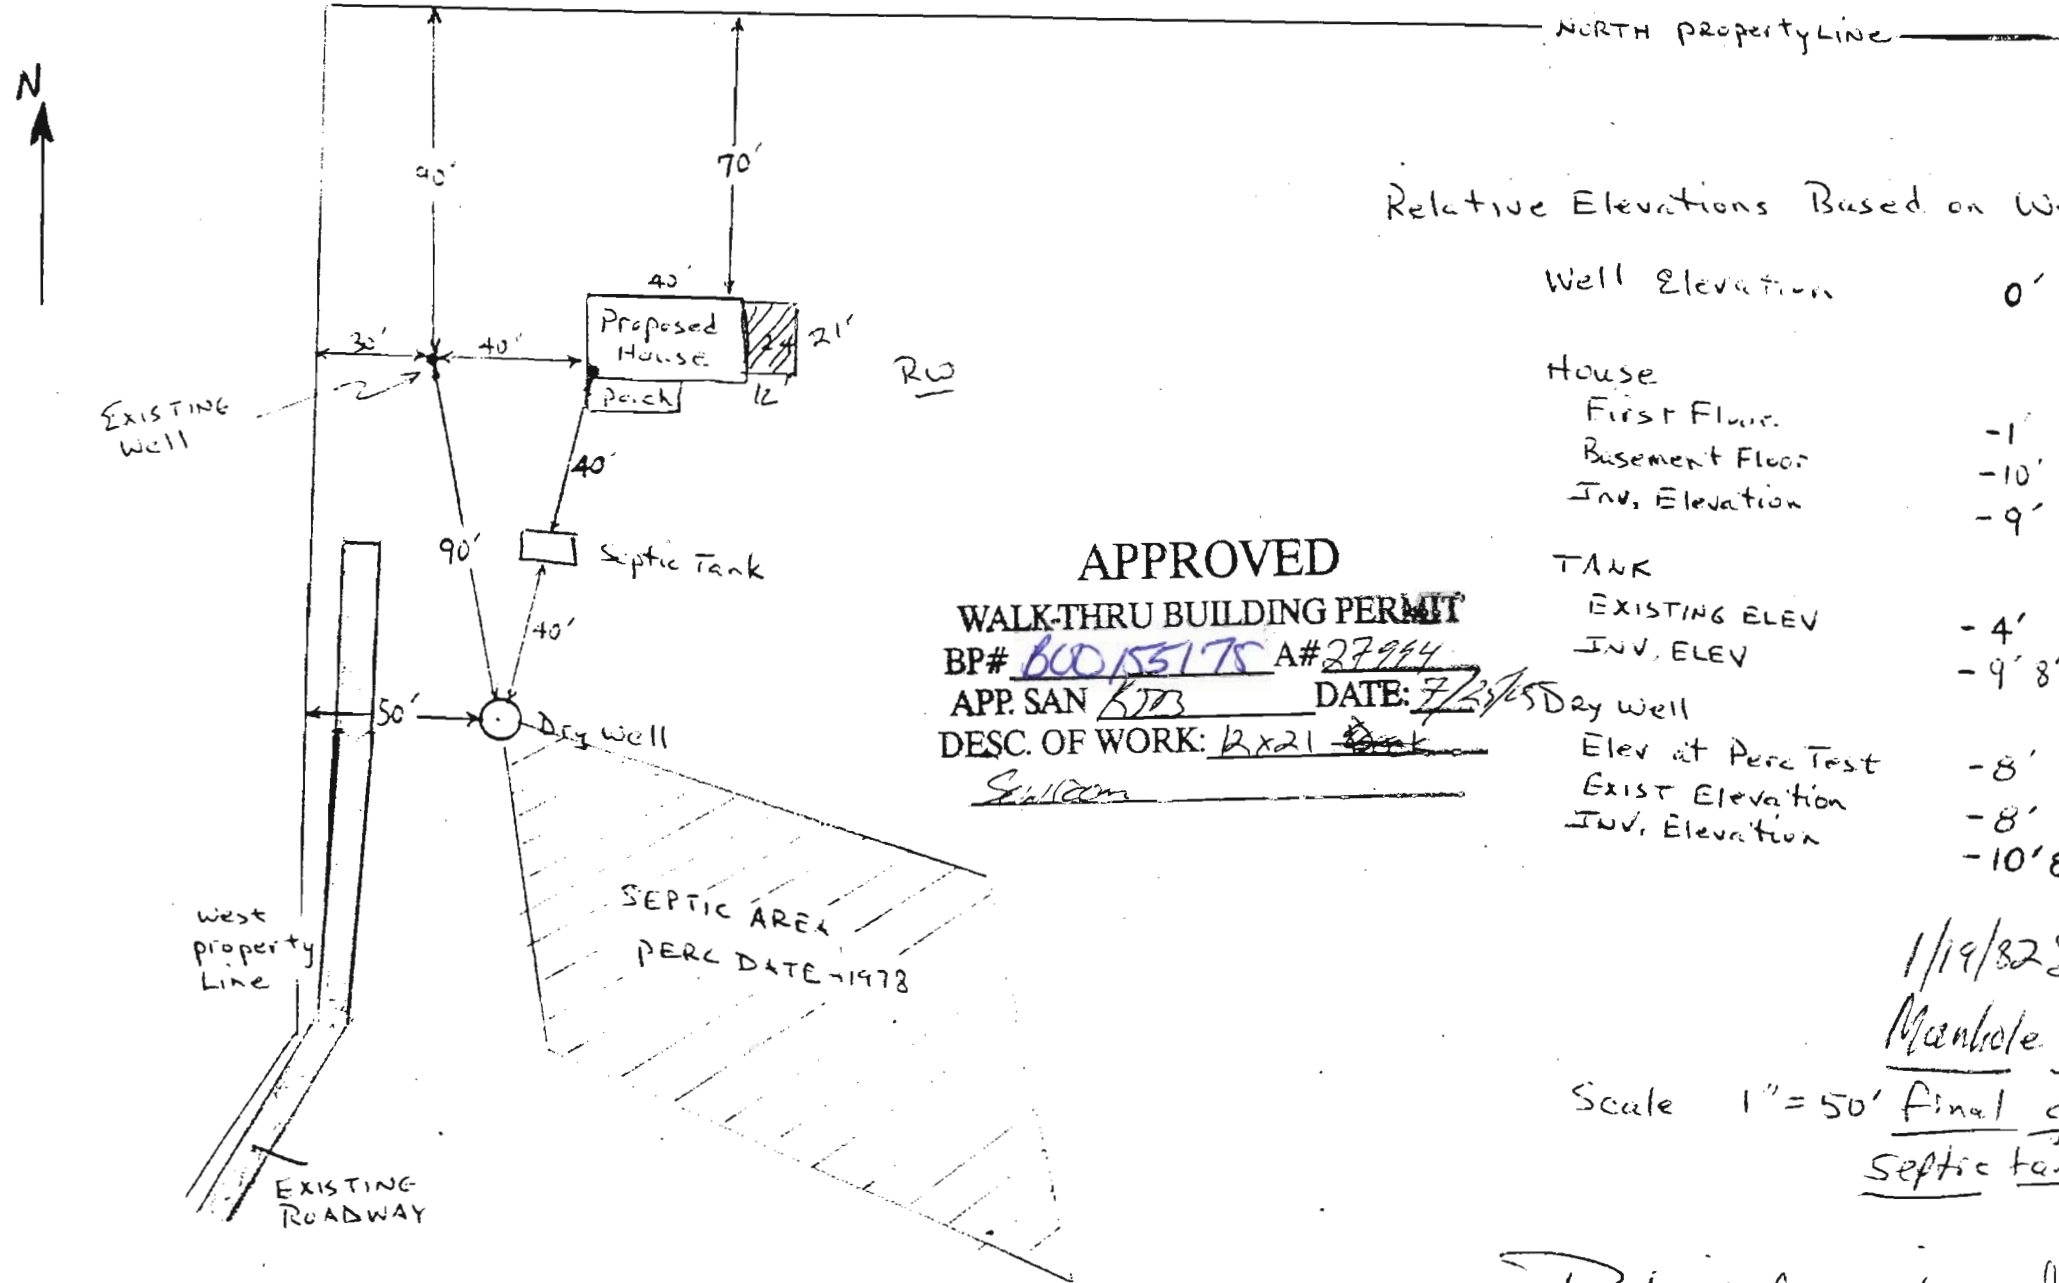

Relative Elevations Based on Well Height

Well Elevation 0'

House
First Floor -1'
Basement Floor -10'
Inv. Elevation -9'

TANK
EXISTING ELEV -4'
INV. ELEV -9' 8"
Dry well
Elev at Perc Test -8'
Exist Elevation -8'
Inv. Elevation -10' 8"

APPROVED

WALK-THRU BUILDING PERMIT

BP# 600153175 A# 27944

APP. SAN KTB DATE: 7/23/85

DESC. OF WORK: 12x21 Tank

Shallow

1/19/82 Sketch O.K.

Manhole required to

Scale 1" = 50' final grade at
septic tank Fr. S.

Richard A. Wiker Jan 15, 1982
Richard A. Wiker July 25, 2005