

View Map			View GroundRent Redemption			View GroundRent Registration			
Tax Exempt:			Special Tax Recapture:						
Exempt Class:			NONE						
Account Identifier:			District - 04 Account Number - 316762						
Owner Information									
Owner Name:		HALL NEVA J HALL DEBORAH M T/C ETAL			Use: Principal Residence:		RESIDENTIAL YES		
Mailing Address:		14591 ROXBURY RD GLENELG MD 21737-9613			Deed Reference:		/07023/ 00185		
Location & Structure Information									
Premises Address:		14591 ROXBURY RD GLENELG 21737-0000			Legal Description:		LOT 5 14591 ROXBURY RD L B SCOTT SUBDV		
Map:	Grid:	Parcel:	Sub District:	Subdivision:	Section:	Block:	Lot:	Assessment Year:	Plat No:
0021	0023	0038		0000			5	2017	Plat Ref:
Special Tax Areas:					Town:		NONE		
					Ad Valorem:		100		
					Tax Class:				
Primary Structure Built		Above Grade Living Area		Finished Basement Area		Property Land Area		County Use	
1961		1,914 SF				3.4900 AC			
Stories	Basement	Type		Exterior	Full/Half Bath	Garage	Last Major Renovation		
1	YES	STANDARD UNIT		FRAME	2 full	1 Attached			
Value Information									
		Base Value		Value		Phase-in Assessments			
				As of		As of		As of	
				01/01/2017		07/01/2018		07/01/2019	
Land:		248,600		223,600					
Improvements		210,400		205,800					
Total:		459,000		429,400		429,400		429,400	
Preferential Land:		0						0	
Transfer Information									
Seller: HALL QUENTIN S				Date: 04/03/2003			Price: \$0		
Type: NON-ARMS LENGTH OTHER				Deed1: /07023/ 00185			Deed2:		
Seller: HALL QUENTIN S & WF				Date: 12/28/1995			Price: \$0		
Type: NON-ARMS LENGTH OTHER				Deed1: /03632/ 00485			Deed2:		
Seller:				Date:			Price:		
Type:				Deed1:			Deed2:		
Exemption Information									
Partial Exempt Assessments:		Class		07/01/2018		07/01/2019			
County:		000		0.00					
State:		000		0.00					
Municipal:		000		0.00 0.00		0.00 0.00			
Tax Exempt:				Special Tax Recapture:					
Exempt Class:				NONE					
Homestead Application Information									
Homestead Application Status: Approved 08/13/2008									
Homeowners' Tax Credit Application Information									

1. This screen allows you to search the Real Property database and display property records.
2. Click **here** for a glossary of terms.
3. Deleted accounts can only be selected by Property Account Identifier.
4. The following pages are for information purpose only. The data is not to be used for legal reports or documents. While we have confidence in the accuracy of these records, the Department makes no warranties, expressed or implied, regarding the information.

INDEXED

APPLICATION

A 00498

P

SEWAGE DISPOSAL TESTING

MARYLAND STATE DEPARTMENT OF HEALTH

HOWARD COUNTY

ELLICOTT CITY

750 GALLON TANK

DISTRICT 4th

300 SQ FT SIDEWALL AREA IN DRY WELL
(EXAMPLE 8' IN DIAMETER BY 12' DEEP)

DATE Feb 20, 1959

20

TO: THE COUNTY HEALTH OFFICER
ELLICOTT CITY, MARYLAND

I, HEREBY, APPLY FOR THE NECESSARY TESTS IN ORDER TO CONSTRUCT (OR RECONSTRUCT) A SEWAGE DISPOSAL SYSTEM.

PROPERTY OWNER Quentin S. Hall

ADDRESS 5708 Gischel Street, Baltimore 25, Md. PHONE State 9-6298

PROPERTY LOCATION:

SUBDIVISION Roxbury Road near Tridelphia Road LOT NO. 5

ROAD AND DESCRIPTION Directly opposite Devereaux Entrance

OCCUPANT Quentin S. Hall PHONE State 9-6298

PERSON TO CONSTRUCT SYSTEM Wm. Robinson & Son

ADDRESS Glenburnie, Md. PHONE

SIZE OF LOT 3 1/2 acres TYPE BLDG. 3 NUMBER OF BEDROOMS

IF NOT SINGLE RESIDENCE DESCRIBE

SIGNATURE OF APPLICANT Quentin S. Hall

APPROVED BY Raymond Hodges FOR Dry Well DATE 3/4/59
(KIND OF SYSTEM)

REJECTED BY FOR DATE
(KIND OF SYSTEM)

HOLD PENDING FURTHER TESTS DATE

REASONS FOR REJECTION OR HOLDING

THIS IS NOT A PERMIT

A 00498

PERMIT

SEWAGE DISPOSAL SYSTEM

MARYLAND STATE DEPARTMENT OF HEALTH

HOWARD COUNTY

ELLICOTT CITY

DISTRICT 4

DATE _____

IS PERMITTED TO INSTALL _____ ALTER _____

ADDRESS _____ PHONE _____

A SEWAGE DISPOSAL SYSTEM LOCATED AT Roxbury Rd. near Triadelphia Rd.

SUBDIVISION _____ ROAD _____ LOT _____

PROPERTY OWNER Hall, Quentin S.

ADDRESS 5708 Gischel Street, Balto. 25.

SPECIFICATIONS

DRAIN FIELD _____ DEPTH _____ FEET, BOTTOM AREA 300 SQ. FT.

SEEPAGE PITS X ABSORBENT SIDE-WALL AREA 300 SQ. FT.

SEPTIC TANK CAPACITY 750 GALLONS


FOR GARBAGE GRINDER, INCREASE DISPOSAL AREA 22% & TANK CAPACITY 50%.

OTHER Septic tank cannot be installed more than 3 feet below original
grade.

PLANS APPROVED BY Raymond Hodges DATE 3/4/59.

FILL SEPTIC TANK AND DISTRIBUTION BOX WITH WATER BEFORE CALLING FOR AN INSPECTION. COVER NO WORK UNTIL INSPECTED AND APPROVED.

NEITHER THE HOWARD COUNTY COMMISSIONERS NOR THE HEALTH DEPARTMENT IS RESPONSIBLE FOR THE SUCCESSFUL OPERATION OF ANY SYSTEM.

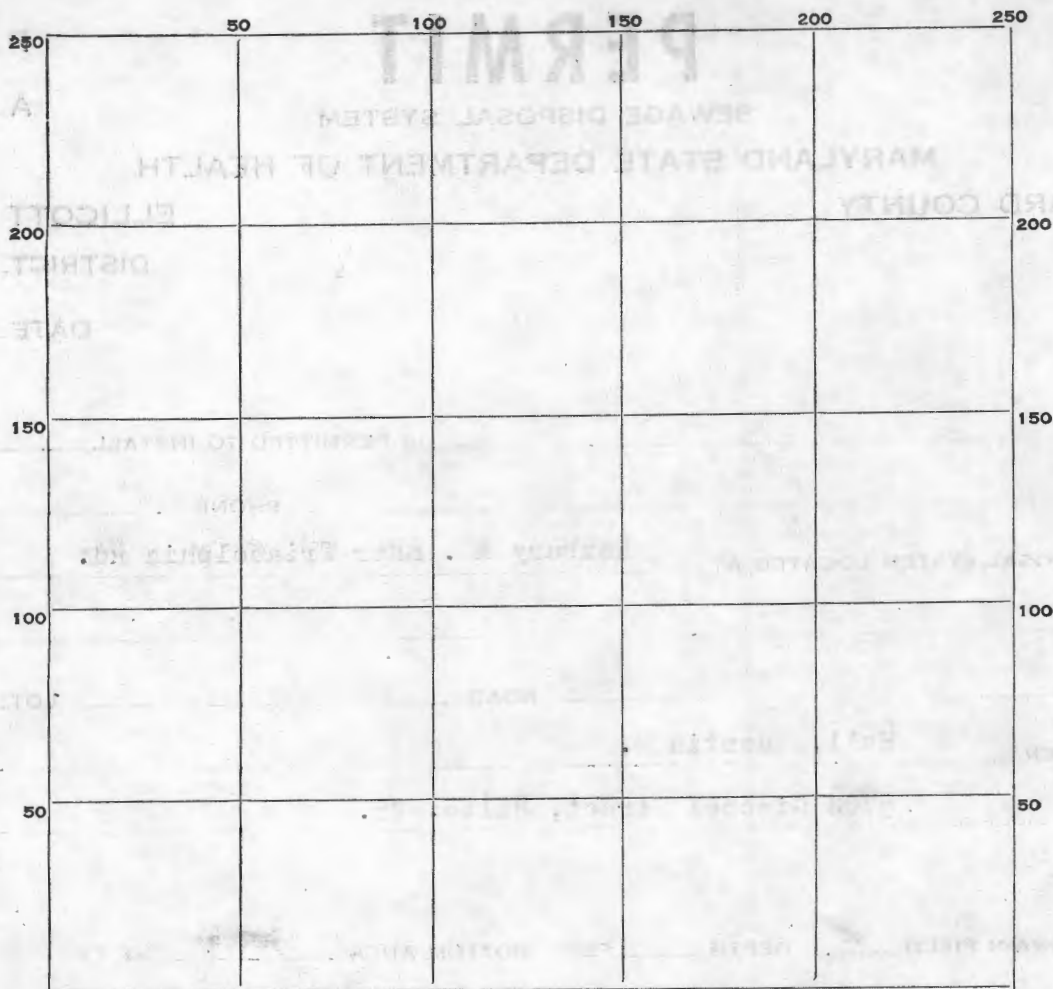

INDICATE NORTH. - NAME ADJOINING ROADWAY AS BASE LINE.

PERMIT CARD

SEPTIC TANK, LEVEL

CLEANOUTS

DISTRIBUTION BOX, LEVEL

TILE FIELD, DEPTH FT. TRENCH WIDTH FT.

GRAVEL DEPTH IN. TOTAL LENGTH FT.

NUMBER OF TRENCHES TOTAL BOTTOM AREA

SEEPAGE PITS, INSIDE DIAMETER FT. DEPTH BELOW INLET FT.

ABSORBENT AREA SQ. FT.

REMARKS

DATE SYSTEM APPROVED

INSPECTOR

PERMIT

SEWAGE DISPOSAL SYSTEM

MARYLAND STATE DEPARTMENT OF HEALTH

HOWARD COUNTY

ELLICOTT CITY

DISTRICT 4

DATE _____

_____ IS PERMITTED TO INSTALL _____ ALTER _____

ADDRESS _____ PHONE _____

A SEWAGE DISPOSAL SYSTEM LOCATED AT Roxbury Rd. near Triadelphia Rd.

SUBDIVISION _____ ROAD _____ LOT _____

PROPERTY OWNER Hall, Quentin S.

ADDRESS 5708 Gischel Street, Balto. 25.

SPECIFICATIONS

DRAIN FIELD _____ DEPTH _____ FEET, BOTTOM AREA _____ SQ. FT.

SEEPAGE PITS X ABSORBENT SIDE-WALL AREA 300 SQ. FT.

SEPTIC TANK CAPACITY 750 GALLONS

FOR GARBAGE GRINDER, INCREASE DISPOSAL AREA 22% & TANK CAPACITY 50%.

OTHER Septic tank cannot be installed more than 3 feet below original
grade.

PLANS APPROVED BY Raymond Hodges DATE 3/4/59.

FILL SEPTIC TANK AND DISTRIBUTION BOX WITH WATER BEFORE CALLING FOR AN INSPECTION. COVER NO WORK UNTIL INSPECTED AND APPROVED.

NEITHER THE HOWARD COUNTY COMMISSIONERS NOR THE HEALTH DEPARTMENT IS RESPONSIBLE FOR THE SUCCESSFUL OPERATION OF ANY SYSTEM.

250	50	100	150	200	250
200					200
150					150
100					100
50					50

INDICATE NORTH. — NAME ADJOINING ROADWAY AS BASE LINE.

PERMIT CARD _____

SEPTIC TANK, LEVEL _____ CLEANOUTS _____

DISTRIBUTION BOX, LEVEL _____

TILE FIELD, DEPTH _____ FT. TRENCH WIDTH _____ FT.

GRAVEL DEPTH _____ IN. TOTAL LENGTH _____ FT.

NUMBER OF TRENCHES _____ TOTAL BOTTOM AREA _____

SEEPAGE PITS, INSIDE DIAMETER _____ FT. DEPTH BELOW INLET _____ FT.

ABSORBENT AREA _____ SQ. FT.

REMARKS _____

DATE SYSTEM APPROVED _____ INSPECTOR _____