


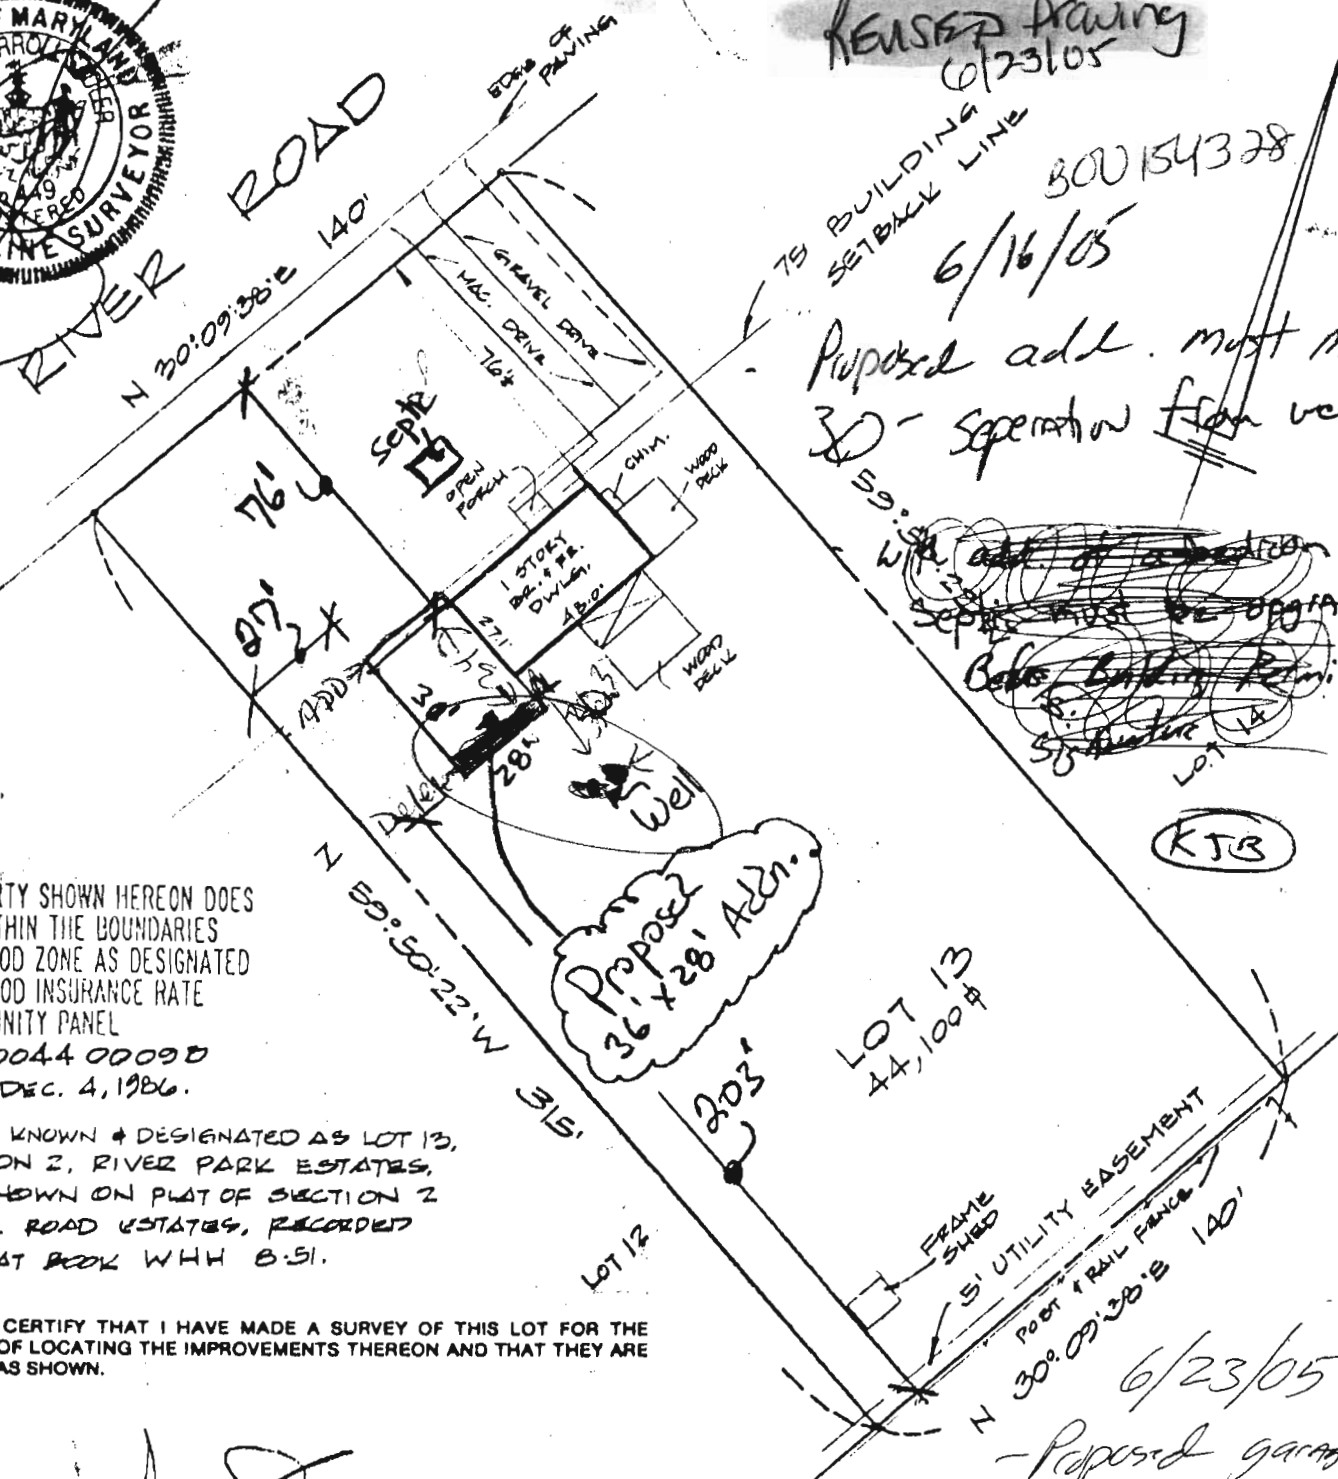

REUSED Drawing
6/23/05
300154328
6/16/05
Proposed add. must maintain
3' - separation from well
with add. of a foundation
septic must be upgraded
Before Building Permit
SF
JTB

THE PROPERTY SHOWN HEREON DOES NOT LIE WITHIN THE BOUNDARIES OF ANY FLOOD ZONE AS DESIGNATED ON THE FLOOD INSURANCE RATE MAP, COMMUNITY PANEL NO. 240044 0009 D DATED DEC. 4, 1986.

BEING KNOWN & DESIGNATED AS LOT 13, SECTION 2, RIVER PARK ESTATES, AS SHOWN ON PLAT OF SECTION 2 RIVER ROAD ESTATES, RECORDED IN PLAT BOOK WHH 8-51.

I HEREBY CERTIFY THAT I HAVE MADE A SURVEY OF THIS LOT FOR THE PURPOSE OF LOCATING THE IMPROVEMENTS THEREON AND THAT THEY ARE LOCATED AS SHOWN.

[Signature]

REG. NO. 449

**W.T. SADLER
SURVEYORS**

152 WESTMINSTER ROAD
REISTERSTOWN, MD
21136
(410) 526-5618



LOCATION SURVEY

1015 RIVER ROAD
3RD DISTRICT, HOWARD CO., MD.

SCALE 1"=50'	DATE 5-6-1994	APP. NO. <u> </u> JOB NO. <u>J-6003</u>
-----------------	------------------	---

DATE: 6/23/05

INSPECTOR: SF

SITE INSPECTION SHEET

OWNER: Charles Brown PHONE #: _____


ADDRESS: 1015 River Rd CONTRACTOR: _____

Sykesville MD 21784 WELL TAG #: _____

SUBDIVISION: _____ LOT: _____ COUNTY #: _____

PROPOSAL: Verify well location and setback distance of well from house and proposed addition

LOCATION DIAGRAM

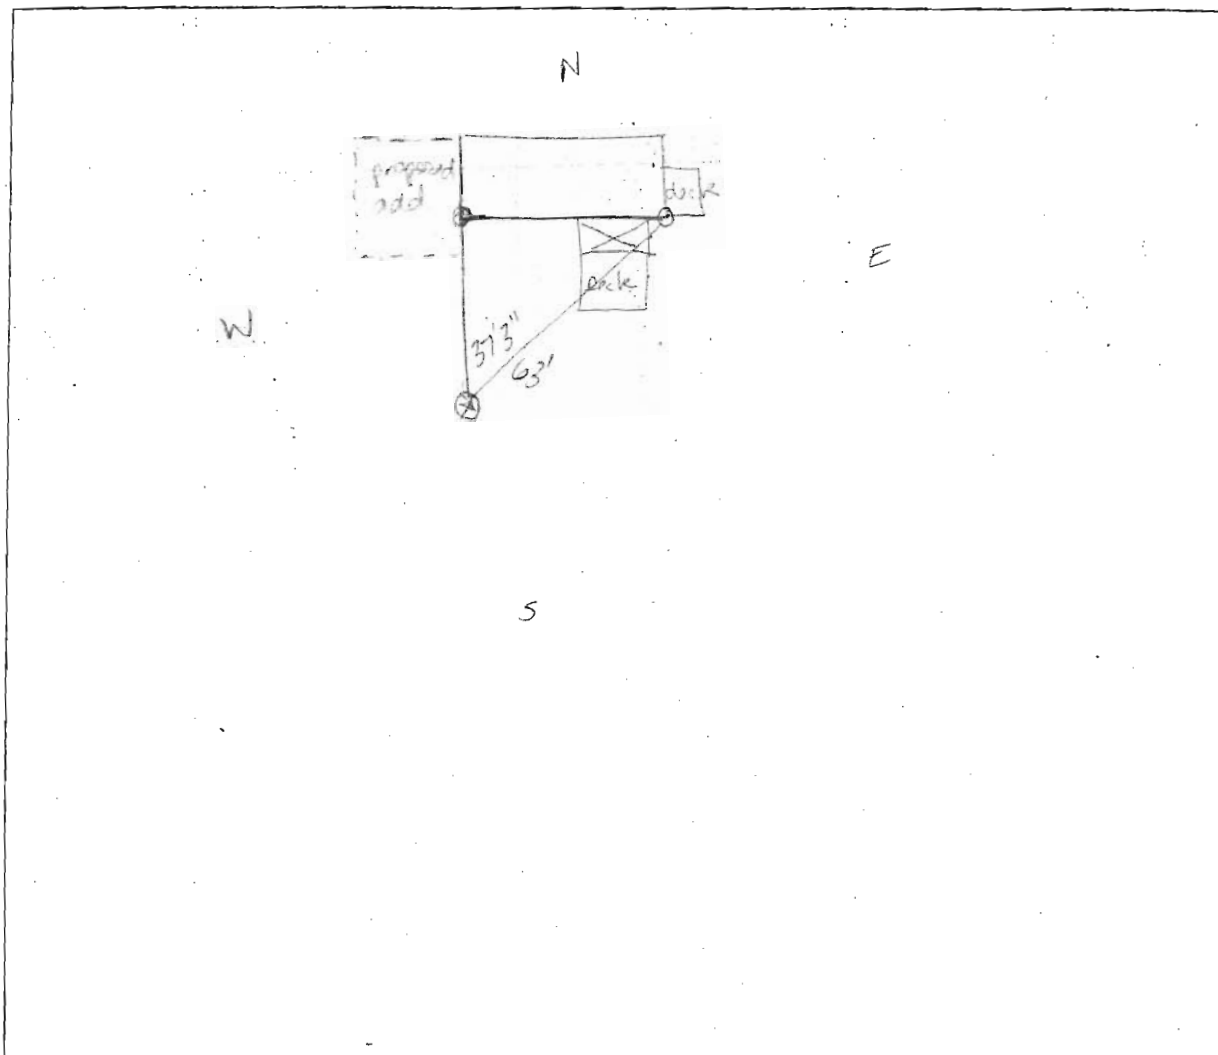

COMMENTS: Well located 37'3" from 'W' corner of house.
The addition can extend no more than 7'
behind back of house in order to maintain the
30' setback distance. (SF)

DATE: 6/23/05 INSPECTOR: SF