

# APPLICATION

A 09927

SEWAGE DISPOSAL TESTING

P

MARYLAND STATE DEPARTMENT OF HEALTH

HOWARD COUNTY

ELLICOTT CITY

DISTRICT 3

DATE 4/1/65

3 bedrooms  
Dry well 14 ft. in dia. by 12 ft. deep below the inlet located 43 ft. off the front property line and 91 ft. off the right side property line as seen when facing the lot from River road. 75 gal. septi. tank.  
4 bedrooms  
Two dry wells each 10 ft. in dia. by 9 ft. deep below the inlet. For the first dry well 34 ft. from the front property line and 130 ft. off the right side property line. For the second dry well 43 ft. off the front property line and 130 ft. off the right side property line. Locations determined when facing the lot from River Road.

TO: THE COUNTY HEALTH OFFICER  
ELLICOTT CITY, MARYLAND

I, HEREBY, APPLY FOR THE NECESSARY TESTS IN ORDER TO CONSTRUCT (OR RECONSTRUCT) A SEWAGE DISPOSAL SYSTEM.

PROPERTY OWNER Debra Corp.

ADDRESS 241 Fox Hound Rd., Ellicott City, Md. PHONE 465-2224

PROPERTY LOCATION:

SUBDIVISION River Park Estates LOT NO. 13, Sec. 2

ROAD AND DESCRIPTION River Rd.

OCCUPANT PHONE

PERSON TO CONSTRUCT SYSTEM

ADDRESS PHONE

SIZE OF LOT 44,700 sq. ft. TYPE BLDG. 3 bedrooms  
NUMBER OF BEDROOMS 3

IF NOT SINGLE RESIDENCE DESCRIBE

SIGNATURE OF APPLICANT /s/ R. W. Griffith


APPROVED BY Hemigan FOR Dry Well DATE 4-28-65  
(KIND OF SYSTEM)

REJECTED BY FOR DATE  
(KIND OF SYSTEM)

HOLD PENDING FURTHER TESTS R. W. Griffith DATE 4/15/65

REASONS FOR REJECTION OR HOLDING No matter how long

# THIS IS NOT A PERMIT

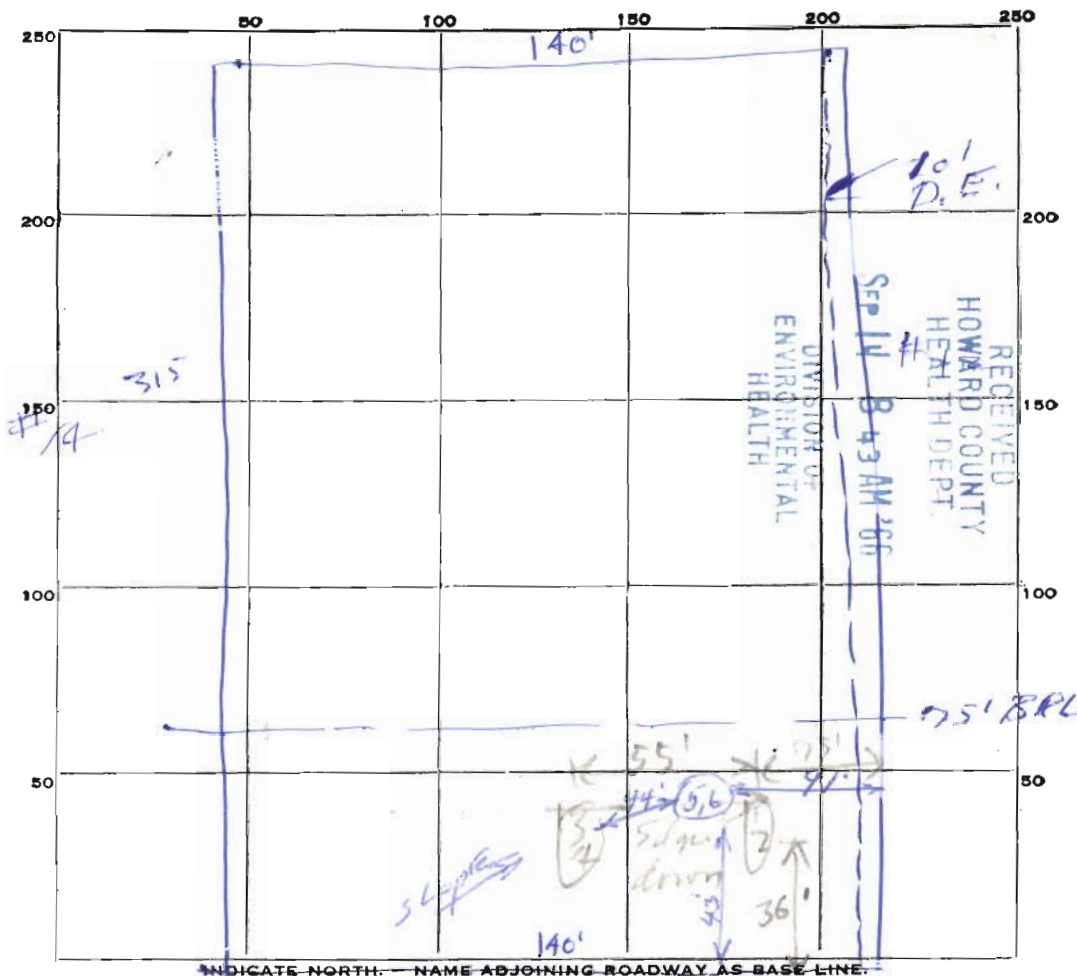

DATE	TEST NO.	DEPTH	PRE-WET		TEST - 1" DROP		TIME
			START	STOP	START	STOP	
4/15/65	1	9'	10:37	Continued on 1			
	2	3'	10:37	10:41	10:41	10:54	13 min
	3	8'	10:40	10:47	10:47	10:55	8 min
	4	3'	10:41	10:46	10:46	10:55	9 min
4-28-65	5	9'	10:19	10:28	10:28	10:52	24 min
1	6	4'10"	10:20	10:26	10:26	10:43	17 min

SOIL AUGER FINDING \_\_\_\_\_

TESTED BY

R.D.F. 4/15/65

REMARKS

None available for test

Lot 13, Sec. 2