

9/15/66
PERMIT

SEWAGE DISPOSAL SYSTEM

MARYLAND STATE DEPARTMENT OF HEALTH

HOWARD COUNTY

ELLICOTT CITY

DISTRICT 3

DATE 8/31/66

INDEXED

Debra Corp. Owner - John E. Ruth Co. IS PERMITTED TO INSTALL X ALTER

ADDRESS 400 Overbrook Rd., Baltimore 28, Md. PHONE

A SEWAGE DISPOSAL SYSTEM LOCATED AT

SUBDIVISION River Park Estates ROAD River Rd. LOT 13, Sec. 2

PROPERTY OWNER Debra Corp.

ADDRESS

SPECIFICATIONS - 3 bedrooms

DRAIN FIELD DEPTH FEET, BOTTOM AREA SQ. FT.

SEEPAGE PITS ABSORBENT SIDE-WALL AREA SQ. FT.

SEPTIC TANK CAPACITY 750 GALLONS

FOR GARBAGE GRINDER, INCREASE DISPOSAL AREA 22% & TANK CAPACITY 50%.

OTHER Dry well - 16 ft. square - set block and top for 12 ft. diameter and
fill in rest of pit with gravel. Depth of dry well 9 ft. deep below
inlet pipe. Inlet pipe no deeper than 4 ft. below original grade.
Place dry well 43 ft. from front lot line and 91 ft. from right side line as
seen when facing lot from River Rd.


PLANS APPROVED BY D. W. Monaghan DATE 5/10/66 Rewritten as of
5/10/66

FILL SEPTIC TANK AND DISTRIBUTION BOX WITH WATER BEFORE CALLING FOR AN INSPECTION. COVER NO WORK UNTIL INSPECTED AND APPROVED.

NEITHER THE HOWARD COUNTY COMMISSIONERS NOR THE HEALTH DEPARTMENT IS RESPONSIBLE FOR THE SUCCESSFUL OPERATION OF ANY SYSTEM.

**NOTIFY THE HEALTH DEPARTMENT 48 HOURS
BEFORE EXCAVATIONS ARE TO BE BACK FILLED.**

A 119820

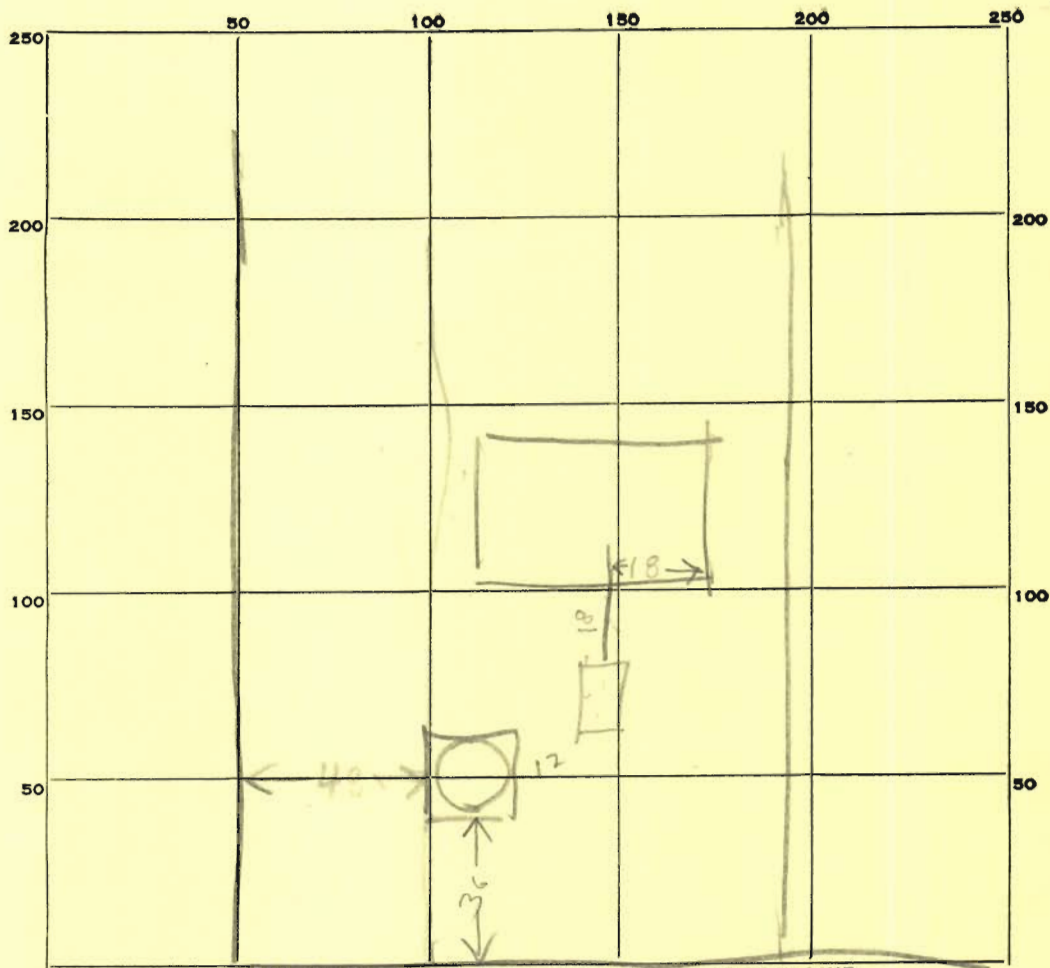

INDICATE NORTH. - NAME ADJOINING ROADWAY AS BASE LINE.

ROAD