


33416

Recent  
Complaint  
Job

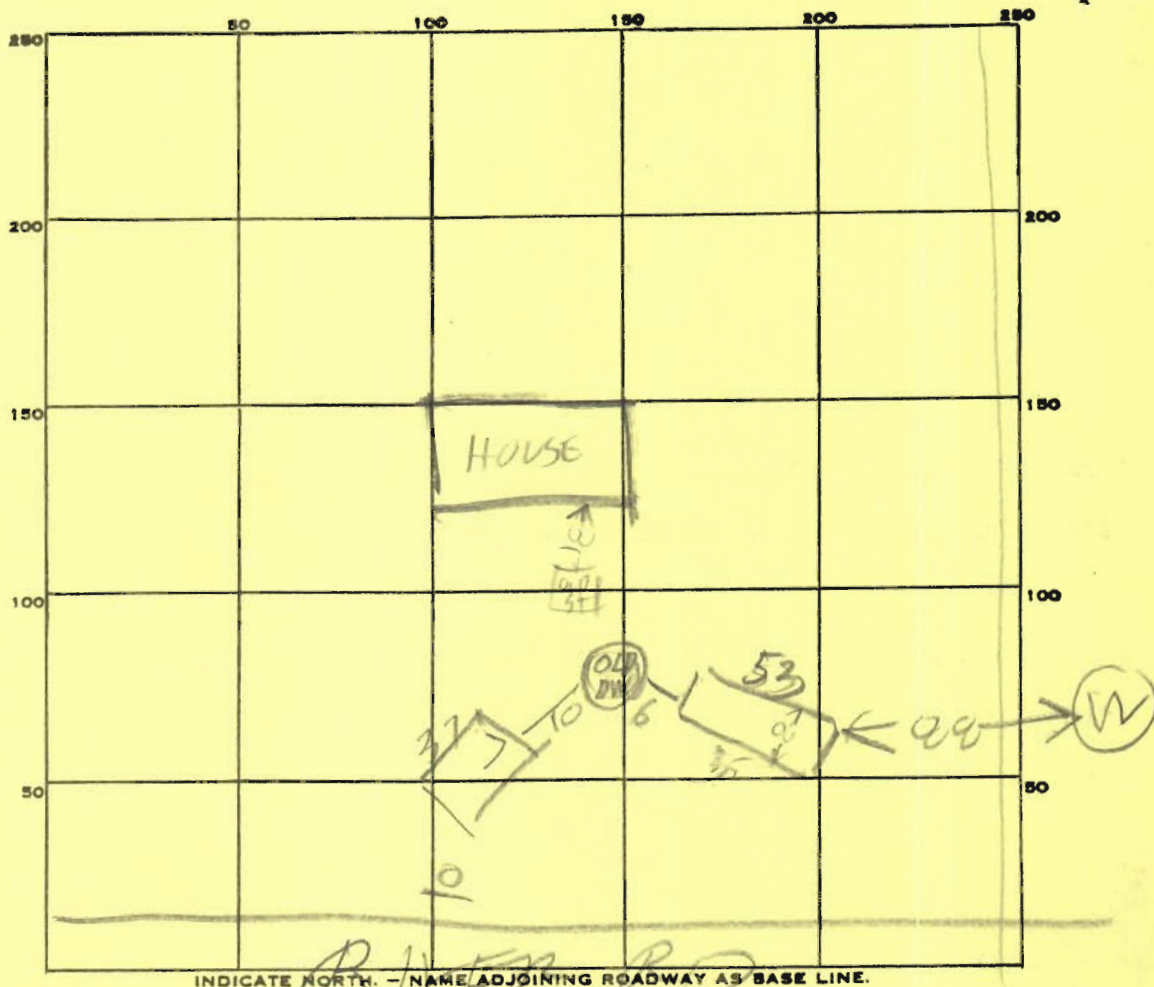

PERMIT CARD \_\_\_\_\_

SEPTIC TANK, LEVEL \_\_\_\_\_

CLEANOUTS \_\_\_\_\_

DISTRIBUTION BOX #1 LEVEL #1 #2 \_\_\_\_\_

TILE FIELD, DEPTH 5-6 7-8 FT. TRENCH WIDTH 8 7 FT. \_\_\_\_\_

GRAVEL DEPTH \_\_\_\_\_ IN. TOTAL LENGTH 53 37 FT. \_\_\_\_\_

NUMBER OF TRENCHES BED 2 TOTAL BOTTOM AREA 424 259 = 683

SEEPAGE PITS, INSIDE DIAMETER \_\_\_\_\_ FT. DEPTH BELOW INLET \_\_\_\_\_ FT.

ABSORBENT AREA \_\_\_\_\_ SQ. FT.

REMARKS LEACHING BED - SUPPOSED TO HAVE 2

FT STONE WHEN FINISHED

SOIL LOOKS VERY SANDY

water well in back yard

DATE SYSTEM APPROVED

12/23/83

INSPECTOR

Raymond Hodge