


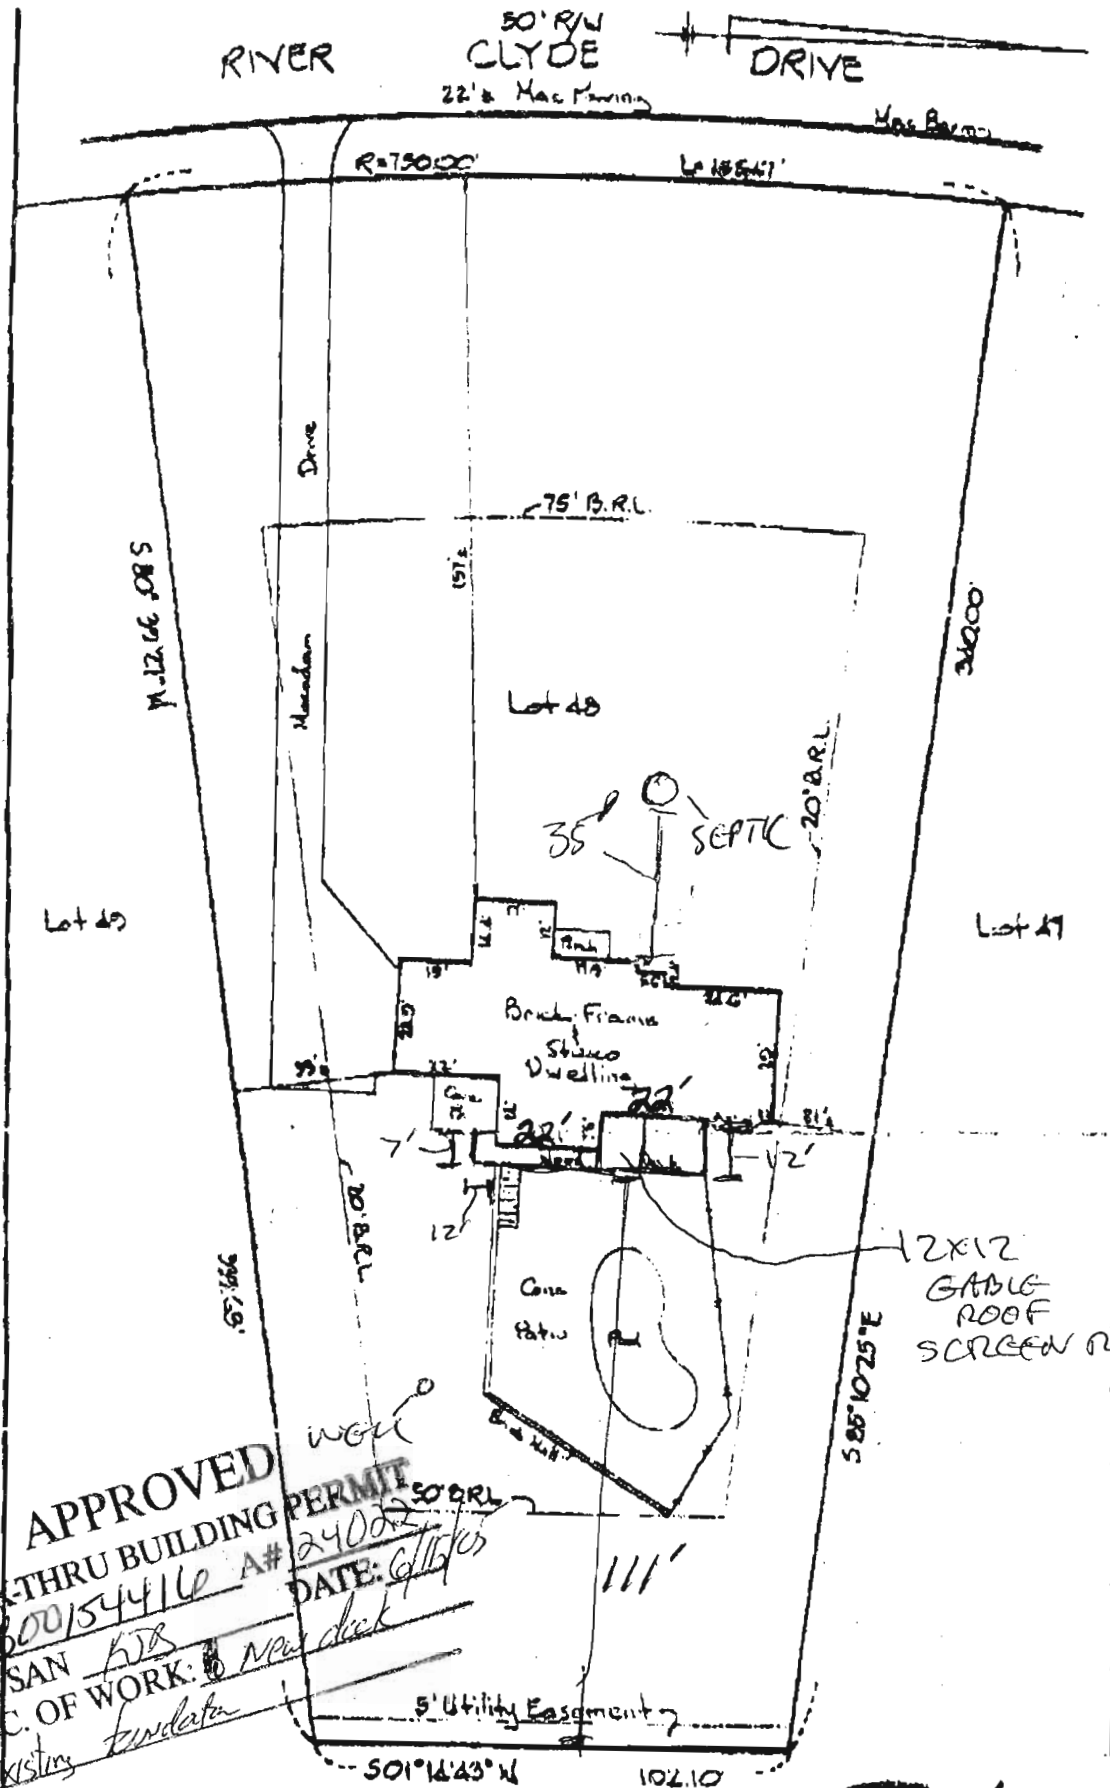

APPROVED  
WALK-THRU BUILDING PERMIT  
BP# 600154416 A# 24002  
APP/SAN HJB  
DATE: 6/16/05  
DESC. OF WORK: New deck  
existing foundation

This is to certify that the lot shown  
hereon is not in a flood plain.  
THIS IS TO CERTIFY THAT THE IMPROVEMENTS INDICATED  
HEREON ARE LOCATED AS SHOWN. THIS IS NOT A PROPERTY  
LINE SURVEY AND SHOULD NOT BE USED AS SUCH.



|                                                                                                                                                                    |                                                                                                                                                |                     |            |
|--------------------------------------------------------------------------------------------------------------------------------------------------------------------|------------------------------------------------------------------------------------------------------------------------------------------------|---------------------|------------|
| <b>HICKS ENGINEERING COMPANY, INC.</b><br>ENGINEERS • SURVEYORS • PLANNERS<br>200 EAST JOPPA ROAD - SUITE 402<br>TOWSON, MARYLAND 21204<br>TELEPHONE: 301/494-0001 | <b>LOCATION CERTIFICATION</b><br># 6514 RIVER CLYDE DRIVE; LOT 48<br>SHT. 9 of 3, SECT. II "HIGHLAND LAKE"<br>HOWNOW CO. MD. PAT BOOK CMP#3877 |                     |            |
|                                                                                                                                                                    | DATE: 5/26/05                                                                                                                                  | SCALE: 1/8" = 1'-0" | FILE: 5911 |

|                          |                              |
|--------------------------|------------------------------|
| Post-it® Fax Note 7671   |                              |
| To: Andy M.              | Date:                        |
| Co./Dept: Frontier Docks | From: David Politzer         |
| Phone #:                 | Co:                          |
| Fax #:                   | Phone #: 443-324-7024 (cell) |
|                          | Fax #: 410-531-2484          |