
DEPARTMENT OF INSPECTION IS LICENSES AND PERMITS ELLICOTT CRITICAL THAT PERMITS HIND 313-2455 KSI ECTIONS HIND 313-3160 AUTOMATED REFORM BON (4107) 31-3400		HOWARD COUNTY PERMIT APPLICATION		PERMIT NUMBER BORDO 2809	
Building Address 65.9 ERIVER Clyde DR Property Owner's Name Markon Pekson					
High land Md 20777		Address 6559 River Clyde Do			
Suite/Apt. #: SDP/WP/Petition #: Census Tract Subdivision		city High land state Mod Zip Code 20777			
Section Area Lot		Home Phone Work Phone			
Tax Map 34 Parcel 373 Grid 22		Applicant's Name & Mailing Address, (if other than stated hereon):			
Zoning Map Coordinates Lot size		Phone Fax			
Existing Use SFA		Contractor Company Michelletting: Mechanical Linix			
Proposed Use Same With HANK Estimated Construction Cost \$ 1000		Contact Person Robert J. Mychel Sc			
Description of Work InStall (1) 500 U.G.					
		Address 2518 Green Rd			
propare tank and run line		City Baldwin State MV Zip Code 21013			
to house per NFPA 54, 58		License No730/e 1			
Occupant or Tenant NWNER		Phone 410 692 5416 Fax 443 927 9357			
Contact Name		Engineer or Architect Company Contact Person			
Address_		Address			
City State Zip Code		City State Zip Code			
Phone Fax		Phone Fax			
BUILDING DESCRIPTION - <u>COMMERCIAL</u>		BUILD	ING DESCRIPT	ION - <u>RESIDENTIAL</u>	
Building Characteristics	<u>Utilities</u>	Building Charac	teristics	<u>Utilities</u>	
Height:	Water Supply: Public	SF Dwelling D SF Tov Depth	vnhouse □ Width	Water Supply: Public	
No. of stories:	Private Sewage Disposal:	1st floor: 2nd floor:	22332	Private Sewage Disposal:	
Gross area, sq. ft. per floor;	Public Private	Basement:		Public Private	
Use group:	Electric Yes □ No □ Gas Yes □ No □	Finished Basement Unfir Crawl space Slab on No. of Bedrooms		Electric Yes No Gas Yes V No	
		Height: Multi-family dwellings: No. of efficiency units:		Heating System:	
Construction type:	Heating System:	No. of 1 BR units: No. of 2 BR units:		Electric Oil Natural Gas	
Reinforced Concrete Structural Steel	Natural Gas ☐ Propane Gas ☐	No. of 3 BR units:		Propane Gas	
Masonry Wood Frame	Sprinkler system: N/A 🗆	Other Structure: Dimensions:		Sprinkler system: N/A [] NFPA #13D	
	Full Partial	Footings:Roof Height:		NFPA #13R Other:	
State Certified Modular	Other Suppression # of Heads	State Certified Modular Manufactured Home			
THE UNDERSIGNED HEREBY CERTIFIES AND AGREES AS FOLLOWS: (1) THAT HE/SHE IS AUTHORIZED TO MAKE THIS APPLICATION; (2) THAT THE INFORMATION IS CORRECT; (3) THAT HE/SHE WILL COMPLY WITH ALL REGULATIONS OF HOMBOD COUNTY WHICH ARE APPLICABLE THERETO, IT THAT HE/SHE WILL COMPLY WITH ALL REGULATIONS OF THE RIGHT OF SPECY ONDERSYS OND					
MAM	INSPECTING THE WORK PERMITTED AND POSTING NO	Kobeet J	Michel	5c.	
Applicant's Signature Michel Welding & Mell Title/Company	Print Name 10/7/5	09			
•	Checks payable to: DIRECTOR OF ** PLEASE WRITE NEA	FINANCE OF HOWARD CO	DUNTY		
AGENCY DATE		E USE ONLY- DPZ SETBACKI	es at the Protection and estimate of the	PROPERTY ID#:	
Land Development, DPZ State Highways	第二十八十二年 2012年 1913年 1913	ront lear	Filing	it fee	
Building Official Dev. Engineering, DPZ	alor of the Little of the residence of the best beautiful to the field of	ide Karanan	Exci	se tax S	
Health 10-16-09	BALL OF THE SECOND STREET, STR	Side St: Add1 per, fee \$ All minimum setbacks met? TOTAL FEES \$			
Fire Protection Is Sediment Control approval required prior to it		YES 🛛 NO 🗎 Sub-total paid 💲			
YES 🗆 NO 🗉		YES D NO D	treguired? Balar Chec	nce due \$	
CONTINGENCY CONSTRUCTION	4. 中心,1945年的1945年,1945年,1945年,1945年,1945年,1945年,1945年,1945年,1945年,1945年,1945年,1945年,1945年,1945年,1945年,1945年,19	listoric Distric(? /ES □ NO □	Valid	ation #	
ONE STOP SHOP 🖂		of Coverage for NewTown Zone			
		SDP/Red-line approval date Yellow: DED_DPZ	Plate Usable	SOFT OF CHARLES AND	
		TAUM, DED, DPZ	Pinic Health	Gold: SHA	

化多色等等

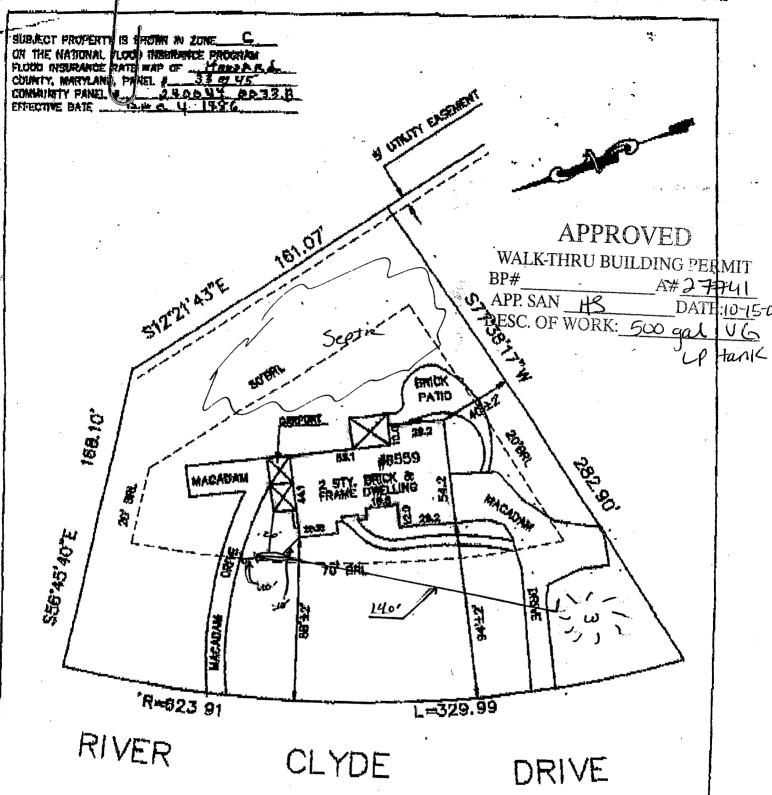

NOTE: 1. ALSO KNOWN AS LOT 76 AS SHOWN ON A PLAT ENTITLED "HIGHLAND LAKE" SECTION 2 AND RECORDED IN HOWARD CO., MARYLAND ON PLAT C.M.P. NO.

1) The tilet in of houself in m