



<p>Building Address: <u>36002 SCAMORE VALLEY RD</u></p> <p>City: <u>GREENWOOD</u> State: <u>MD</u> Zip Code: <u>21738</u></p> <p>Suite/Apt. # _____ SDP/WP/BA #: _____</p> <p>Subdivision: _____</p> <p>Lot: _____ Tax Map: _____ Parcel: _____</p> <p>Existing Use: <u>SFD</u></p> <p>Proposed Use: <u>SFD</u></p> <p>Estimated Construction Cost: \$ <u>280,000.00</u></p> <p>Description of Work: <u>INGROUND POOL, EXTERIOR LIVING SPACE (GRILL + FIREPLACE) PATIOS. POOL TO BE FILLED BY TRUCK. AUTO COVER</u></p> <p>Occupant/Tenant Name: _____</p> <p>Was tenant space previously occupied? <input type="checkbox"/> Yes <input type="checkbox"/> No</p> <p>Contact Name: _____</p> <p>Address: _____</p> <p>City: _____ State: _____ Zip Code: _____</p> <p>Phone: _____ Fax: _____</p> <p>Email: _____</p>	<p>Property Owner's Name: <u>KEEGAN & JENNY MEACHAM</u></p> <p>Address: _____</p> <p>City: _____ State: _____ Zip Code: _____</p> <p>Phone: <u>SAME</u> Fax: _____</p> <p>Email: _____</p> <p>Applicant's Name & Mailing Address, (If other than stated herein)</p> <p>Applicant's Name: _____</p> <p>Address: _____</p> <p>City: _____ State: _____ Zip Code: _____</p> <p>Phone: _____ Fax: _____</p> <p>Email: _____</p> <p>Contractor Company: <u>LOTHORIAN POOLS</u></p> <p>Contact Person: <u>CURTIS FIDLER</u></p> <p>Address: <u>12536 JARRETSVILLE PIKE</u></p> <p>City: <u>PHOENIX</u> State: <u>MD</u> Zip Code: <u>21131</u></p> <p>License No.: <u>MHIC: 10595 MHBR: 7601</u></p> <p>Phone: <u>4106677065</u> Fax: <u>4106660653</u></p> <p>Email: <u>CFidler@lothorian.com</u></p> <p>Engineer/Architect Company: _____</p> <p>Responsible Design Prof.: _____</p> <p>Address: _____</p> <p>City: _____ State: _____ Zip Code: _____</p> <p>Phone: _____ Fax: _____</p> <p>Email: _____</p>
--	---

<table border="1" style="width:100%; border-collapse: collapse;"> <tr> <th style="text-align: left;">Commercial Building Characteristics</th> <th style="text-align: left;">Residential Building Characteristics</th> </tr> <tr> <td>Height: _____</td> <td><input checked="" type="checkbox"/> SF Dwelling <input type="checkbox"/> SF Townhouse</td> </tr> <tr> <td>No. of stories: _____</td> <td style="text-align: center;">Depth Width</td> </tr> <tr> <td>Gross area, sq. ft./floor: _____</td> <td>1st floor: _____</td> </tr> <tr> <td>Area of construction (sq. ft.): _____</td> <td>2nd floor: _____</td> </tr> <tr> <td>Use group: _____</td> <td>Basement: _____</td> </tr> <tr> <td></td> <td><input type="checkbox"/> Finished Basement</td> </tr> <tr> <td></td> <td><input type="checkbox"/> Unfinished Basement</td> </tr> <tr> <td></td> <td><input type="checkbox"/> Crawl Space</td> </tr> <tr> <td></td> <td><input type="checkbox"/> Slab on Grade</td> </tr> <tr> <td>Construction type:</td> <td>No. of Bedrooms: _____</td> </tr> <tr> <td><input type="checkbox"/> Reinforced Concrete</td> <td>Multi-family Dwelling</td> </tr> <tr> <td><input type="checkbox"/> Structural Steel</td> <td>No. of efficiency units: _____</td> </tr> <tr> <td><input type="checkbox"/> Masonry</td> <td>No. of 1 BR units: _____</td> </tr> <tr> <td><input type="checkbox"/> Wood Frame</td> <td>No. of 2 BR units: _____</td> </tr> <tr> <td><input type="checkbox"/> State Certified Modular</td> <td>No. of 3 BR units: _____</td> </tr> <tr> <td></td> <td>Other Structure: _____</td> </tr> <tr> <td></td> <td>Dimensions: _____</td> </tr> <tr> <td>➤ Roadside Tree Project Permit</td> <td>Footings: _____</td> </tr> <tr> <td><input type="checkbox"/> Yes <input type="checkbox"/> No</td> <td>Roof: _____</td> </tr> <tr> <td>Roadside Tree Project Permit #</td> <td><input type="checkbox"/> State Certified Modular</td> </tr> <tr> <td></td> <td><input type="checkbox"/> Manufactured Home</td> </tr> </table>	Commercial Building Characteristics	Residential Building Characteristics	Height: _____	<input checked="" type="checkbox"/> SF Dwelling <input type="checkbox"/> SF Townhouse	No. of stories: _____	Depth Width	Gross area, sq. ft./floor: _____	1 st floor: _____	Area of construction (sq. ft.): _____	2 nd floor: _____	Use group: _____	Basement: _____		<input type="checkbox"/> Finished Basement		<input type="checkbox"/> Unfinished Basement		<input type="checkbox"/> Crawl Space		<input type="checkbox"/> Slab on Grade	Construction type:	No. of Bedrooms: _____	<input type="checkbox"/> Reinforced Concrete	Multi-family Dwelling	<input type="checkbox"/> Structural Steel	No. of efficiency units: _____	<input type="checkbox"/> Masonry	No. of 1 BR units: _____	<input type="checkbox"/> Wood Frame	No. of 2 BR units: _____	<input type="checkbox"/> State Certified Modular	No. of 3 BR units: _____		Other Structure: _____		Dimensions: _____	➤ Roadside Tree Project Permit	Footings: _____	<input type="checkbox"/> Yes <input type="checkbox"/> No	Roof: _____	Roadside Tree Project Permit #	<input type="checkbox"/> State Certified Modular		<input type="checkbox"/> Manufactured Home	<table border="1" style="width:100%; border-collapse: collapse;"> <tr> <th style="text-align: left;">Utilities</th> </tr> <tr> <td>Electric: <input type="checkbox"/> Yes <input type="checkbox"/> No</td> </tr> <tr> <td>Gas: <input type="checkbox"/> Yes <input type="checkbox"/> No</td> </tr> <tr> <td>Water Supply</td> </tr> <tr> <td><input type="checkbox"/> Public</td> </tr> <tr> <td><input type="checkbox"/> Private</td> </tr> <tr> <td>Sewage Disposal</td> </tr> <tr> <td><input type="checkbox"/> Public</td> </tr> <tr> <td><input type="checkbox"/> Private</td> </tr> <tr> <td>Heating System</td> </tr> <tr> <td><input type="checkbox"/> Electric <input type="checkbox"/> Oil</td> </tr> <tr> <td><input type="checkbox"/> Natural Gas <input type="checkbox"/> Propane Gas</td> </tr> <tr> <td><input type="checkbox"/> Other: _____</td> </tr> <tr> <td>Sprinkler System:</td> </tr> <tr> <td><input type="checkbox"/> Yes <input type="checkbox"/> No</td> </tr> <tr> <td>Grading Permit Number:</td> </tr> <tr> <td>Building Shell Permit Number:</td> </tr> </table>	Utilities	Electric: <input type="checkbox"/> Yes <input type="checkbox"/> No	Gas: <input type="checkbox"/> Yes <input type="checkbox"/> No	Water Supply	<input type="checkbox"/> Public	<input type="checkbox"/> Private	Sewage Disposal	<input type="checkbox"/> Public	<input type="checkbox"/> Private	Heating System	<input type="checkbox"/> Electric <input type="checkbox"/> Oil	<input type="checkbox"/> Natural Gas <input type="checkbox"/> Propane Gas	<input type="checkbox"/> Other: _____	Sprinkler System:	<input type="checkbox"/> Yes <input type="checkbox"/> No	Grading Permit Number:	Building Shell Permit Number:
Commercial Building Characteristics	Residential Building Characteristics																																																													
Height: _____	<input checked="" type="checkbox"/> SF Dwelling <input type="checkbox"/> SF Townhouse																																																													
No. of stories: _____	Depth Width																																																													
Gross area, sq. ft./floor: _____	1 st floor: _____																																																													
Area of construction (sq. ft.): _____	2 nd floor: _____																																																													
Use group: _____	Basement: _____																																																													
	<input type="checkbox"/> Finished Basement																																																													
	<input type="checkbox"/> Unfinished Basement																																																													
	<input type="checkbox"/> Crawl Space																																																													
	<input type="checkbox"/> Slab on Grade																																																													
Construction type:	No. of Bedrooms: _____																																																													
<input type="checkbox"/> Reinforced Concrete	Multi-family Dwelling																																																													
<input type="checkbox"/> Structural Steel	No. of efficiency units: _____																																																													
<input type="checkbox"/> Masonry	No. of 1 BR units: _____																																																													
<input type="checkbox"/> Wood Frame	No. of 2 BR units: _____																																																													
<input type="checkbox"/> State Certified Modular	No. of 3 BR units: _____																																																													
	Other Structure: _____																																																													
	Dimensions: _____																																																													
➤ Roadside Tree Project Permit	Footings: _____																																																													
<input type="checkbox"/> Yes <input type="checkbox"/> No	Roof: _____																																																													
Roadside Tree Project Permit #	<input type="checkbox"/> State Certified Modular																																																													
	<input type="checkbox"/> Manufactured Home																																																													
Utilities																																																														
Electric: <input type="checkbox"/> Yes <input type="checkbox"/> No																																																														
Gas: <input type="checkbox"/> Yes <input type="checkbox"/> No																																																														
Water Supply																																																														
<input type="checkbox"/> Public																																																														
<input type="checkbox"/> Private																																																														
Sewage Disposal																																																														
<input type="checkbox"/> Public																																																														
<input type="checkbox"/> Private																																																														
Heating System																																																														
<input type="checkbox"/> Electric <input type="checkbox"/> Oil																																																														
<input type="checkbox"/> Natural Gas <input type="checkbox"/> Propane Gas																																																														
<input type="checkbox"/> Other: _____																																																														
Sprinkler System:																																																														
<input type="checkbox"/> Yes <input type="checkbox"/> No																																																														
Grading Permit Number:																																																														
Building Shell Permit Number:																																																														

THE UNDERSIGNED HEREBY CERTIFIES AND AGREES AS FOLLOWS: (1) THAT HE/SHE IS AUTHORIZED TO MAKE THIS APPLICATION; (2) THAT THE INFORMATION IS CORRECT; (3) THAT HE/SHE WILL COMPLY WITH ALL REGULATIONS OF HOWARD COUNTY WHICH ARE APPLICABLE THERETO; (4) THAT HE/SHE WILL PERFORM NO WORK ON THE ABOVE REFERENCED PROPERTY NOT SPECIFICALLY DESCRIBED IN THIS APPLICATION; (5) THAT HE/SHE GRANTS COUNTY OFFICIALS THE RIGHT TO ENTER ONTO THIS PROPERTY FOR THE PURPOSE OF INSPECTING THE WORK PERMITTED AND POSTING NOTICES.

Applicant's Signature: CURTIS L. FIDLER Print Name: CURTIS L. FIDLER

Email Address: CFidler@lothorian.com Date: 5/29/19

Title/Company: LOTHORIAN, LLC

Checks Payable to: DIRECTOR OF FINANCE OF HOWARD COUNTY


****PLEASE WRITE NEATLY & LEGIBLY****
-FOR OFFICE USE ONLY-

AGENCY	DATE	SIGNATURE OF APPROVAL
State Highways		
Building Officials		
PSZA (Zoning)		
PSZA (Engineering)		
Health		

Is Sediment Control approval required for issuance? ☐ Yes ☐ No
☐ CONTINGENCY CONSTRUCTION START

DPZ SETBACK INFORMATION
Front: _____
Rear: _____
Side: _____
Side St.: _____
All minimum setbacks met? <input type="checkbox"/> Yes <input type="checkbox"/> No
Is Entrance Permit Required? <input type="checkbox"/> Yes <input type="checkbox"/> No
Historic District? <input type="checkbox"/> Yes <input type="checkbox"/> No
Lot Coverage for New Town Zone: _____
SDP/Red-line approval date: _____

Filing Fee	\$
Permit Fee	\$
Tech Fee	\$
Excise Tax	\$
PSFS	\$
Guaranty Fund	\$
Add'l per Fee	\$
Total Fees	\$
Sub-Total Paid	\$
Balance Due	\$
Check	#

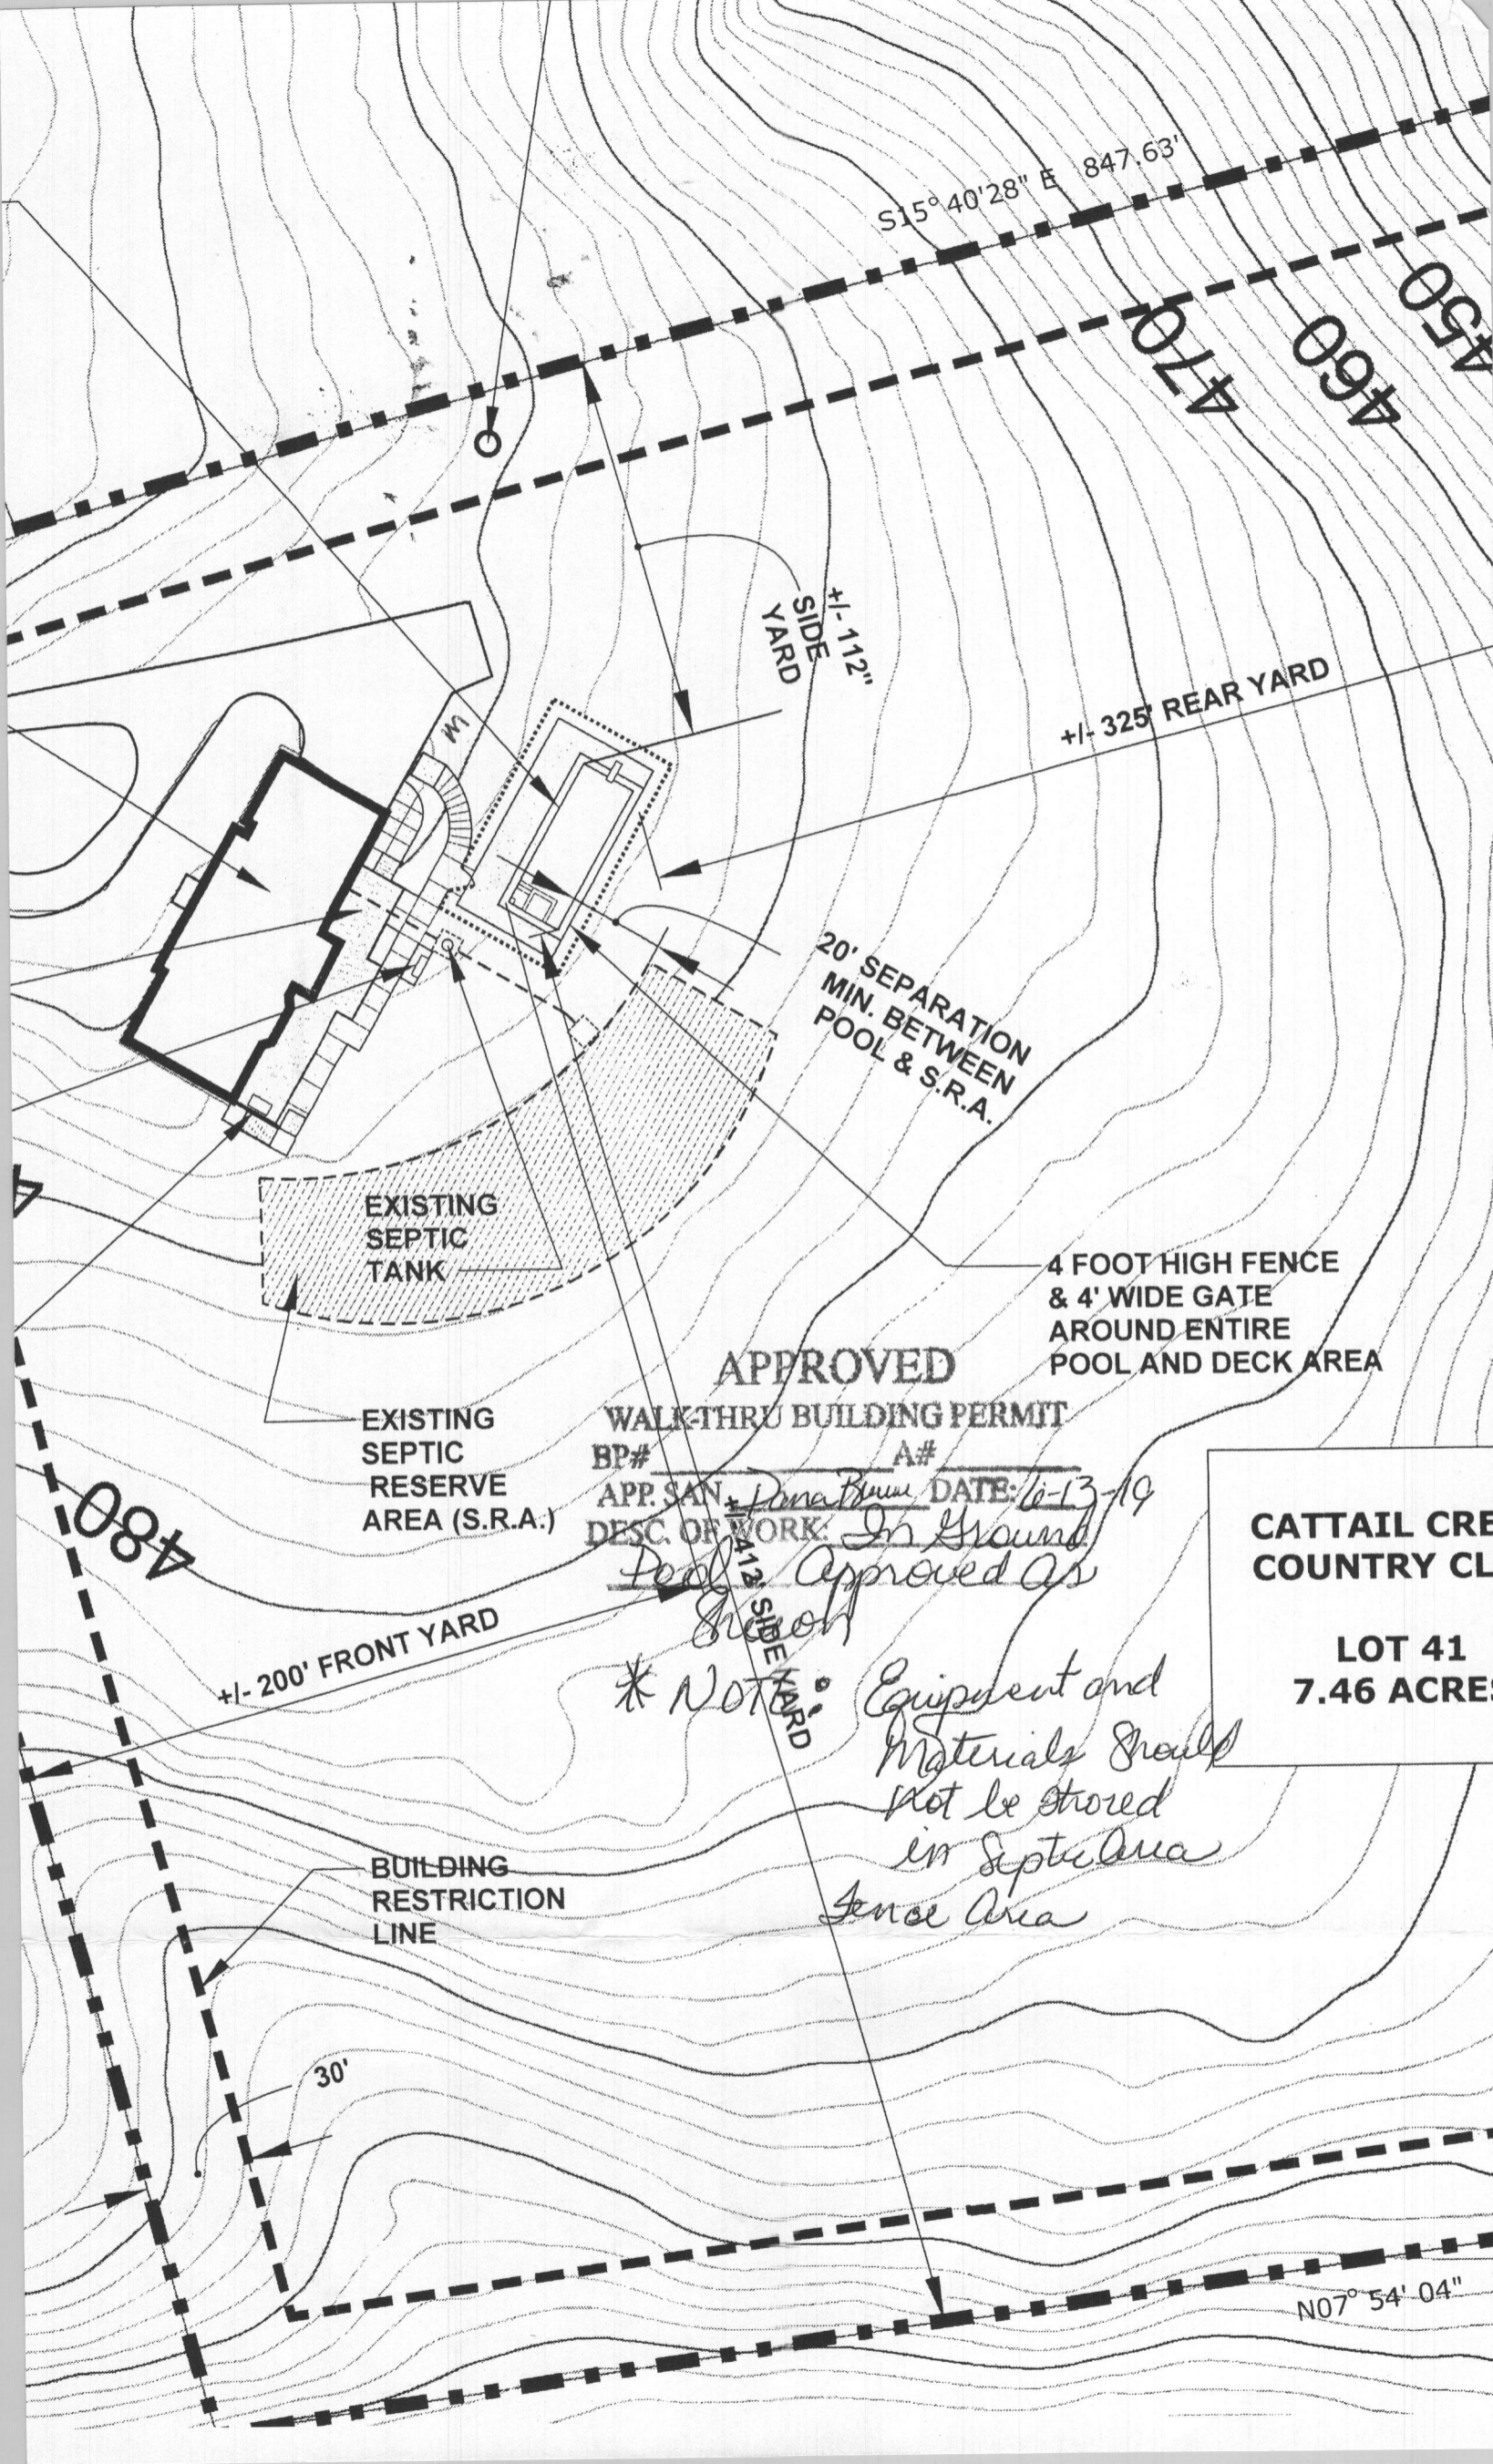

S15° 40' 28" E 847.63'

470

460

450

+/- 1112" SIDE YARD

+/- 325' REAR YARD

20' SEPARATION MIN. BETWEEN POOL & S.R.A.

4 FOOT HIGH FENCE & 4' WIDE GATE AROUND ENTIRE POOL AND DECK AREA

APPROVED

WALK-THRU BUILDING PERMIT

BP# _____ A# _____
APP. SAN. *Dana Brown* DATE: *6-13-19*
DESC. OF WORK: *In Ground Pool Approved as*

** NOTE: Equipment and Materials should not be stored in Septic Area Fence Area*

EXISTING SEPTIC RESERVE AREA (S.R.A.)

EXISTING SEPTIC TANK

+/- 200' FRONT YARD

BUILDING RESTRICTION LINE

30'

CATTAIL CREEK COUNTRY CLUB

LOT 41
7.46 ACRES

N07° 54' 04"