
DEPARTMENT OF INSPECTIONS, LICENSES AND PERMITS 3430 COURT HOUSE DRIVE ELLICOTT CITY, MD 21043 PERMITS (410) 313-4455 INSPECTIONS (410) 313-1610 AUTOMATED INSPENDED MAIN 313-3600

HOWARD COUNTY PERMIT APPLICATION

PERMIT NUMBER

		PLICATION	1001001	161
Building Address 3132 RIVET		Property Owner's Name	MATTHE	N &LAURA TOWL
WEST PRIENDSHIP MD 21794				
Suite/Apt. #: SDP/WP/Petition #:		Address 3132 PWER VALLEY CHASE		
Census Tract Subdivision W. FRIENDSKIP ESTS.		i J		
Section Area Lot33		Home Phone 489-4749 Work Phone 443-574-1929		
Tax Map Parcel Grid		Applicant's Name & Mailing Address, (if other than stated hereon):		
		17		ŕ
Zoning Map Coordinates Lot size		Phone V Fax		
Existing Use SFD WIDECK		Contractor Company		
Estimated Construction Cost \$ 10000		Contact Person RAY STEWARD		
Description of Work ZO X Z6 X B DECK				
_		Address 8216	BURNL	ey po
REPLACE (REPLACE) ON STEPS		City TOWSON State MD Zip Code 21 ZOL		
(EXISTING) ON REAR		License No. 324 Phone 410-494	34	
Occupant or Tenant		Engineer or Architect Co		
Contact Name_SEE_DWN	IEIZ	Contact Person	h / A	
			NIF	
Address		Address	10/	1
City State Zip Code				
Phone Fax		City	State	Zip Code
Priorie Fax		Phone	Fax	
BUILDING DESCRIPTION - COMMERCIAL		BUILDING DESCRIPTION - RESIDENTIAL		
Building Characteristics	<u>Utilities</u>	Building Charac	teristics	<u>Utilities</u>
Liniabir	Water Supply:	SF Dwelling SF To		Water Supply:
Height:	1 '''	I		Pablic
No. of stories:	Public Private	Depth 1st floor:	wnhouse □ <u>Width</u>	Prolic Private
No. of stories:	Public Private Sewage Disposal: Public	<u>Depth</u>		Parolic Private Sewage Disposal:Public
	Public Private Sewage Disposal: Public Private	Depth 1st floor: 2nd floor: Basement: Finished Basement □ Unfi	Width nished Basement□	Private Sewage Disposal: Private Private Private
No. of stories:	Public Private Sewage Disposal: Public	Depth 1st floor: 2nd floor: Basement: Finished Basement □ Unfi Crawl space □ Slab on No. of Bedrooms Height:	<u>Width</u> nished Basement⊡ Grade □	Parolic Private Sewage Disposal:Public
No. of stories: Gross area, sq. ft. per floor:	Public Private Sewage Disposal: Public Private Electric Yes No	Depth 1st floor: 2nd floor: Basement: Finished Basement □ Unfi Crawl space □ Slab on No. of Bedrooms Height: Multi-family dwellings: No. of efficiency units:	Width nished Basement□ Grade □	Private Sewage Disposal: Private Private Private Electric Yes No Gas Yes No Heating System:
No. of stories: Gross area, sq. ft. per floor: Use group: Construction type:	Public Private Sewage Disposal: Public Private Electric Yes No Gas Yes No Heating System: Electric Oil	Depth 1st floor: 2nd floor: Basement: Finished Basement □ Unfication Unit Crawl space □ Slab on No. of Bedrooms Height: Multi-family dwellings: No. of efficiency units: No. of 1 BR units: No. of 2 BR units:	Width nished Basement Grade	Patolic Private Sewage Disposal: Public Private Electric Yes No Gas Yes No Heating System: Electric Oil Natural Gas
No. of stories: Gross area, sq. ft. per floor: Use group: Construction type: Reinforced Concrete Structural Steel	Public Private Sewage Disposal: Public Private Electric Yes No Gas Yes No Heating System:	Depth 1st floor: 2nd floor: Basement: Finished Basement Unfiction	Width nished Basement Grade	Private Sewage Disposal: Public Private Electric Yes No Gas Yes No Heating System: Electric Oil Natural Gas Propane Gas
No. of stories: Gross area, sq. ft. per floor: Use group: Construction type: Reinforced Concrete	Public Private Sewage Disposal: Public Private Electric Yes No Heating System: Electric Oil Natural Gas Propane Gas Sprinkler system: N/A	Depth 1st floor: 2nd floor: Basement: Finished Basement Unfiction	Width nished Basement Grade	Parolic Private Sewage Disposal: Public Private Electric Yes No Gas Yes No Heating System: Electric Oil Natural Gas Propane Gas Sprinkler system: N/A NFPA #13D
No. of stories: Gross area, sq. ft. per floor: Use group: Construction type: Reinforced Concrete Structural Steel Masonry	Public Private Sewage Disposal: Public Private Electric Yes No Gas Yes No Heating System: Electric Oil Natural Gas Propane Gas Propane Gas	Depth 1st floor: 2nd floor: Basement: Finished Basement □ Unfication Unit Crawl space □ Slab on No. of Bedrooms Height: Multi-family dwellings: No. of efficiency units: No. of 1 BR units: No. of 2 BR units:	Width nished Basement Grade	Parolic Private Sewage Disposal: Public Private Electric Yes No Gas Yes No Heating System: Electric Oil Natural Gas Propane Gas Sprinkler system: N/A
No. of stories: Gross area, sq. ft. per floor: Use group: Construction type: Reinforced Concrete Structural Steel Masonry	Public Private Sewage Disposal: Public Private Electric Yes No Heating System: Electric Oil Natural Gas Propane Gas Sprinkler system: N/A Full	Depth 1st floor: 2nd floor: Basement: Finished Basement Crawl space Slab on No. of Bedrooms Height: Multi-family dwellings: No. of efficiency units: No. of 2 BR units: No. of 3 BR units: Other Structure: Dimensions: Cotings: Roof Height: State Certified Mo	Width mished Basement Grade Grade CCY CIDY PIER dular	Private Sewage Disposal: Public Private Electric Yes No Gas Yes No Heating System: Electric Oil Natural Gas Propane Gas Sprinkler system: N/A NFPA #13D NFPA #13R
No. of stories: Gross area, sq. ft. per floor: Use group: Construction type: Reinforced Concrete Structural Steel Masonry Wood Frame State Certified Modular	Public Private Sewage Disposal: Public Private Private Electric Yes No Heating System: Electric Oil Natural Gas Propane Gas Sprinkler system: N/A Partial Other Suppression # of Heads	Depth 1st floor: 2nd floor: Basement: Finished Basement Crawl space Slab on No. of Bedrooms Height: Multi-family dwellings: No. of efficiency units: No. of 1 BR units: No. of 2 BR units: No. of 3 BR units: Other Structure: Dimensions: Footings: Roof Height: State Certified Mo Manufactured Hor	Width mished Basement Grade Grade CCY CIDY PIER dular ne	Private Sewage Disposal: Public Private Electric Yes No
No. of stories: Gross area, sq. ft. per floor: Use group: Construction type: Reinforced Concrete Structural Steel Masonry Wood Frame	Public Private Sewage Disposal: Public Private Electric Yes□ No□ Heating System: Electric □ Oil □ Natural Gas □ Propane Gas □ Sprinkler system: N/A□ Full Partial Other Suppression # of Heads (1) THAT HE/SHE IS AUTHORIZED TO MAKE THIS APPLE SHE WILL PERFORM NO WORK ON THE ABOVE REFER	Depth 1st floor: 2nd floor: Basement: Finished Basement	Width nished Basement Grade Grade CCY KZLD X PIER dular ne correct; (3) That he/she we secribed in this application	Private Sewage Disposal: Public Private Electric Yes
No. of stories: Gross area, sq. ft. per floor: Use group: Construction type: Reinforced Concrete Structural Steel Masonry Wood Frame State Certified Modular The undersigned heriest certifies and agrees as follows: Howard County which are applicable thereto: (4) that he the right to enter byto the property for the purpose of	Public Private Sewage Disposal: Public Private Electric Yes□ No□ Heating System: Electric □ Oil □ Natural Gas □ Propane Gas □ Sprinkler system: N/A□ Full Partial Other Suppression # of Heads (1) THAT HE/SHE IS AUTHORIZED TO MAKE THIS APPLE SHE WILL PERFORM NO WORK ON THE ABOVE REFER	Depth 1st floor: 2nd floor: Basement: Finished Basement	Width mished Basement Grade Grade CCY CIDY PIER dular ne	Private Sewage Disposal: Public Private Electric Yes
No. of stories: Gross area, sq. ft. per floor: Use group: Construction type: Reinforced Concrete Structural Steel Masonry Wood Frame State Certified Modular The undersigned herest certifies and agrees as follows: HOWARD COUNTY WHICH are APPLICABLE THERETO: (4) THAT HE THE RIGHT TO ENTER DATE THE PURPOSE OF	Public Private Sewage Disposal: Public Private Electric Yes□ No□ Heating System: Electric □ Oil □ Natural Gas □ Propane Gas □ Sprinkler system: N/A□ Full Partial Other Suppression # of Heads (1) THAT HE/SHE IS AUTHORIZED TO MAKE THIS APPLE SHE WILL PERFORM NO WORK ON THE ABOVE REFER	Depth 1st floor: 2nd floor: Basement: Finished Basement	Width nished Basement Grade Grade CCY KZLD X PIER dular ne correct; (3) That he/she we secribed in this application	Private Sewage Disposal: Public Private Electric Yes
No. of stories: Gross area, sq. ft. per floor: Use group: Construction type: Reinforced Concrete Structural Steel Masonry Wood Frame State Certified Modular The undersioned herest certifies and agrees as follows: Howard County which are applicable thereto. (4) That he the right to enter byto the property for the purpose of Applicant's Signature Title/Company	Public Private Sewage Disposal: Public Private Electric Yes No Heating System: Electric Oil Natural Gas Propane Gas Sprinkler system: N/A Partial Other Suppression for Heads (1) THAT HE/SHE IS AUTHORIZED TO MAKE THIS APPLY SHE WILL PERFORM NO WORK ON THE ABOVE REFEE RESPECTING THE WORK PERMITTED AND POSTING NEED TO MAKE THIS APPLY SHE WILL PERFORM NO WORK ON THE ABOVE REFEE RESPECTING THE WORK PERMITTED AND POSTING NEED TO MAKE THIS APPLY SHE WILL PERFORM NO WORK ON THE ABOVE REFEE RESPECTING THE WORK PERMITTED AND POSTING NEED TO Checks payable to: DIRECTOR OF	Depth 1st floor: 2nd floor: Basement: Finished Basement	Width mished Basement Grade CCY CZLD X B PLER dular ne CORRECT; (3) THAT HE/SHE V ESCRIBED IN THIS APPLICATION STEWAT	Private Sewage Disposal: Public Private Electric Yes
No. of stories: Gross area, sq. ft. per floor: Use group: Construction type: Reinforced Concrete Structural Steel Masonry Wood Frame State Certified Modular The undersioned herest certifies and agrees as follows: Howard County which are applicable thereto. (4) That he the right to enter byto the property for the purpose of Applicant's Signature Title/Company	Public Private Sewage Disposal: Public Private Electric Yes □ No □ Heating System: Electric □ Oil □ Natural Gas □ Propane Gas □ Sprinkler system: N/A □ Full Partial Other Suppression # of Heads (1) THAT HE/SHE IS AUTHORIZED TO MAKE THIS APPI //SHE WILL PERFORM NO WORK ON THE ABOVE REFESE FINSPECTING THE WORK PERMITTED AND POSTING NO Checks payable to: DIRECTOR OF ** PLEASE WRITE NE	Depth 1st floor: 2nd floor: Basement: Finished Basement Crawl space Slab on No. of Bedrooms Height: Multi-family dwellings: No. of efficiency units: No. of 1 BR units: No. of 2 BR units: No. of 3 BR units: Other Structure: Dimensions: State Certified Mo Manufactured Hor ICATION; (2)THAT THE INFORMATION IS RENCED PROPERTY NOT SPECIFICALLY DOTICES.	Width mished Basement Grade CCY CZLD X B PLER dular ne CORRECT; (3) THAT HE/SHE V ESCRIBED IN THIS APPLICATION STEWAT	Private Sewage Disposal: Public Private Electric Yes
No. of stories: Gross area, sq. ft. per floor: Use group: Construction type: Reinforced Concrete Structural Steel Masonry Wood Frame State Certified Modular The undersioned herest certifies and agrees as follows: HOWARD COUNTY WHICH are APPLICABLE THERETO; (4) THAT HE THE RIGHT TO ENTER DITO THE PROPERTY FOR THE PURPOSE OF TITLE/Company AGENCY DATE	Public Private Sewage Disposal: Public Private Electric Yes □ No □ Heating System: Electric □ Oil □ Natural Gas □ Propane Gas □ Sprinkler system: N/A □ Full Partial Other Suppression # of Heads (1) THAT HE/SHE IS AUTHORIZED TO MAKE THIS APPI //SHE WILL PERFORM NO WORK ON THE ABOVE REFESE FINSPECTING THE WORK PERMITTED AND POSTING NO Checks payable to: DIRECTOR OF ** PLEASE WRITE NE	Depth 1st floor: 2nd floor: Basement: Finished Basement	Width nished Basement Grade COV COUNTY Mished Basement Grade COV COUNTY Mished Basement COV COUNTY COUNTY	Private Sewage Disposal: Public Private Electric Yes No Gas Yes No Heating System: Electric Oil Natural Gas Propane Gas Sprinkler system: N/A NFPA #13D NFPA #13R Other: WILL COMPLY WITH ALL REGULATIONS OF DN; (5) THAT HE/SHE GRANTS COUNTY OFFICIALS
No. of stories: Gross area, sq. ft. per floor: Use group: Construction type:	Public Private Sewage Disposal: Public Private Electric Yes No Gas Yes Yes No Gas Yes N	Depth 1st floor: 2nd floor: Basement: Finished Basement	Width nished Basement Grade CCY CZUD X B CULIAT THE SHE WESCRIBED IN THIS APPLICATION STEWAT COUNTY INFORMATION Filing	Private Sewage Disposal: Public Private Electric Yes
No. of stories: Gross area, sq. ft. per floor: Use group: Construction type:	Public Private Sewage Disposal: Public Private Electric Yes No Gas Yes No Heating System: Electric Oil Natural Gas Propane Gas Sprinkler system: N/A Full Partial Other Suppression # of Heads (1) THAT HE/SHE IS AUTHORIZED TO MAKE THIS APPLY SHE WILL PERFORM NO WORK ON THE ABOVE REFER ENSPECTING THE WORK PERMITTED AND POSTING NOTES OF THE WORK PE	Depth 1st floor: 2nd floor: Basement: Finished Basement Unficerawl space Slab on No. of Bedrooms Height: Multi-family dwellings: No. of efficiency units: No. of 1 BR units: No. of 2 BR units: No. of 3 BR units: Other Structure: Dimensions: Footlings: State Certified Mo Manufactured Hor Manufactured Hor INCATION; (2)THAT THE INFORMATION IS RENCED PROPERTY NOT SPECIFICALLY DOTICES. Print Name Date FINANCE OF HOWARD CATLY AND LEGIBLY.** EUSE ONLY DPZ SETBACK Front: Reser: Side:	Width mished Basement Grade G	Private Sewage Disposal: Public Private Electric Yes No Gas Yes No Heating System: Electric Oil Natural Gas Propane Gas Sprinkler system: N/A NFPA #13D NFPA #13R Other: MILL COMPLY WITH ALL REGULATIONS OF ON; (5) THAT HE/SHE GRANTS COUNTY OFFICIALS PROPERTY ID# PROPERTY ID#
No. of stories: Gross area, sq. ft. per floor: Use group: Construction type:	Public Private Sewage Disposal: Public Private Electric Yes No Gas Yes No Heating System: Electric Oil Natural Gas Propane Gas Sprinkler system: N/A Full Partial Other Suppression # of Heads (1) THAT HE/SHE IS AUTHORIZED TO MAKE THIS APPLY SHE WILL PERFORM NO WORK ON THE ABOVE REFER FROM THE WORK PERMITTED AND POSTING NOTES AND POST	Depth 1st floor: 2nd floor: Basement: Finished Basement Unficerawl space Slab on No. of Bedrooms Height: Multi-family dwellings: No. of efficiency units: No. of 1 BR units: No. of 2 BR units: No. of 3 BR units: No. of 3 BR units: Other Structure: Dimensions: Footings: State Certified Mo Manufactured Hor LICATION; (2)THAT THE INFORMATION IS RENCED PROPERTY NOT SPECIFICALLY DOTICES. Print Name Date FINANCE OF HOWARD OF ATLY AND LEGIBLY.** DPZ SETBACK Front: Reser: Side: S	Width mished Basement Grade G	Private Sewage Disposal: Public Private Electric Yes No Gas Yes No Heating System: Electric Oil Natural Gas Propane Gas Sprinkler system: N/A NFPA #13D NFPA #13R Other: MILL COMPLY WITH ALL REGULATIONS OF ON; (5) THAT HE/SHE GRANTS COUNTY OFFICIALS PROPERTY ID: PROPERTY ID: PROPE
No. of stories: Gross area, sq. ft. per floor: Use group: Construction type: Reinforced Concrete Structural Steel Masonry Wood Frame State Certified Modular The undersioned herest certifies and agrees as follows: Howard County which are applicable thereto; (4) that he the right to enter byto the property for the purpose of Applicant's Signature Applicant's Signature AGENCY DATE Land Development DPZ State Hiotograph Building Official Dev. Engineering DPZ Fig. Protection	Public Private Sewage Disposal: Public Private Electric Yes No Gas Yes No Heating System: Electric Oil Natural Gas Propane Gas Sprinkler system: N/A Full Partial Other Suppression # of Heads (1) THAT HE/SHE IS AUTHORIZED TO MAKE THIS APPLY SHE WILL PERFORM NO WORK ON THE ABOVE REFER FINSPECTING THE WORK PERMITTED AND POSTING NO POSTING NO PUBLIC PRIVATE OF THE WORK PERMITTED AND POSTING NO PUBLISHED TO PUBLISH WRITE NEW PLEASE WRITE NEW PLE	Depth 1st floor: 2nd floor: Basement: Finished Basement □ Unfi Crawl space □ Slab on No. of Bedrooms Height: No. of efficiency units: No. of 1 BR units: No. of 2 BR units: No. of 3 BR units: No. of 3 BR units: Other Structure: Dimensions: Pootings: Roof Height: State Certified Mo Manufactured Hor Ication; (2) That The Information is renced Property Not specifically bottles. Print Name FINANCE OF HOWARD CATLY AND LEGIBLY.** DPZ SETBACK Front: Reset: Side St. All minimum setbacks man? YES □ NO □	Width mished Basement Grade G	Private Sewage Disposal: Public Private Electric Yes No Gas Yes No Heating System: Electric Oil Natural Gas Propane Gas Sprinkler system: N/A NFPA #13D NFPA #13R Other: PROPERTY IDE: Itee S Int fee
No. of stories: Gross area, sq. ft. per floor: Use group: Construction type:	Public Private Sewage Disposal: Public Private Electric Yes No Gas Yes No Heating System: Electric Oil Natural Gas Propane Gas Sprinkler system: N/A Full Partial Other Suppression # of Heads (1) THAT HE/SHE IS AUTHORIZED TO MAKE THIS APPLY SHE WILL PERFORM NO WORK ON THE ABOVE REFER FINSPECTING THE WORK PERMITTED AND POSTING NO POSTING NO PUBLIC PRIVATE OF THE WORK PERMITTED AND POSTING NO PUBLISHED TO PUBLISH WRITE NEW PLEASE WRITE NEW PLE	Depth 1st floor: 2nd floor: Basement: Finished Basement Unficerawl space Slab on No. of Bedrooms Height: Multi-family dwellings: No. of efficiency units: No. of 1 BR units: No. of 2 BR units: No. of 3 BR units: No. of 3 BR units: Other Structure: Dimensions: Footlings: State Certified Mo Manufactured Hor Manufactured Hor Definition of Print Name Print Name Date FINANCE OF HOWARD CATLY AND LEGIBLY. EUSE ONLY DPZ SETBACK Front: Reser: Side: Side St: All minimum setbacks mat? YES D NO D Is Entrance Pen	Width mished Basement Grade G	Private Sewage Disposal: Public Private Electric Yes No Gas Yes No Heating System: Electric Oil Natural Gas Propane Gas Sprinkler system: N/A NFPA #13D NFPA #13R Other: NFPA #13R Other: PROPERTY IDE: Tee S S S S S S S S S
No. of stories: Gross area, sq. ft. per floor: Use group: Construction type:	Public Private Sewage Disposal: Public Private Electric Yes No Gas Yes No Heating System: Electric Oil Natural Gas Propane Gas Sprinkler system: N/A Full Partial Other Suppression # of Heads (1) THAT HE/SHE IS AUTHORIZED TO MAKE THIS APPLY SHE WILL PERFORM NO WORK ON THE ABOVE REFERENCE THIS PECTING THE WORK PERMITTED AND POSTING NOTES TO BE WILL PERFORM THE WORK PERMITTED AND POSTING NOTES TO BE WITTEN THE WORK PERMITTED TO BE W	Depth 1st floor: 2nd floor: Basement: Finished Basement	Width mished Basement Grade G	Private Sewage Disposal: Public Private Electric Yes No Gas Yes No Heating System: Electric Oil Natural Gas Propane Gas Sprinkler system: N/A NFPA #13D NFPA #13R Other: NFPA #13R Other: PROPERTY IDE: Tee S S S S S S S S S
No. of stories: Gross area, sq. ft. per floor: Use group: Construction type:	Public Private Sewage Disposal: Public Private Electric Yes No Gas Yes No Heating System: Electric Oil Natural Gas Propane Gas Sprinkler system: N/A Full Partial Other Suppression # of Heads (1) THAT HE/SHE IS AUTHORIZED TO MAKE THIS APPLY SHE WILL PERFORM NO WORK ON THE ABOVE REFERENCE THIS PECTING THE WORK PERMITTED AND POSTING NOTES TO BE WILL PERFORM THE WORK PERMITTED AND POSTING NOTES TO BE WITTEN THE WORK PERMITTED TO BE W	Depth 1st floor: 2nd floor: Basement: Finished Basement	Width mished Basement Grade G	Private Sewage Disposal: Public Private Electric Yes No Gas Yes No Heating System: Electric Oil Natural Gas Propane Gas Sprinkler system: N/A NFPA #13D NFPA #13R Other: NFPA #13R Other: PROPERTY IDE: See
No. of stories: Gross area, sq. ft. per floor: Use group: Construction type:	Public Private Sewage Disposal: Public Private Electric Yes No Gas Yes No Heating System: Electric Oil Natural Gas Propane Gas Sprinkler system: N/A Full Partial Other Suppression # of Heads (1) THAT HE/SHE IS AUTHORIZED TO MAKE THIS APPLY SHE WILL PERFORM NO WORK ON THE ABOVE REFER REPORTING THE WORK PERMITTED AND POSTING NO POSTING NO PUBLIC PROPERTY OF THE WORK PERMITTED AND PO	Depth 1st floor: 2nd floor: Basement: Finished Basement	Width mished Basement Grade G	Private Sewage Disposal: Public Private Electric Yes No Gas Yes No Heating System: Electric Oil Natural Gas Propane Gas Sprinkler system: N/A NFPA #13D NFPA #13R Other: PROPERTY IDE The fee The

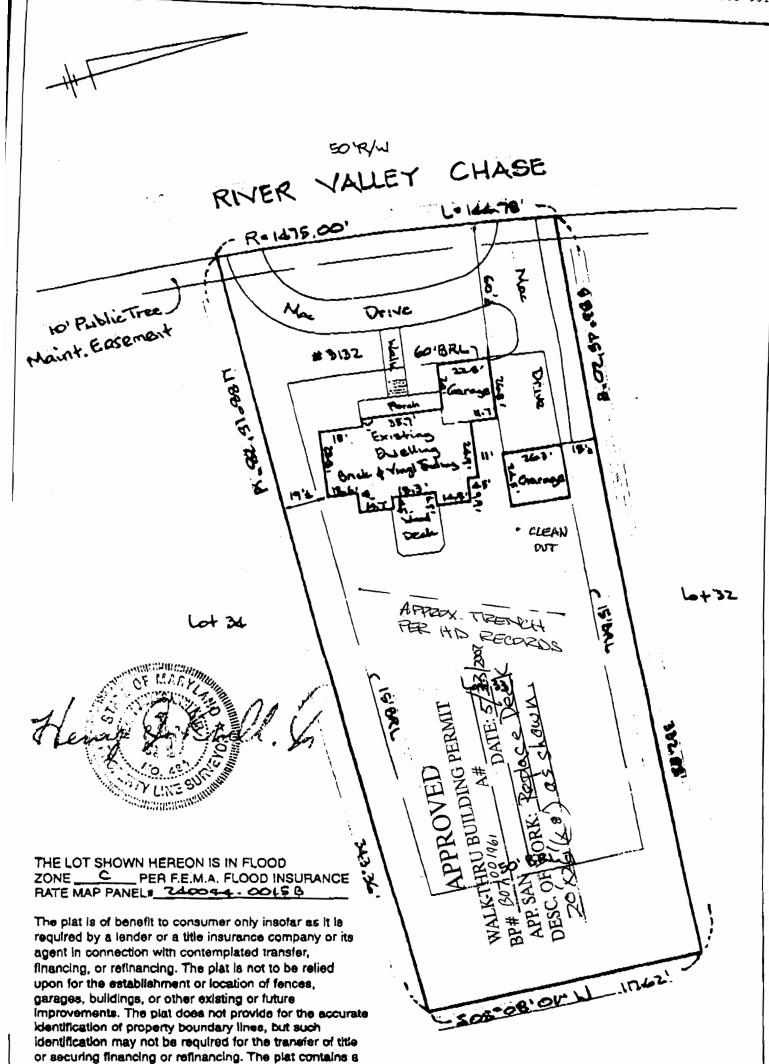

Ertel Associates, Inc.

tolerance of accuracy of two feet, more or less.

8425 Hallmark Circle
Baltimore, Maryland 21234
Phone: 410-882-0989 * Fax: 410-882-0842

LOCATION DRAWING

3132 RIVER VALLEY CHASE; LOT 33

"WEST FRENDSHIP GSTRYES, SECTION!"

HOWARD CO., MD. PLAY MDR 11434

DATE: 4 17/07 SCALE: 142 40' 07-281 HT