
DEPARTMENT OF REPRECITORS, LICENSES AND PERMITS MAD COURT HOUSE DIVING: ELECOTT CIT, NO 21043 PERMITS (410) 314-349 REPRECIONE (410) 313-3810 AUTOMATED REPORTMENT (410) 313-3800		COUNTY	\sim	MIT NUMBER
Building Address 3184 RIVER				STEVE MORRISON
_	,	[·		
WEST FRIENDSHIP, MD 21794		3184 RIVER VALLEY CHASE		
Suite/Apt. #: SDP/WP/Petition #:		City WEST FRISHASHIP State MD Zip Code 21794		
Census Tract Subdivision W. FRIENDTHIP EST.				
Section Area Lot Lot		Phone 40-489-4736 Phone Applicant's Name & Mailing Address, (if other than stated hereon):		
		Applicant 3 Hame & Ha	g / 135/ 050, (ii 01	and than diated hereony.
Tax Map Parcel Grid		Phone	Fax	
Zoning Map Coordinates Lot size				
Existing Use EXTERIOR DECK		Contractor Company A.J. De Luca Contractors		
Proposed Use SAME WITH ENCLOSED UNDERNEATH		2.1.12		
Estimated Construction Cost \$ 20,000		MATT HAWN		
Description of Work CLOSE - IN WASERNEATH OF		Address LIBERTY RD		
EXISTING DECK TO CREATE SWROOM		-		
		City E18E05 8URG State MD Zip Code 21784		
		Phone 410-552-4512 Fax 410-552-4532		
Occupant or Tenant MR+ MRS STEVE MORRISON		Engineer or Architect Company		
Contact Name STEUE MORRISON		Contact Person		
Address 3184 RIVER VALLEY CHASE		Address	_	
City W. FRIENDSHIP State MA Zip Code 21794		,		
		City State Zip Code,		
Phone 4/0 - 4/89 - 4/3 L Fax		Phone Fax		
BUILDING DESCRIPTION - COMMERCIAL		BUILDING DESCRIPTION - RESIDENTIAL		
Building Characteristics	Utilities	Building Charac	cteristics	Utilities
Height:	Water Supply:	SF Dwelling X SF To		Water Supply:
	Public	Depth 1st floor:	Width	Public Private
No. of stories:	Private Sewage Disposal:	2nd floor:		Sewage Disposal:
Gross area, sq. ft. per floor:	Public Private	Basement:		Public Private
Gross area, sq. n. per noor.		Finished Basement Unfi	nished Basement	Electric Yes □ No □
Use group:	Electric Yes □ No □ Gas Yes □ No □	Crawl space Slab on No. of Bedrooms		Gas Yes No
	Heating System:	Height: Multi-family dwellings:		Heating System:
Construction type:	Electric Oil 🗆	No. of efficiency units:		Electric Oil Natural Gas
Reinforced Concrete Structural Steel	Natural Gas ☐ Propane Gas ☐	No. of 1 BR units: No. of 2 BR units:		Propane Gas
Masonry		No. of 3 BR units:		Sprinkler system: N/A □
Wood Frame	Sprinkler system: N/A Full	Other Structure: Dimensions:		NFPA #13D NFPA #13R
State Certified Modular	Partial Other Suppression	Footings: Roof Height:		Other:
State Certified Modular	# of Heads	State Certified Mo	dular	
		Manufactured Ho		
	1	-		
THE UNDERSIGNED HEREBY CERTIFIES AND AGREES AS FOLLOW HOWARD COUNTY WHICH ARE APPLICABLE THERETO; (4) THAT I	IE/SHE WILL PERFORM NO WORK ON THE ABOVE RI	APPLICATION; (2)THAT THE INFORMATION EFERENCED PROPERTY NOT SPECIFICAL	N IS CORRECT: (3) THAT HE	E/SHE WILL COMPLY WITH ALL REGULATIONS OF PLICATION: (5) THAT HE/SHE GRANTS COUNTY
THE UNDERSIGNED HEREBY CERTIFIES AND AGREES AS FOLLOW HOWARD COUNTY WHICH ARE APPLICABLE THERETO; (4) THAT TO OFFICIALS THE RIGHT TO ENTER ONTO THIS PROPERTY FOR THE I	IE/SHE WILL PERFORM NO WORK ON THE ABOVE RI	APPLICATION; (2)THAT THE INFORMATION EFERENCED PROPERTY NOT SPECIFICAL	N IS CORRECT: (3) THAT HE	E/SHE WILL COMPLY WITH ALL REGULATIONS OF PLICATION: (5) THAT HE/SHE GRANTS COUNTY
HOWARD COUNTY WHICH ARE APPLICABLE THERETO; (4) THAT I OFFICIALS THE RIGHT TO ENTER ONTO THIS PROPERTY FOR THE I	IE/SHE WILL PERFORM NO WORK ON THE ABOVE RI	APPLICATION; (2)THAT THE INFORMATIC EFERENCED PROPERTY NOT SPECIFICA ND POSTING NOTICES.	N IS CORRECT: (3) THAT HE	EISHE WILL COMPLY WITH ALL REQUIATIONS OF PLICATION: (5) THAT HEISHE GRANTS COUNTY
HOMAND COUNTY WHICH ARE APPLICABLE THERETO; (4) THAT I OFFICIALS THE RIGHT TO ENTER ONT OFFICIALS THE RIGHT TO ENTER ONT OFFICIALS PROPERTY FOR THE I Applicant's Signature Supples 1502 / A, J. Dell	HE/SHE WILL PERFORM NO WORK ON THE ABOVE RI PURPOSE OF INSPECTING THE WORK PERMITTED A	APPLICATION, (2)THAT THE INFORMATIC EFERENCED PROPERTY NOT SPECIFICA MID POSTING NOTICES. MATT Print Name 6-25-08	N IS CORRECT; (3) THAT HE LLY DESCRIBED IN THIS APP	EISHE WILL COMPLY WITH ALL REGULATIONS OF FLUCATION: (5) THAT HEISHE GRANTS COUNTY
HOWAND COUNTY WHICH ARE APPLICABLE THERETO; (4) THAT I OFFICIALS THE RIGHT TO ENTER ONTO THIS PROPERTY FOR THE I Applicant's Signature Supersilsor Title/Company	NE/SHE WILL PERFORM NO WORK ON THE ABOVE RIP PURPOSE OF INSPECTING THE WORK PERMITTED A NEA	APPLICATION (2) THAT THE INFORMATIC EFERENCED PROPERTY NOT SPECIFICA MO POSTING NOTICES. Print Name 6-25-03 Date FINANCE OF HOWARD	N IS CORRECT; (3) THAT HILLY DESCRIBED IN THIS APP	EISHE WILL COMPLY WITH ALL REGULATIONS OF PLECATION: (5) THAT HEISHE GRANTS COUNTY
HOWARD COUNTY WHICH ARE APPLICABLE THERETO; (4) THAT I OFFICIALS THE RIGHT TO ENTER ONTO THIS PROPERTY FOR THE I Applicant's Signature Supervisor / A, J. Delle Title/Company	HE/SHE WILL PERFORM NO WORK ON THE ABOVE RIP PURPOSE OF INSPECTING THE WORK PERMITTED A HEAD CONT. Checks payable to: DIRECTOR OF " PLEASE WRITE NE. FOR OFFICE	APPLICATION; (2)THAT THE INFORMATIC EFERENCED PROPERTY NOT SPECIFICA HID POSTING NOTICES. MATT Print Name 6-25-05 Date FINANCE OF HOWARD ATLY AND LEGIBLY. EUSE ONLY.	NIS CORRECT; (3) THAT HILLY DESCRIBED IN THIS APPLIED TO SECOUNTY	PLICATION: (5) THAT HEISHE GRANTS COUNTY
HOWARD COUNTY WHICH ARE APPLICABLE THERETO; (4) THAT I OFFICIALS THE RIGHT TO ENTER ONTO THIS PROPERTY FOR THE I Applicant's Signature Supervisor AJ. Title/Company AGENCY. DATE	HE'SHE WILL PERFORM NO WORK ON THE ABOVE RIP PURPOSE OF INSPECTING THE WORK PERMITTED A HEA CONT. Checks payable to: DIRECTOR OF "PLEASE WRITE NE. FOR OFFIC SIGNATURE APPROVAL	APPLICATION; (2)THAT THE INFORMATIC EFERENCED PRIOPERTY HOT SPECIFICA MO POSTING NOTICES. MA-77 Print Name (25	NIS CORRECT; (3) THAT HILLY DESCRIBED IN THIS APPLICATION OF THE SERVICE OF THE S	PROPERTY IDE
HOWARD COUNTY WHICH ARE APPLICABLE THERETO; (4) THAT I OFFICIALS THE RIGHT TO ENTER ONTO THIS PROPERTY FOR THE I Applicant's Signature Supervisor A, J. Delle AGENCY DATE Land Development, OPZ	HE/SHE WILL PERFORM NO WORK ON THE ABOVE RIP PURPOSE OF INSPECTING THE WORK PERMITTED A HEA CONT. Checks payable to: DIRECTOR OF PLEASE WRITE NEI FOR OFFIC SIGNATURE APPROVAL	APPLICATION; (2)THAT THE INFORMATIC EFERENCED PROPERTY NOT SPECIFICA HID POSTING NOTICES. MATT Print Name 6-25-05 Date FINANCE OF HOWARD ATLY AND LEGIBLY. EUSE ONLY.	NIS CORRECT; (3) THAT HILLY DESCRIBED IN THIS APPLICATION COUNTY EIIN	PLICATION: (5) THAT HEISHE GRANTS COUNTY
HOWARD COUNTY WHICH ARE APPLICABLE THERETO; (4) THAT I OFFICIALS THE RIGHT TO ENTER ONTO THIS PROPERTY FOR THE I Applicant's Signature Supeevises A.J. Delle AGENCY AGENCY Land Development, DPZ Slate Highways Building Official	WEAL PERFORM NO WORK ON THE ABOVE RIP PURPOSE OF INSPECTING THE WORK PERMITTED A WEAL CONT. Checks payable to: DIRECTOR OF PLEASE WRITE NE. FOR OFFICE SIGNATURE APPROVAL	APPLICATION, (2) THAT THE INFORMATIC EFERENCED PROPERTY NOT SPECIFICA MO POSTING NOTICES. MA-77 Print Name 6-25-09 Date FFINANCE OF HOWARD (A TALLY AND LEGIBLY. " EUSE ONLY" DPZ SETBACK Front: Rear: Side:	NIS CORRECT; (3) THAT HILLY DESCRIBED IN THIS APPLICATION COUNTY INFORMATION Filin Exc.	PROPERTY IDEL g fee \$
HOWARD COUNTY WHICH ARE APPLICABLE THERETO; (4) THAT I OFFICIALS THE RIGHT TO ENTER ONTO THIS PROPERTY FOR THE I Applicant's Signature SUPERVISOR TITLE/Company AGENCY: Land Development, DPZ: State Highways Building Official Dev. Engineering, DPZ	HE/SHE WILL PERFORM NO WORK ON THE ABOVE RIP PURPOSE OF INSPECTING THE WORK PERMITTED A WAR CONT. Checks payable to: DIRECTOR OF PLEASE WRITE NE. FOR OFFICE SIGNATURE APPROVAL	APPLICATION, (2) THAT THE INFORMATIC EFERENCED PROPERTY NOT SPECIFICA MO POSTING NOTICES. MATT Print Name 6-25-08 Date FINANCE OF HOWARD (A ATLY AND LEGIBLY. " EFEUSE ONLY." DPZ SETBACK Front: Rear: Side: Side: Side St.;	NIS CORRECT; (3) THAT HILLY DESCRIBED IN THIS APPLICATION COUNTY INFORMATION Filin Perr Excl. Add	PROPERTY IDM g fee \$
HOWARD COUNTY WHICH ARE APPLICABLE THERETO; (4) THAT I OFFICIALS THE RIGHT TO ENTER ONTO THIS PROPERTY FOR THE I Applicant's Signature SUPEEN 1508 A.J. DELLE Title/Company AGENCY DATE Land Development, DPZ State Highways Building Official Dev. Engineering, DPZ Health (A) \$10 Y	HE/SHE WILL PERFORM NO WORK ON THE ABOVE RIP PURPOSE OF INSPECTING THE WORK PERMITTED A WAR CONT. Checks payable to: DIRECTOR OF PLEASE WRITE NE. FOR OFFICE SIGNATURE APPROVAL	APPLICATION; (2)THAT THE INFORMATIC EFERENCED PROPERTY HOT SPECIFICA MP POSTING NOTICES. MATT Print Name (-25-C) Date FINANCE OF HOWARD ATLY AND LEGIBLY. EUSE ONLY TOPZ SETBACK Front: Reat: Side: Side St.; Alf minimum setbacks met?	NIS CORRECT; (3) THAT HILLY DESCRIBED IN THIS APPLICATION COUNTY INFORMATION Filin Perr Exc. Add	PROPERTY IDEL g fee \$
HOWARD COUNTY WHICH ARE APPLICABLE THERETO; (4) THAT I OFFICIALS THE RIGHT TO ENTER ONTO THIS PROPERTY FOR THE I Applicant's Signature SUPERVISOR TITLE/Company AGENCY Land Development, DPZ State Highways Building Official Dev. Engineering, DPZ	ILE SHE WILL PERFORM NO WORK ON THE ABOVE REPURPOSE OF INSPECTING THE WORK PERMITTED A LACK CONT. Checks payable to: DIRECTOR OF PLEASE WRITE NEW PLEASE WRITE NEW FOR OFFICE SIGNATURE APPROVAL	APPLICATION, (2) THAT THE INFORMATIC EFERENCED PROPERTY NOT SPECIFICA MO POSTING NOTICES. MATT Print Name 6-25-08 Date FINANCE OF HOWARD (A ATLY AND LEGIBLY. " EFEUSE ONLY." DPZ SETBACK Front: Rear: Side: Side: Side St.;	NIS CORRECT; (3) THAT HILLY DESCRIBED IN THIS APPLIANCE OF THE COUNTY INFORMATION Film Perr Perr Add TOT	PROPERTY IDM. g fee \$
HOWAND COUNTY WHICH ARE APPLICABLE THERETO; (4) THAT I OFFICIALS THE ROHT OF ENTER ONTO HIS PROPERTY FOR THE I Applicant's Signature Supervisor A.J. Sell Title/Company AGENCY. DATE Land Development, DPZ. State Highways Building Official Dev. Engineering, DPZ. Health Land Development, DPZ.	ILE SHE WILL PERFORM NO WORK ON THE ABOVE REPURPOSE OF INSPECTING THE WORK PERMITTED A LACK CONT. Checks payable to: DIRECTOR OF PLEASE WRITE NEW PLEASE WRITE NEW FOR OFFICE SIGNATURE APPROVAL	APPLICATION; (2)THAT THE INFORMATIC EFERENCED PRIOPERTY HOT SPECIFICA MATTHEFE Print Name (-25-0) Date FINANCE OF HOWARD ATTHEFE DPZ SETBACK Front: Rear: Side St.; All minimum setbacks met YES D NO D IS Entrance Pen YES D NO D	NIS CORRECT; (3) THAT HILLY DESCRIBED IN THIS APPLIANCE OF THE APPLIANCE O	PROPERTY ID# pr
HOWAND COUNTY WHICH ARE APPLICABLE THERETO; (4) THAT I OFFICIALS THE RIGHT TO ENTER ONTO HIS PROPERTY FOR THE I Applicant's Signature Supervisor A.J. Sull AGENCY DATE Land Development, OPZ State Highways Building Official Dev. Engineering, DPZ Health Fire Protection Is Sediment Control approval required prior to YES D NO D	HE'SHE WILL PERFORM NO WORK ON THE ABOVE REPURPOSE OF INSPECTING THE WORK PERMITTED A LONG. CHECKS PAYABLE to: DIRECTOR OF PLEASE WRITE NEW PORTOFFIC SIGNATURE APPROVAL.	APPLICATION; (2)THAT THE INFORMATIC EFERENCED PRIOPERTY HOT SPECIFICA MO POSTING NOTICES. MA_TT Print Name (25-0) Date FINANCE OF HOWARD (A ATLY AND LEGIBLY." EUSE ONLY EUSE ONLY Side SI: Alf minimum setbacks met' [S Entrance Pen YES [] NO [] Historic District?	NIS CORRECT; (3) THAT HILLY DESCRIBED IN THIS APPLIANCE OF THE APPLIANCE O	g fee \$ PROPERTY IDM g fee \$ See tax 1 Per fee
Applicant's Signature Applicant's Signature Applicant's Signature Title/Company AGENCY Land Development, DPZ State Highways Building Official Dev Engineering, DPZ Health Fire Protection Is Sediment Control approval required prior to	CA CONT. Checks payable to: DIRECTOR OF PLEASE WRITE NEW PORTIES NEW PROPERTY OF THE WORK PERMITTED A PLEASE WRITE NEW PORTIES NEW PORTIE	APPLICATION; (2)THAT THE INFORMATIC EFERENCED PRIOPERTY HOT SPECIFICA MATTHEFE Print Name (-25-0) Date FINANCE OF HOWARD ATTHEFE DPZ SETBACK Front: Rear: Side St.; All minimum setbacks met YES D NO D IS Entrance Pen YES D NO D	NIS CORRECT; (3) THAT HILLY DESCRIBED IN THIS APPLICATION COUNTY INFORMATION Filin Exc. Add Tour Tilt required? Bala Vali	PROPERTY ID# p fee \$ int fee \$ ise tax \$ I per fee \$ ALT FEES \$ -lotal paid \$ ance due \$ ance
Applicant's Signature Applicant's Signature Supervisor Affency DATE Land Development, DPZ State Highways Building Official Dev Engineering, DPZ Health Its Sediment Control approval required prior to WES DENO CE	HE'SHE WILL PERFORM NO WORK ON THE ABOVE RIPPURPOSE OF INSPECTING THE WORK PERMITTED A LOCAL CONT. Checks payable to: DIRECTOR OF PLEASE WRITE NEW PICKSE WRITE NEW POR OFFICE SIGNATURE APPROVAL DISSUANCE?	APPLICATION, (2)THAT THE INFORMATIC FERENCED PROPERTY NOT SPECIFICA MA_TT Print Name	NIS CORRECT; (3) THAT HILLY DESCRIBED IN THIS APPLICATION COUNTY INFORMATION Filin Exc. Add Total Total Che Vali	PROPERTY IDS. g fee Stax Stax Star Star Star Star Star Star Star Star
Applicant's Signature Applicant's Signature Supervisor Arithe/Company AGENCY DATE Land Development, OPZ State Highways Building Official Dev. Engineering, DPZ Health Is Sedment Control approval required prior to YES DENO CONSTRUCTION	HE'SHE WILL PERFORM NO WORK ON THE ABOVE RIPPURPOSE OF INSPECTING THE WORK PERMITTED A LOCAL CONT. Checks payable to: DIRECTOR OF PLEASE WRITE NEW FOR OFFICE SIGNATURE APPROVAL DISSUANCE?	APPLICATION, (2) THAT THE INFORMATIC FERENCED PROPERTY NOT SPECIFICA MA_TT Print Name	NIS CORRECT; (3) THAT HILLY DESCRIBED IN THIS APPLICATION COUNTY INFORMATION Filin Exc. Add Total Total Che Vali	PROPERTY IDE Gree S mit fee S ise tax S I per, fee S AL FEES S -iclail paid S ance due S ck # dation #

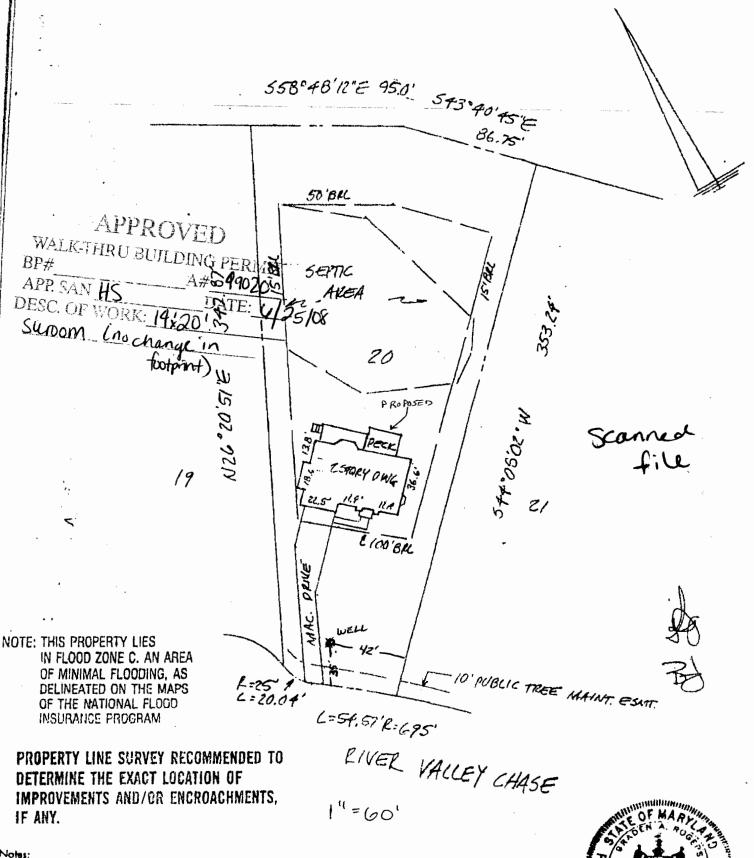

1) This plat is of benefit to a consumer only insofar as it is required by a lender or a title

insurance company or its agent in connection with contemplated transfer, financing or re-financing.

2) This plot is not to be relied upon for the establishment or location of fences, garages, buildings.

or other existing or future improvements.

3) This plat does not provide for the accurate identification of property boundary lines, but such identification may not be required for the transfer of title or securing financing or refinancing

4) No title report furnished.

