



Building Permit Application

Howard County Maryland

Department of Inspections, Licenses and Permits

3430 Court House Drive


Permits: 410-313-2455

www.howardcountymd.gov

ate	Received:	

E	,00	3430 Court I Permits: 410 www.howardo	0-313-2455	Permit No.	P 2019 JUN 18 PM12	
Building Address: 15320 City: Woodbine Sta	St. 21797	Property Owner's Name: Pedrot Suyan Mar Tinez Address: LS on OSINE + HAN STORY City: Wood Land States In D Zip Code: 21797				
Suite/Apt. #		City: Wood State: And Zip Code: 2/797 Phone: 307-227 State: Fax:				
Census Tract:	Subdivision:		Email: Soyafaem @ Hot max/ Com			
Section:	Area:Lot:_		Applicant's Name & Mailing Address, (If other than stated herein)			
Tax Map:Parc	el: Grid:_		Applicant's Name: Perd Energy			
Zoning: Map Coord	Size:	Address: 250 In Col 4 Wall Fast City: New Ox Fork! State: A Zin Code: 113:50 Phone: 7/7-577-3				
Existing Use: Residentia			Email: Janinen	Email: Jannen tel Jta Aero energy dom		
Proposed Use: tesiden ta		Contractor Company: A ero Eners				
Estimated Construction Cost: \$ 2		Contact Person: STEVE	Contact Person: STEVE Danne stell t			
Description of Work: MOVE	existing 1	000 001	Address: Lincoln way East			
Underground propo			City: NOW 9x f OV state: 17350 License No.: 201000 1930 9			
to comply with			Phone: Fax:			
, , ,	vijer jej tov ri	vor garing	Email:			
Occupant/Tenant Name:	. /					
Was tenant space previously occupie	ed? Dives	□No	Engineer/Architect Company:			
Contact Name:			Responsible Design Prof.:			
Address:			Address:			
City:	State: Zip Code	e:	City:State: Zip Code:			
Phone:			Phone: Fax:			
Email:			Email:			
			Cirion.			
Commercial Building Characteristic Height:	Residential Building (Utilities			
No. of stories:	Depth	Width		□ No		
Gross area, sq. ft./floor:	1 st floor:		Gas: Sa Yes Water Supply	□ No		
4	2 nd floor:		Public			
Area of construction (sq. ft.):	Basement: □ Finished Basement		Private			
Use group:	☐ Unfinished Basement		Sewage Disposal			
	☐ Crawl Space		☐ Public			
Construction type: ☐ Reinforced Concrete	☐ Slab on Grade		Private			
☐ Structural Steel	No. of Bedrooms: Multi-family Dwelling		Heating System			
☐ Masonry	No. of efficiency units:		☐ Electric ☐ Oil			
□ Wood Frame	No. of 1 BR units:		☐ Natural Gas 🕱 Propane Gas			
☐ State Certified Modular	No. of 2 BR units: No. of 3 BR units:		Other:			
	Other Structure:		Sprinkler System:			
	Dimensions:		Yes No			
➤ Roadside Tree Project Permit □Yes □No	Footings: Roof:		Grading Permit Number:			
Roadside Tree Project Permit #	State Certified Modu	ılar				
	☐ Manufactured Home		Building Shell Per	mit Number:		
THE UNDERSIGNED HEREBY CERTIFIES AND AGE WITH ALL REGULATIONS OF HOWARD COUNTY THIS APPLICATION: (5) THAT HE/SHE GRANTS CO Applicant's Signature Email Address	WHICH ARE APPLICABLE THERETO); (4) THAT HE/SHE WI ITER ONTO THIS PROPE	IL PERFORM NO WORK ON THE ABOVE	REFERENCED PROP	SEDTY NOT SPECIFICALLY DESCRIPTO IN	
Title/Company		_				
Title/Company	Checks Pavable	to: DIRECTOR OF FU	VANCE OF HOWARD COUNTY	// - \		
		PLEASE WRITE NEAT	TLY & LEGIBLY**	\$22	P 4 110	
AGENCY DATE :	SIGNATURE OF APPROVAL	DPZ SETBACK	NFORMATION	Filing Fee	\$.00.00	
State Highways		Front:		Permit Fee	\$ 100-5	
Building Officials		Rear: Side:		Tech Fee Excise Tax	\$ 10,00	
PSZA (Zoning)		Side St.:	thocks mat2. Thy This	PSFS	\$	
PSZA (Engineering)	All minimum se					
Health 7/1/19	Lot	Historic District? ☐ Yes ☐No		Total Fees	\$ 110.	
Is Sediment Control approval required		SDP/Red-line a	or New Town Zone:	Sub- Total P Balance Duc		
CONTINGENCY CONSTRUCTION STAF	RT			Check	# 1101	

1"=60"

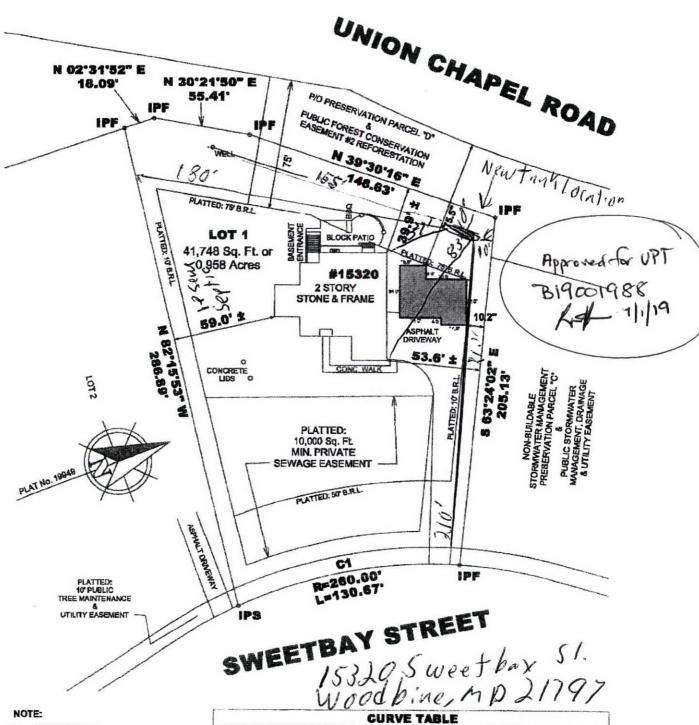

CURVE TABLE

CURVE RADIUS LENGTH DELTA CHORD

C1 260.00 130.67 28'47'44" 8 10'01'06" W 129.30

Steve De 117-5923

(

HOWARD COUNTY HEALTH DEPT.