
INSPECTIONS (410) 313-1810			COUNTY		001175 31
AUTOMATED INFORMATION	V (410) 313-3806	PERMIT AI	PPLICATION		MIT NUMBER
Building Address 318	S (Siver)	10 menchan	Property Owner's		NN Sertory
Wast Priently	4-1mi _	au 149	City Land	KING VA	Mey Chille
Suite/Apt. #: SDP/WP/Petition #:			City west frence State Mo Zip Code 2/79 Phone 4/0 4/2 // OPhone Applicant's Name & Mailing Address, (if other than		
Census Tract Subdivision			Applicant's Name & Mailing Address, (if other than stated herein):		
SectionA	reaLot				
Tax Map Parcel Grid			Phone Fax		
Zoning Map Coordinates Lot Size					
Existing UseSPO			Contractor Company Marks Decks + Hometry		
Proposed Use S/w Jean			Contact Person Mark Banhag		
Estimated Construction Cost \$ 350000			Address 7021 Minh Hollow Ped		
Description of Work 12 x 12 Desc			City High Ind Statems Zip Code 777 License No. 34999		
<u> </u>			Phone	777 Fax	
wolsteps (1) Hot			301 85 40 981 Fax		
Occupant or Tenant / 45			Engineer or Architect Company		
Contact Name			Contact Person'		
Address			Address		
CityStateZip Code		CityStateZip Code			
Phone	Fax		Phone	Fax	
BUILDING DESCRIPTION - COMMERCIAL			BUILDING DESCRIPTION - RESIDENTIAL		
Building Characteristics Height:	Water Supply:	tilities	Building Chara SF Dwelling SF To	ownhouse □	<u>Utilities</u> Water Supply:
	Public		Depth Width		Public
No. of stories:	Private	at-	1st floor: 2st floor:		Private
Gross area, sq. ft. per floor:	Sewage Disposa Public	11:	2 ^{ss} floor: Basement:		Sewage Disposal: Public
	Private				Private
Use group	Electric Yes	□ No □	Finished Basement ◆ Unfi Craw1 space □ Slab		Flectric Ves C No C
Construction type:		□ No □	No. of Bedrooms		Electric Yes □ No □ Gas Yes □ No □
Reinforced Concrete Structural Steel	Hastin - Court		Multi-family dwellings	s:	
Structural Steel Masonry	Heating System Electric	Oil 🗆	No. of efficiency units:	:	Heating System: Electric □ Oil □
Wood Frame	Natural Gas		No. of 1 BR units: No. of 2 BR units:		Natural Gas □
State Certified Modular	Propane Gas		No. of 3 BR units:		Propane Gas
Otate Celtried Modular	Sprinkler system	n: N/A 🗆			Sprinkler system: N/A
	Full		Other Structure: Dimensions:		NFPA #13D
	Partial Other Sup	pression	Footings:		NFPA #13R Other:
	# of Head		Roof Height:		Outer.
			State Certified Mo		
THE UNDERSIGNED HEREBY CERTI CORRECT: (3) THAT HE/SHE WILL C NO WORK ON THE ABOVE REFERE RIGHT TO ENTER ONTO THIS PROPE	COMPLY WITH ALL R	EGULATIONS OF HOWAR	SHE IS AUTHORIZED TO MAI	KE THIS APPLICATION	(4) THAT HE/SHE WILL PERFORM
m.	1-	2	Mar	6 Bout	ial
Applicant's Signature			Pı	rint Name	-J
- ipprisant o organia			4 1	7-00	
Tide (Comment				108	
Title/Company				Date	
		PLEASE WRITE NEA	FINANCE OF HOWAI TLY AND LEGIBLY.* ICE USE ONLY -		
AGENCY DA	TE SIGNATU	RE APPROVAL	DPZ SETBACK INFO	ORMATION	PROPERTY ID # Filing fee \$
State Highways Building Officials	特於學院的任何經過數學的	140 (140 miles)	Rear Side		Permit fee 3 3
Dev. Engineering DPZ			Side St. St.		Add'I per fee \$
lealth 4/22/20X	2 8 K	Bush.	All minimum setbacks	met?	TOTAL FEES \$
ire Protection s Sediment Control approval re	oured prior to see	uance?	VES IN NO II	mured?	ub-total paid 3
YES 🖂 NO 🖂		144	O Entrance Permit red VES □ NO □ Historie District?		Check # 50 8/
1.4			Historic District? VES EL NO EL		Validation #
CONTINGENCY C	ONSTRUCTION	START: 10	Lot Coverage for New	Town Zone	in the second second
ONE STOP SHOP			Lot Coverage for New SDP/Red-line approval	date - 1 - full /	Accepted by Accepted by
Distribution of Copies Wh	ite: Beildies Off	cials Green In	D. DPZ	ED. DPZ	k; Health Gold: SHA
T:forms/buildingpermitappli	cation	Security in a single		1 1 1 1 1 1 1 1 1 1 1 1 1 1 1 1 1 1 1	REV 10/28/04

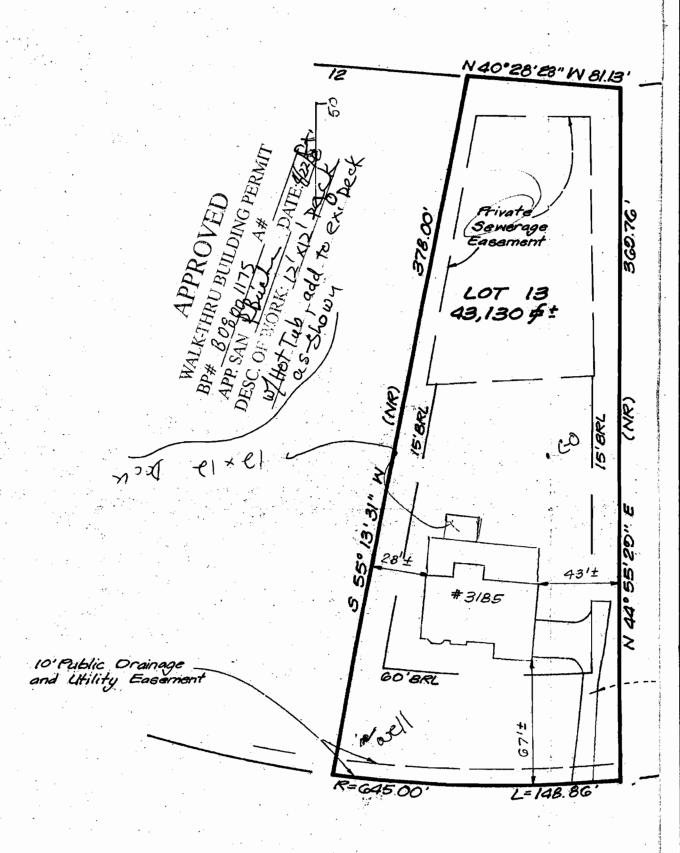

RIVER VALLEY CHASE