

Building Permit Application

Howard County Maryland
Department of Inspections, Licenses and Permits
3430 Court House Drive
Permits: 410-313-2455
www.howardcountymd.gov

Date Received: _____

14026

Permit No.: B19001567

Building Address: 14026 Tall Pine Drive
City: Howard State: MD Zip Code: 21791
Suite/Apt. #: _____ SDP/WP/BA #: _____
Census Tract: _____ Subdivision: _____
Section: _____ Area: _____ Lot: _____
Tax Map: _____ Parcel: _____ Grid: _____
Zoning: _____ Map Coordinates: _____ Lot Size: _____

Existing Use: Single Family Dwelling
Proposed Use: Single Family Dwelling
Estimated Construction Cost: \$110,000
Description of Work: Building 1 BR yellow +
green, (under ground)
Occupant/Tenant Name: _____
Was tenant space previously occupied? ☐ Yes ☒ No
Contact Name: _____
Address: _____
City: _____ State: _____ Zip Code: _____
Phone: _____ Fax: _____
Email: _____

Commercial Building Characteristics	Residential Building Characteristics
Height: _____	☐ SF Dwelling ☐ SF Townhouse
No. of stories: _____	Depth _____ Width _____
Gross area, sq. ft./floor: _____	1 st floor: _____
	2 nd floor: _____
Area of construction (sq. ft.): _____	Basement: _____
Use group: _____	☐ Finished Basement
	☐ Unfinished Basement
	☐ Crawl Space
	☐ Slab on Grade
	No. of Bedrooms: _____
☐ Reinforced Concrete	Multi-family Dwelling
☐ Structural Steel	No. of efficiency units: _____
☐ Masonry	No. of 1 BR units: _____
☐ Wood Frame	No. of 2 BR units: _____
☐ State Certified Modular	No. of 3 BR units: _____
	Other Structure: _____
	Dimensions: _____
	Footings: _____
➤ Roadside Tree Project Permit	Roof: _____
☐ Yes ☒ No	☐ State Certified Modular
Roadside Tree Project Permit # _____	☐ Manufactured Home

THE UNDERSIGNED HEREBY CERTIFIES AND AGREES AS FOLLOWS: (1) THAT HE/SHE IS AUTHORIZED TO MAKE THIS APPLICATION; (2) THAT THE INFORMATION IS CORRECT; (3) THAT HE/SHE WILL COMPLY WITH ALL REGULATIONS OF HOWARD COUNTY WHICH ARE APPLICABLE THERETO; (4) THAT HE/SHE WILL PERFORM NO WORK ON THE ABOVE REFERENCED PROPERTY NOT SPECIFICALLY DESCRIBED IN THIS APPLICATION; (5) THAT HE/SHE GRANTS COUNTY OFFICIALS THE RIGHT TO ENTER ONTO THIS PROPERTY FOR INSPECTING THE WORK PERMITTED AND POSTING NOTICES.

Applicant's Signature

Print Name

Email Address

Date

Title/Company

Checks Payable to: DIRECTOR OF FINANCE OF HOWARD COUNTY

PLEASE WRITE NEATLY & LEGIBLY

-FOR OFFICE USE ONLY-

AGENCY	DATE	SIGNATURE OF APPROVAL
State Highways		
Building Officials		
PSZA (Zoning)		
PSZA (Engineering)		
Health	6/4/19	SA

Is Sediment Control approval required for issuance? ☐ Yes ☒ No
☐ CONTINGENCY CONSTRUCTION START

DPZ SETBACK INFORMATION
Front: _____
Rear: _____
Side: _____
Side St.: _____
All minimum setbacks met? ☐ Yes ☒ No
Is Entrance Permit Required? ☐ Yes ☒ No
Historic District? ☐ Yes ☒ No
Lot Coverage for New Town Zone: _____
SDP/Red-line approval date: _____

Filing Fee	\$ 110.00
Permit Fee	\$
Tech Fee	\$
Excise Tax	\$
PSFS	\$
Guaranty Fund	\$
Add'l per Fee	\$
Total Fees	\$
Sub- Total Paid	\$
Balance Due	\$
Check	#

Distribution of Copies: White: Building Officials


Green: PSZA, Zoning

Yellow: PSZA, Engineering

Pink: Health

Gold: SHA

История культуры в России • История культуры в России • История культуры в России
История культуры в России • История культуры в России • История культуры в России

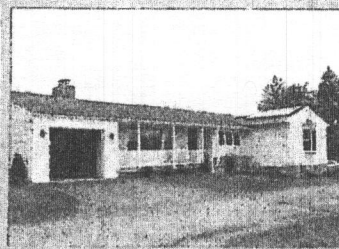


PROPERTY ADDRESS: 14026 TALL SHIPS DRIVE, WEST FREINDSHIP, MARYLAND 21794

SURVEY NUMBER: 1804.0025

FIELD WORK DATE: 4/12/2018

REVISION HISTORY: (REV.1 4/12/2018) (REV.1 4/10/2018)

18040025
BOUNDARY SURVEY
14026 TALL SHIPS DRIVE
HOWARD COUNTY, MARYLAND
04-10-2018 SCALE 1"=200'

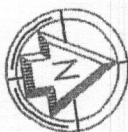


NOTES:


1. THE PROPERTY SHOWN HEREON IS IDENTIFIED AS ACCOUNT NUMBER J04048 AMONG THE ASSESSMENT RECORDS OF HOWARD COUNTY, MARYLAND.

2. THE PROPERTY IS NOW IN THE NAME OF BRIAN E. DAVIS & CHRISTINA DAVIS BY DEED, RECORDED IN LIBR 16827, FOLIO 438 AMONG THE LAND RECORDS OF HOWARD COUNTY, MARYLAND.

PROPERTY OF
BRIAN E. DAVIS &
CHRISTINA DAVIS
LIBER 16827, FOLIO 43B
236849 S.F.

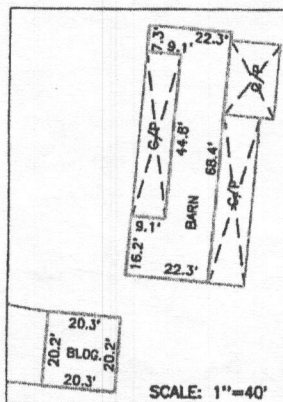

EXPIRES 1-14-2019

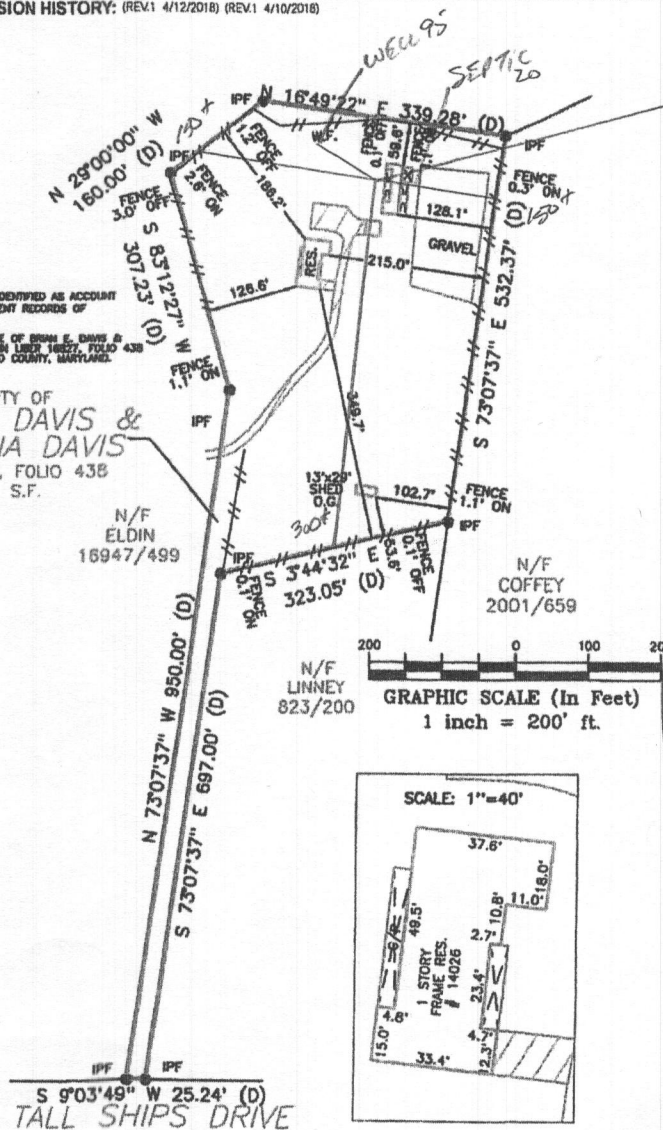


1990 Callon u/b LP Travel

WELL	95'	to TANK
SEPTIC	20'	to TANK
HOUSE	65'	to TANK


Field verified
N₂O₅ setbacks
on 6/4/19

Approved for UPT
B19001567
h/tt 6/4/19

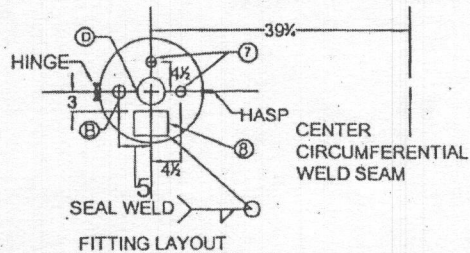


ADDITIONAL NOTES:

- BOLT HOLES TO STRADDLE NATURAL CENTER LINES.
- VESSEL TO BE THOROUGHLY CLEANED.
- ALL OPENINGS CLOSED FOR SHIPMENT.
- LIFTING LUGS FOR TARE WEIGHT ONLY.

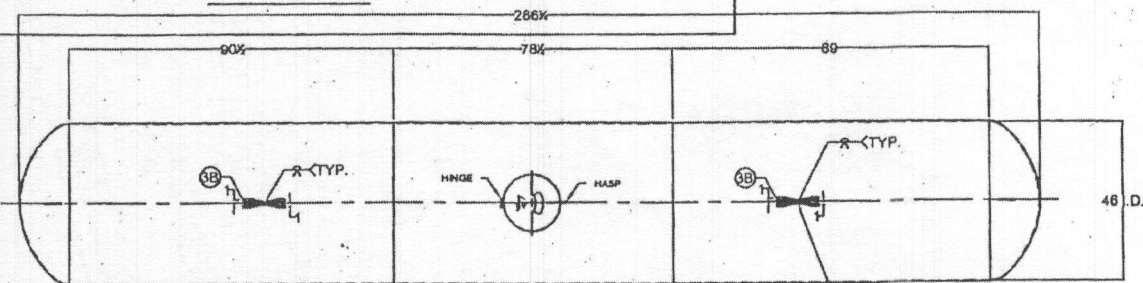

TOP VIEW (LP - 1990UG)

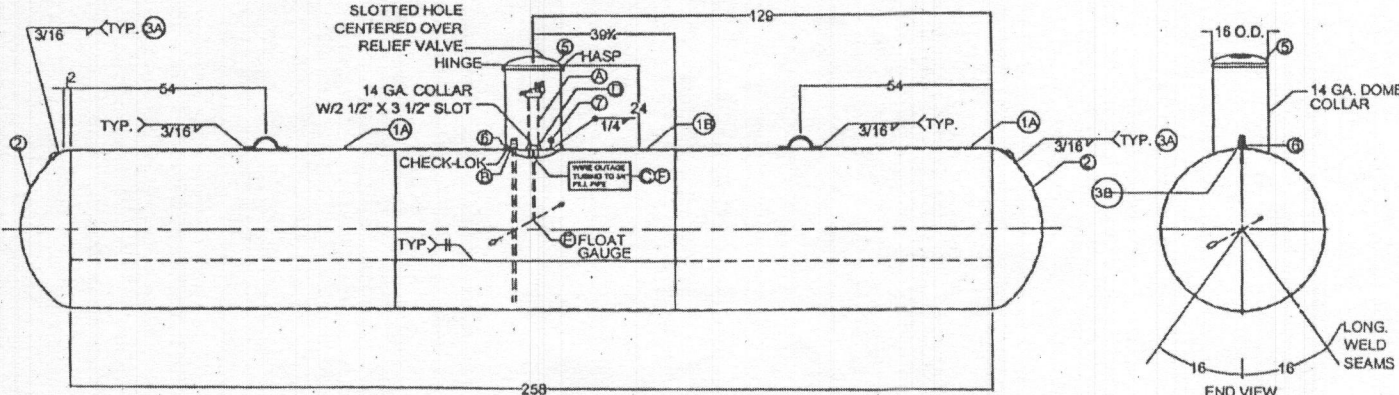

SIDE ELEVATION

MARK	QTY.	SIZE	TYPE	FITTINGS	SERVICE	MARK	QTY.	DESCRIPTION	DWG. NO.
A	1	2 1/2	SCHED. 80 PIPE	Q8475RV	PV2095A	MULTIVALVE	1A	2	SHELL - 0.271\"/>

REV.	BY.	DESCRIPTION	DATE
1	CDH	REVERSED GROUNDING LUGS	5/5/00
2	CDH	REMOVED LEGS	5/30/00
3	CDH	CORRECTED DATA PLATE DETAIL & OUTAGE TUBE LENGTH	7/24/00
4	CDH	CORRECTED % OF FILL ON NAMEPLATE	9/15/00
5	W.C.	ADDED ANODE ATTACHMENT	4/19/01
6	CDH	NEW NAMEPLATE	10/24/01
7	CDH	CORRECTED DIP TUBE LENGTH & S/N PREFIX	11/21/01
8	CDH	REVISED FILL TUBE LENGTHS AND RELOCATED "B"	12/20/01
9	CDH	REVISED CHECK-LOK MODELS	4/11/02
10	CDH	REMOVED DOME CLIPS, ADDED SNAP LOCKS	10/21/02

NAT'L. BD. SERIAL NO. _____

CERTIFIED BY: AMERICAN WELDING & TANK
 HARSCO CORPORATION GAS & FLUID CONTROL GROUP
 JESUP, GEORGIA-BLOOMFIELD, IOWA, SALT LAKE CITY, UTAH-FREMONT, OHIO

MAX. ALLOW. WORKING PRESS. **250** PSI AT **400** °F
 MDMT **-20** °F AT **15** PSI PLANT NO. **6**

SERIAL NO. **YY** YEAR BUILT **20**

LENGTH **288.76** IN. OUTSIDE DIA. **46.5** IN.
 HEAD THK. **.269** IN. SHELL THK. **.271** IN.
 UNDER GROUND TYPE **AWT-UG** SURFACE AREA **294** SQ. FT.

LISTED CONTAINER ASSEMBLY FOR LP GAS **695A** HEAD D.R. **2:1**
 WATER CAPACITY **1990** GALS.

THIS CONTAINER SHALL NOT CONTAIN A PRODUCT HAVING A VAPOR PRESSURE IN EXCESS OF 215 PSI AT 100°F.
 DIP TUBE LENGTH-89% FULL @ 50 DEG. F. D.T. = 9.1 IN.

DATA PLATE DETAIL

GENERAL NOTES:

- LIFTING LUGS DESIGNED FOR TOTAL LIFTING WEIGHT OF 30000.
- TOTAL EMPTY WEIGHT IS 30000.
- ALL DIMENSIONS ARE IN INCHES UNLESS OTHERWISE SPECIFIED.
- COMPLETE TANK DRIED TO REMOVE ALL MOISTURE.
- EXTERIOR OF TANK TO BE GRIT BLASTED.
- PAINT PER SHOP ORDER.
- VACUUM PURGE TANK.
- DIMENSIONS ARE SUBJECT TO CHANGE WITH OUT NOTICE. (NON-PRESSURE RETAINING COMPONENTS ONLY)
- THREADS OF ALL FITTINGS TO BE COATED WITH COMPOUND SUITABLE FOR USE WITH PROPANE GAS.
- FLOAT GAUGE TO BE INSTALLED WITH FLOAT ARM 45° OFF LONGITUDINAL CENTERLINE OF TANK.

GENERAL SPECIFICATIONS

WATER CAPACITY (GALLONS)	1990
ALLOWABLE WORKING PRESSURE (PSIG)	250
JOINT EFFICIENCY:	ASME UW-51 LONG SEAM 100 %
	ASME UW-52 HEAD TO SHELL 100%
HYDROSTATIC TEST PRESSURE (PSIG)	325
SURFACE AREA (SQ. FT.)	294
RELIEF VALVE SETTING (PSIG)	250
RELIEF DISCHARGE RATE - (CFM REQD.)	1701
CODE:	ASME SECTION VIII DIV. I
STANDARDS:	A.N.S.I. K - 61.1

MATERIAL SPECS:

COUPLINGS	SA-105
TANK FLANGES	SA-105
ADAPTOR	SA-105
PIPE	SA53B OR SA106B

1990 W.G. UNDERGROUND
PROPANE TANK TYPE BS - AP

AMERICAN WELDING & TANK
 HARSCO CORPORATION GAS & FLUID CONTROL GROUP


DATE	01/03/00	DRAWN BY	RAC	APPROVED BY	CDH	REVISION	10	DRAWING NO.	LP - 1990UG
------	----------	----------	-----	-------------	-----	----------	----	-------------	-------------

Pftt to Rovermill
Straight across to
Tall Ships.

SITE INSPECTION SHEET

OWNER: Sammy Eldin PHONE #: _____
ADDRESS: 14026 Tall Ships Dr CONTRACTOR: Eastday
WELL TAG #: _____
SUBDIVISION: _____ LOT: _____ COUNTY #: _____
PROPOSAL: Drill a replacement well b/c of water quality issues. Seal existing
pit wells.

LOCATION DIAGRAM

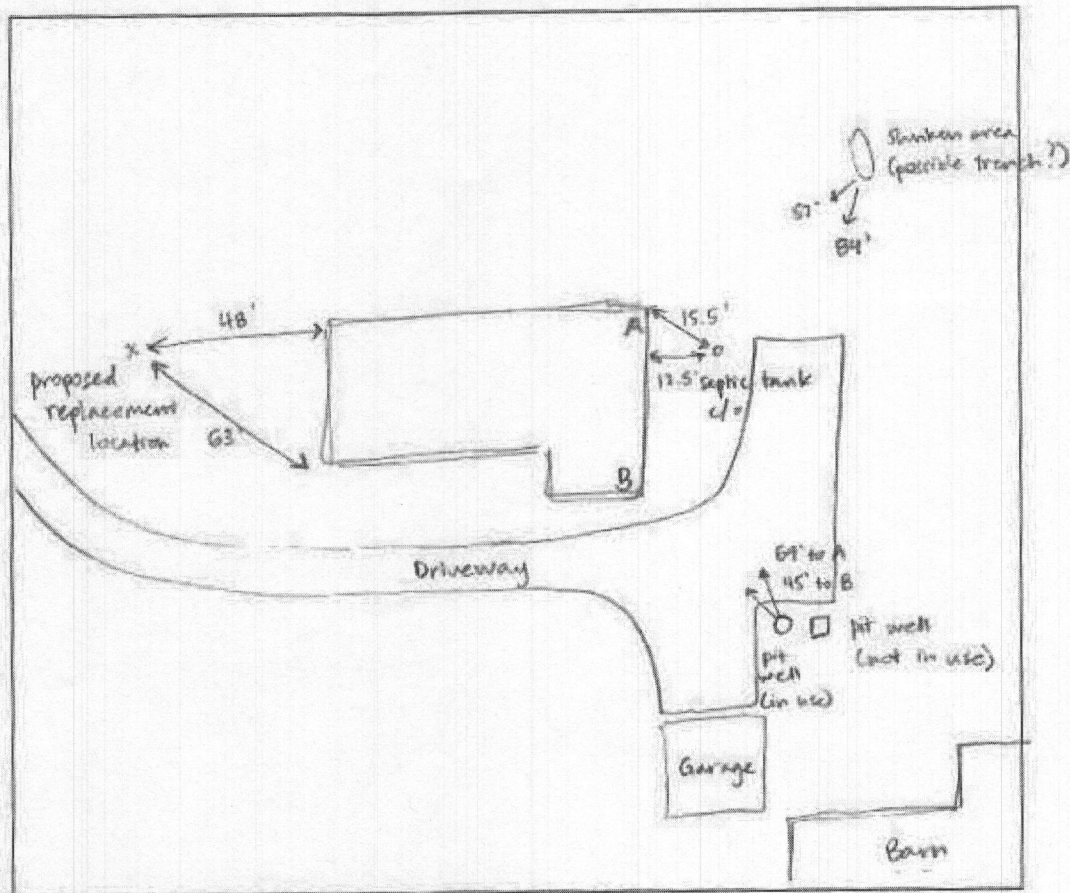

COMMENTS: Met homeowner - George Eastday on site. Property newly
acquired by homeowner - 2 drilled wells in pit - 5' apart. Both pits are
flooded - well used for drinking water has had bacteria - turbidity
issues. Drill new well > 100' from septic tank and seal pit wells.

DATE: 5/21/18 INSPECTOR: Sarah Collins