
DEPARTMENT OF INSPECTIONS, LICENSES AND PERMITS 3490 COURT HOUSE DRIVE ELLICOTT COTY MO 2004 PERMITS (410) 313-2405 INSPECTIONS (410) 313-3400 AUTOWATED INFORMATION HOUSE 313-3400

HOWARD COUNTY PERMIT APPLICATION

PERMIT NUMBER

	FLIMITA	TEIOMITOIT	
Building Address 2809 Rown		Property Owner's Name STE/E t	Donne Mazer
GLENWOOD MID 21738		Address 2809 ROLLING Form Way	
Suite/Apt. #: SDP/WP/Pe			(
Census Tract Subdivision	GMAMDAL OUR FRI	l .	
Section Area Lot		Home Phone Work Phone 110 485 1745 Applicant's Name & Mailing Address, (if other than stated hereon):	
Tax Map 14 Parcel 123 Grid 11		replicant s Harrie & Maining Address, (n outer than stated hereony.
Zoning Map Coordinates Lot size		Phone Fax	
Existing Use SINGLE FAMILY KESINEUTAL		Contractor Company SASLOW Hours INC.	
Proposed Use SAME Estimated Construction Cost \$ 190 000		Contact Person REN SAMO TAVIS	
Description of Work SEMI ATTACRED ADDITION			
SUNROOM		Address 7520 MAIN ST., SUITE 204	
570 /x2		City STRESVILLE State MD Zip Code 21784 License No. 37567	
		Phone 410 781 4844Fax 410.549.6498	
Occupant or Tenant STEVET DOULA MAZEN		Engineer or Architect Company	
Contact Name SAME		Contact Person	
Address 2809 Round For Way		Address	
City GEENWOOD State MD Zip Code 21738			
Phone it is a Fav /		City State Zip Code	
Phone 46-489-7745		Phone Fax	
BUILDING DESCRIPTION - COMMERCIAL		BUILDING DESCRIPTION - RESIDENTIAL	
Building Characteristics	Utilities	Suilding Characteristics	<u>Utilities</u>
Height:	Water Supply: Public	SF Dwelling 12 SF Townhouse Depth Width	Water Supply: Public
No. of stories:	Private Sewage Disposal:	1st floor: 44' 69'	Private Sewage Disposal:
Gross area, sq. ft. per floor:	Public Private	Basement: Finished Basement Unfinished Basemer	Public Private
Use service	Electric Yes No	Crawl space ☐ Slab on Grade ☐ No. of Bedrooms	Electric Year No Gas Yes No G
Use group:	Gas Yes□ No□	Height: Multi-family dwellings: No. of efficiency units:	Heatin System:
Construction type:	Heating System: Electric □ Oil □	No. of 1 BR units: No. of 2 BR units:	Electric Oil Natural Gas
Reinforced Concrete Structural Steel	Natural Gas ☐ Propane Gas ☐	No. of 3 BR units:	Propane Gas
Masonry Wood Frame	Sprinkler system: N/A □	Other Structure: Dimensions:	Sprinkler system: N/A NFPA #13D
	Full Partial	Footings:Roof Height:	NFPA #13R Other:
State Certified Modular	Other Suppression # of Heads	State Certified Modular Manufactured Home	
THE UNDERSIGNED HEREBY CERTIFIES AND AGREES AS FOLLOWS:	(1) THAT HE/SHE IS AUTHORIZED TO MAKE THIS APE	PLICATION: (2) THAT THE INFORMATION IS CORRECT: (3) THAT H	E/SHE WILL COMPLY WITH ALL REGULATIONS OF
HOWARD COUNTY WHICH ARE APPLICABLE THERETO; (4) THAT HE	SHE WILL PERFORM NO WORK ON THE ABOVE REFE	RENCED PROPERTY NOT SPECIFICALLY DESCRIBED IN THIS AP	PLICATION; (5) THAT HE/SHE GRANTS COUNTY OFFICIAL
HOWARD COUNTY WHICH ARE APPULCABLE THERETO; (4) THAT HE THERETO; THIS PROPERTY FOR THE PURPOSE OF	SHE WILL PERFORM NO WORK ON THE ABOVE REFE	RENCED PROPERTY NOT SPECIFICALLY DESCRIBED WITHIS AP NOTICES POLITICAL AND IN TAUR	PLICATION; (5) THAT HE/SHE GRANTS COUNTY OFFICIAL
HOWARD COUNTY WHICH ARE APPURABLE THERETO, (4) THAT HE PREFIGAT TO ENTER-ONTO THIS PROPERTY FOR THE PURPOSE OF	/SHE WILL PERFORM NO WORK ON THE ABOVE REFE FINSPECTING THE WORK PERMITTED AND POSTING I	NOTICES	PLICATION (5) THAT HEISHE GRAATS COUNTY OFFICIAL
HOWARD COUNTY WHICH ARE APPLICABLE THERETO, (4) THAT HE PER HIGHT TO EMER ONTO THIS PROPERTY FOR THE PURPOSE OF	ISSE WILL PERFORM NO WORK ON THE ABOVE REFE **********************************	Print Name 8-2-06 Date	PLICATION; (5) THAT HEISHE GRANTS COUNTY OFFICIAL
HOWARD COUNTY WHICH ARE LABOURD AS E THERETO, (4) THAT HE PREPIGHT TO BHER WHITO THIS PROPERTY FOR THE PURPOSE OF Applicant's Signature Dr. OE OPS / S.ASLOW Ho.	ISNE WILL PERFORM NO WORK ON THE ABOVE REFE INSPECTING THE WORK PERMITTED AND POSTING IN Checks payable to: DIRECTOR O. PLEASE WRITE NE	Print Name 8-2-06 Date FrinAnce of HOWARD COUNTY EATLY AND LEGIBLY."	PLICATION (5) THAT HEISHE GRANTS COUNTY OFFICIAL
HOWARD COUNTY WHICH ARE ARREPORTS THERETO. (4) THAT HE PRINCIPOSE ON Applicant's Signature DI & OF OLS SASLOW HOTTIGE/Company AGENCY DATE	ISNE WILL PERFORM NO WORK ON THE ABOVE REFE INSPECTING THE WORK PERMITTED AND POSTING IN Checks payable to: DIRECTOR O. PLEASE WRITE NE	Print Name 8-2-06 Date FINANCE OF HOWARD COUNTY EATLY AND LEGIBLY. " CE USE ONLY- DPZ SETBACKINFORMATIC	
HOWARD COUNTY WHICH ARE ARREPORTS THERETO. (4) THAT HE PRINCIPOSE ON Applicant's Signature Applicant's Signature DIA OF OLS SASLOW HOTTIGE/Company AGENCY Land Development. DPZ	LISHE WILL PERFORM NO WORK ON THE ABOVE REFE INSPECTING THE WORK PERMITTED AND POSTING IN Checks payable to: DIRECTOR O. PLEASE WRITE NE FOR OFFI	Print Name 8-2-06 Date FINANCE OF HOWARD COUNTY EATLY AND LEGIBLY.** CE USE ONLY- DPZ SETBACK INFORMATIC	N PROPERTY ID#: Filing fee \$
HOWARD COUNTY WHICH ARE ARREPORTS THERETO. (4) THAT HE PRINCIPOSE ON Applicant's Signature DI & OF OLS SASLOW HOTTIGE/Company AGENCY DATE	LISHE WILL PERFORM NO WORK ON THE ABOVE REFE INSPECTING THE WORK PERMITTED AND POSTING IN Checks payable to: DIRECTOR O. PLEASE WRITE NE FOR OFFI	Print Name 8-2-06 Date FINANCE OF HOWARD COUNTY EATLY AND LEGIBLY. " CE USE ONLY- DPZ SETBACKINFORMATIC	N PROPERTY ID#:
Applicant's Signature Dia of OPS SASLOW No. Title/Company AGENCY DATE Land Development, DPZ State Highways Buiking Official Dev. Engineering, DPZ	LISHE WILL PERFORM NO WORK ON THE ABOVE REFE INSPECTING THE WORK PERMITTED AND POSTING IN Checks payable to: DIRECTOR O. PLEASE WRITE NE FOR OFFI	Print Name 8-2-06 Date FFINANCE OF HOWARD COUNTY EATLY AND LEGIBLY. ** CE USE ONLY- DPZ SETBACK INFORMATIC Front: Reer: Side: Side St.:	PROPERTY IDII: Filing fee \$
Applicant's Signature Applicant's Signature Dia of Ols SASLOW Was AGENCY DATE Land Development, DPZ State Highways Building Official	LISHE WILL PERFORM NO WORK ON THE ABOVE REFE INSPECTING THE WORK PERMITTED AND POSTING IN Checks payable to: DIRECTOR O. PLEASE WRITE NE FOR OFFI	Print Name 8-2-06 Date FINANCE OF HOWARD COUNTY EATLY AND LEGIBLY.** CE USE ONLY- DPZ SETBACK INFORMATIC Front: Reer: Skie:	PROPERTY IDS: Filling fee \$ Permit fee \$ Excise tex \$
Applicant's Signature Applicant's Signature Di a OE () S S AS LOW W. ASENCY Land Development, DPZ State Highways Building Official Dev. Engineering, DPZ Health Fire Protection ta Sediment Control approval required prior to	Checks payable to: DIRECTOR OF PLEASE WRITE NEW OFFINE	Print Name 8-2-06 Date FINANCE OF HOWARD COUNTY EATLY AND LEGIBLY. *** CE USE ONLY- DPZ SETBACK INFORMATIC Front: Skide: Skide St.: All minimum setbacks met? YES NO Is Entrance Permit required?	PROPERTY ID#: Filing fee \$
Applicant's Signature Applicant's Signature Diacetyles SASLOW ASENCY Land Development, DPZ State Highways Building Official Dev. Engineering, DPZ Health Fire Protection	Checks payable to: DIRECTOR OF PLEASE WRITE NEW OFFINE	Print Name 8-2-06 Date FINANCE OF HOWARD COUNTY EATLY AND LEGIBLY." CE USE ONLY- DPZ SETBACK INFORMATIC Front: Reer: Skide: Skide St.: All minimum setbacks met? YES NO Is Entrance Permit required? YES NO	PROPERTY ID#: Filing fee \$ Permit fee \$ Excise tax \$ Add'l per, fee \$ TOTAL FEES \$ Sub-total peid \$ Balance due \$ Check #
Applicant's Signature Applicant's Signature Di a OE () S S AS LOW W. ASENCY Land Development, DPZ State Highways Building Official Dev. Engineering, DPZ Health Fire Protection ta Sediment Control approval required prior to	Checks payable to: DIRECTOR OF PRANTICE NOTICE NOTI	Print Name 8-2-06 Date FINANCE OF HOWARD COUNTY EATLY AND LEGIBLY. *** CE USE ONLY- DPZ SETBACK INFORMATIC Front: Skide: Skide St.: All minimum setbacks met? YES NO Is Entrance Permit required?	PROPERTY ID#: Filing fee \$
HOWARD COUNTY WHICH ARE ADRICABLE THERETO. (4) THAT HE PREPIGHT TO ENTER-OWNTO THIS PROPERTY FOR THE PURPOSE OF APPLICANT'S SIgnature DI A OF OPS SASLOW AS TITLE/Company AGENCY Land Development. DPZ State Highways Building Official Dev. Engineering. DPZ Health S/Z/C/I Fire Protection ta Sediment Control approval required prior to YES NO	Checks payable to: DIRECTOR OF PRANTICE NOTICE NOTI	Print Name 8-2-06 Date FINANCE OF HOWARD COUNTY EATLY AND LEGIBLY. DPZ SETBACK INFORMATIC Front: Reer: Side: Skide St.: All minimum setbacks met? YES NO Is Entrance Permit required? YES IN O Historic District?	PROPERTY ID#: Filing fee \$ Permit fee \$ Excise tax \$ Add'l per, fee \$ TOTAL FEES \$ Sub-total peid \$ Balance due \$ Check #

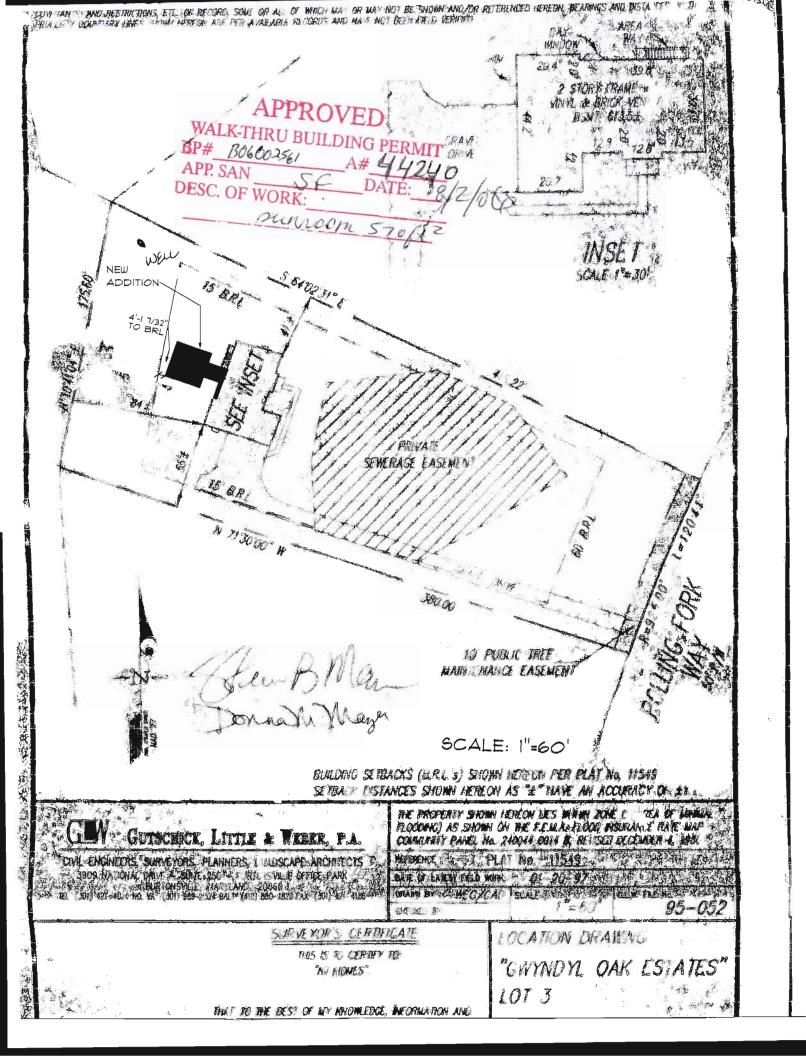

PERMIT

SEWAGE DISPOSAL SYSTEM

P 57359-13

A 44240

CO. 12:00

96 DEPARTMENT OF HEALTH AND MENTAL HYGIENE

04-355970

4th DISTRICT_

HOWARD COUNTY HEALTH DEPARTMENT

BUREAU OF ENVIRONMENTAL HEALTH

XXXXX993X

313-2640

INDEXE

DATE SYSTEM APPROVED

South Carroll Backhoe, Inc. IS PER	MITTED TO INSTALL XALTER
ADDRESS 4410 Salem Bottom Road, Westminster, MD 21157	PHONE 875-4197
SUBDIVISION Gwyndyl Oak Estates LOT 3 ROAD 28	809 Rolling Fork Way
PROPERTY OWNER N V Homes	
ADDRESS	
	LEANOUT REQUIRED***
	NG PERMIT SIGNED
AN AN	ND RETURNED
	306002561- 22 + 22 Surroom
LINEAR FEET OF TRENCH REQUIRED 240	· .
original grade. 3 feet of stone below distribution LOCATION - Place distribution box 240 feet up the right lot that same lot line when facing the lot from Rolling contour toward the left lot line. NOTES - No trench to exceed 100 feet in length. Provide (cap to grade or above on septic tank. OK 9/13/9/0 feet)	line (415.22') and 45 feet off ng Fork Way. Run trenches on 6" - 8" diameter cleanout and
PLANS APROVED BY Amy McMillen	DATE 09/09/96
COVER NO WORK UNTIL INSPECTED AND APPROVED	
NEITHER THE HOWARD COUNTY COUNCIL NOR THE HEALTH DEPARTMENT IS RESPONSIBLE FOR THE SUC	CCESSFUL OPERATION OF ANY SYSTEM
NOTE: CLEANOUT REQUIRED EVERY 70 FEET OF SEWER LINE AND/OR AT 90° SWEEPS IN LINES FI ACCEPTABLE.	ROM HOUSE TO DRAIN FIELDS, 90° ELBOWS NOT
NOTE: ALL PARTS OF SEPTIC SYSTEMS (I.E. TANK, DISTRIBUTION BOX TRENCHES) TO BE 100 FEET AUTHORIZED)	FROM WELL (UNLESS OTHERWISE SPECIFICALLY
NOTE: IF DEEP TRENCH(ES) ARE USED CALL FOR INSPECTION BEFORE AND AFTER PLACING GRAVEL IN T	TRENCH(ES)
NOTE: NO DRY WELL SHALL EXCEED 15 FOOT IN DIAMETER NO ABSORPTION TRENCH TO EXCEED 100 FE	ET IN LENGTH BLDG. PERMIT SIGNED ,
NOTE: ALL PIPE FROM HOUSE TO SEPTIC TANK MUST BE CAST IRON OR SCHEDULE 35/40 PVC OR ABS	AND RETURNED VI4/97
PERMIT VOID AFTER TWO YEARS	Serial # 1810 103403-
NOTE: INSTALL STAND PIPE ON SEPTIC TANK AND DRY WELL STAND PIPES MUST BE 6 INCHES IN DIAME PVA OR ABS ACCEPTED. IF TOP OF SEPTIC TANK IS DEEPER THAN 3 FEET. MANHOLE TO GRADE RE	ETER CAST IRON. CONCRETE OR TERRA COTTA OR EQUIRED. Jumps lank
NOTE: DISTRIBUTION ROVES MUST HAVE BASELES	,

*INSTALLER IS RESPONSIBLE FOR OBTAINING FINAL APPROVAL ON THIS PERMIT *CALL 461-9933 FOR INSPECTION OF SEPTIC SYSTEM.

HD-260(6-90)