

APPLICATION

A 21306

SEWAGE DISPOSAL TESTING

P _____

STATE OF MARYLAND - DEPARTMENT OF HEALTH AND MENTAL HYGIENE

HOWARD COUNTY HEALTH DEPARTMENT
ENVIRONMENTAL HEALTH SERVICES
P. O. BOX 476, ELLICOTT CITY, MARYLAND 21043
TELEPHONE: 465-5000, EXT. 356

DISTRICT 3

DATE 4/2/75

TO: THE COUNTY HEALTH OFFICER
ELLICOTT CITY, MARYLAND

I, HEREBY, APPLY FOR THE NECESSARY TEST IN ORDER TO CONSTRUCT (OR RECONSTRUCT) A SEWAGE DISPOSAL SYSTEM.

PROPERTY OWNER W. Walter & Barbara Farnandis

ADDRESS 6202 Old Columbia Road, Ellicott City, Md. PHONE 790-6161
21043

PROPERTY LOCATION:

SUBDIVISION _____ LOT NO. _____

ROAD AND DESCRIPTION Pfefferkorn Road - off Rt. 32 - 5th place on left side

SIZE OF LOT 34.265 acres TYPE BLDG. Farm trailer
2
NUMBER OF BEDROOMS

IF NOT SINGLE RESIDENCE DESCRIBE _____

THE SYSTEM INSTALLED UNDER THIS APPLICATION IS ACCEPTABLE ONLY UNTIL PUBLIC FACILITIES BECOME AVAILABLE.

SIGNATURE OF APPLICANT Barbara A. Farnandis

APPROVED BY _____ FOR _____ DATE _____
(KIND OF SYSTEM)

REJECTED BY _____ FOR _____ DATE _____
(KIND OF SYSTEM)

HOLD PENDING FURTHER TESTS _____ DATE _____

REASONS FOR REJECTION OR HOLDING _____

THIS IS NOT A PERMIT

① - 0
Clay loam

- 6'

Brown clay loam
weathered
material

- 10'
sandy loam

- 12'


② - 0
Topsoil

- 1
clay loam

- 2 1/2'

Sandy
loam

- 12'

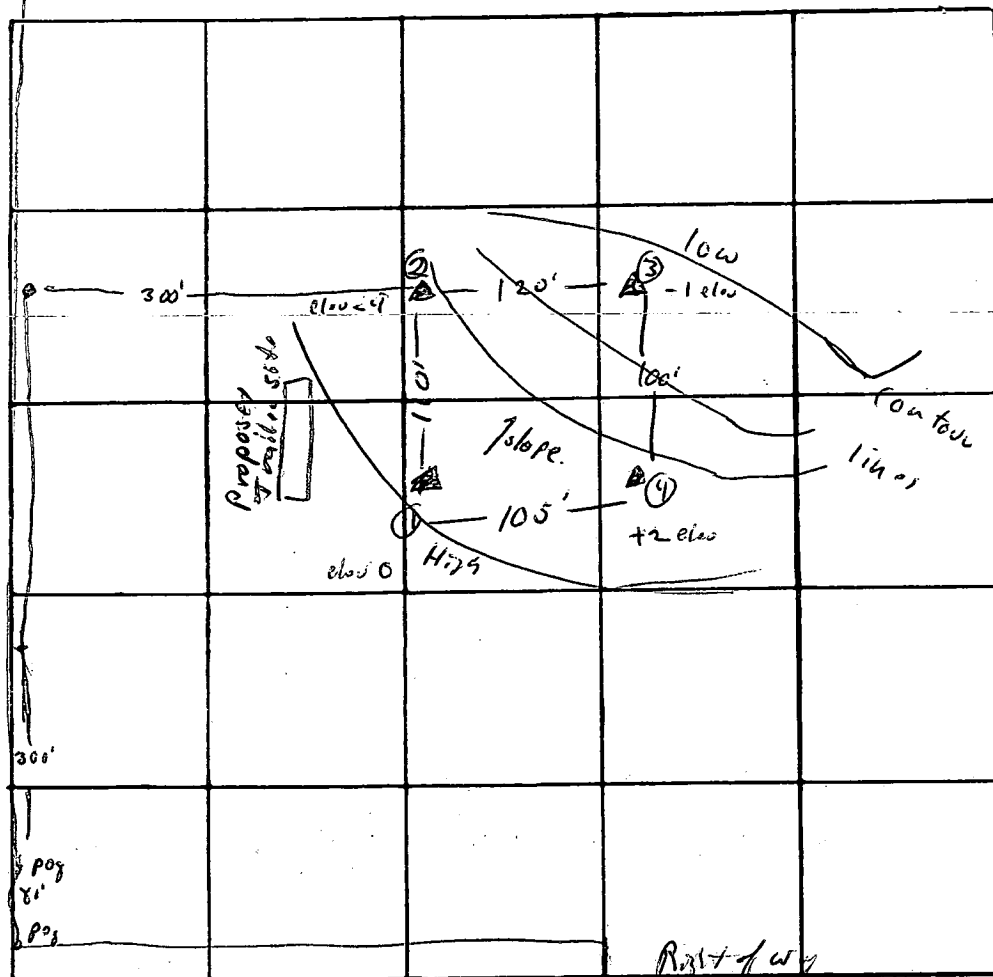

INDICATE NORTH. - NAME ADJOINING ROADWAY AS BASE LINE.

PEPPERKORN Road

DATE	TEST NO.	DEPTH	PRE-WET		TEST - 1" DROP		TIME
			START	STOP	START	STOP	
4-9-75	1 d	11'	10 01	10 20	1" in 20 min pulled dry		
"	1 s	4'	10 02	10 08	10 08	10 14	6
"	2 s	4'	10 10	10 12	10 12	10 16	4
"	2 d	11'	10 22	10 30	10 30	10 45	15
"	3 s	5'	10 25	10 27	10 27	10 32	5
"	3 d	11'	10 24	10 38	10 38	10 52	24
"	4	12'	Visual		Hole		
"	1 d	10'	10 36	10 41	10 41	10 54	13

REMARKS

TYPE OF SOIL

TESTED BY

ALSO PRESENT:

12 min
avg