

APPLICATION

PERCOLATION TESTING

A 40598

P _____

HOWARD COUNTY HEALTH DEPARTMENT
BUREAU OF ENVIRONMENTAL HEALTH
P.O. BOX 476 ELLICOTT CITY, MARYLAND 21043
TELEPHONE: 461-9933

DISTRICT 6th

DATE 11-3-87

Roscommon

TO: THE COUNTY HEALTH OFFICER
ELLICOTT CITY, MARYLAND

I HEREBY APPLY FOR THE NECESSARY TEST IN ORDER TO CONSTRUCT (OR RECONSTRUCT) A SEWAGE DISPOSAL SYSTEM.

PROPERTY OWNER Barbara Jarnach Robert L. Gladden Jr.

ADDRESS Christopher Rd, Cecilton, MD 21913 PHONE 792-4230
275-2233

PROSPECTIVE BUYER Clayton Kemp

ADDRESS 8307 Main Street, Ellicott City PHONE 465-4920

PROPERTY LOCATION:

SUBDIVISION _____ LOT NO. 22

ROAD AND DESCRIPTION 3100 Popplehorn Rd. (3211 Roscommon Drive)

TAX MAP 15 PARCEL # 1704177

SIZE OF LOT 3.0+ TYPE BLDG Single family
(SINGLE FAMILY DWELLING OR COMMERCIAL)

THE SYSTEM INSTALLED UNDER THIS APPLICATION IS ACCEPTABLE ONLY UNTIL PUBLIC FACILITIES BECOME AVAILABLE. I FULLY UNDERSTAND THE

FEE CONNECTED WITH THE FILING OF THIS PERC TEST APPLICATION IS NON-REFUNDABLE UNDER ANY CIRCUMSTANCES. I ALSO AGREE TO COMPLY

WITH ALL M.O.S.H.A. REQUIREMENTS IN TESTING THIS LOT. Christine A. Richards
(SIGNATURE OF APPLICANT)

APPROVED BY _____ FOR _____ DATE _____

REJECTED BY _____ FOR _____ DATE _____

HOLD PENDING FURTHER TESTS _____ DATE _____

REASONS FOR REJECTION OR HOLDING _____

BLDG. PERMIT SIGNED





AND RETURNED 3/18/94

Serial # 52819

SFD-4Bom


THIS IS NOT A PERMIT

A40598
LOT 22

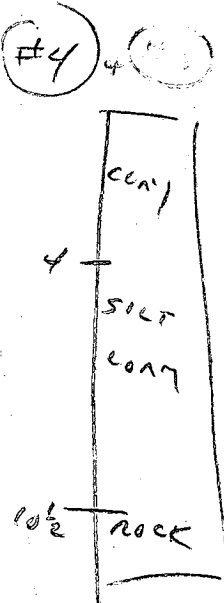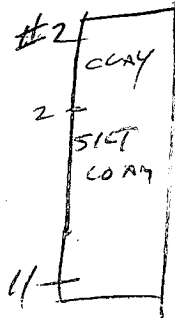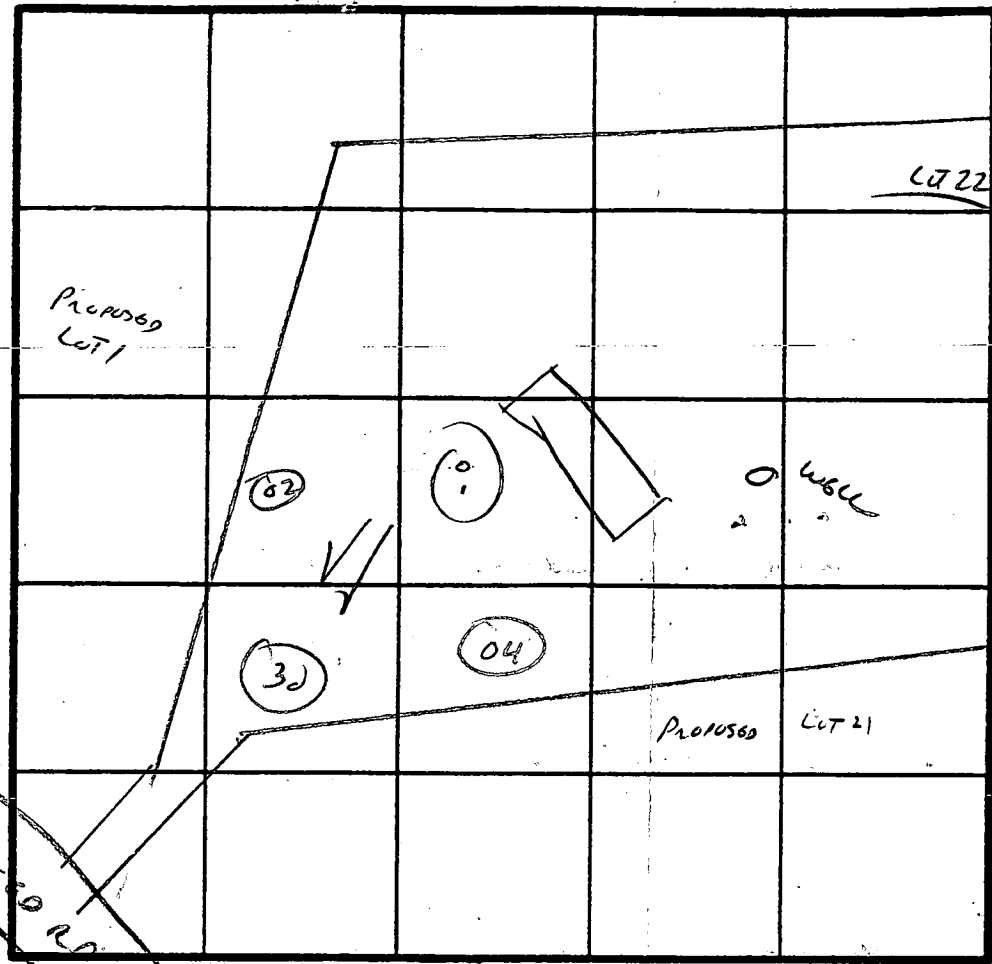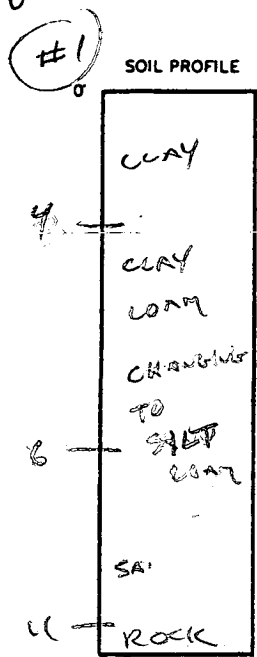


INDICATE NORTH - NAME ADJOINING ROADWAY AS BASE LINE.

DATE	TEST NO.	DEPTH	PRE-WET		TEST - 1" DROP		TIME
			START	STOP	START	STOP	
1/28/88	1	4 7	VIS	OK	11:36	11:40	CLAY LOAM / MICA LOAM
		11	SOME ROCK AT BOTTOM				
	2	2 1/2 7	11:39	11:41	11:41	11:43	2 MIN
			11:38	11:40	11:40	11:42	
		11					
	3	11	11:56				CLAY, AT HEAD OF SCALE
	4	4 7	11:41	11:44	11:44	11:49	5 MIN
		11					

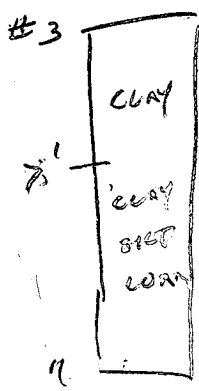

REMARKS: ~~TOPO MISLEADING FIELD RUN REQUIRED~~ ~~EDMUND~~ ~~11:51~~ ~~11:56~~ ~~11:58~~
 LOCATION AS PER PLAT
 TYPE OF SOIL: CLAY TO 4 OR 6', LOAM, SOME ROCK AT 11'
 TESTED BY: C. W. [Signature] ALSO PRESENT: R. [Signature]
 MWS WELL TO LEFT

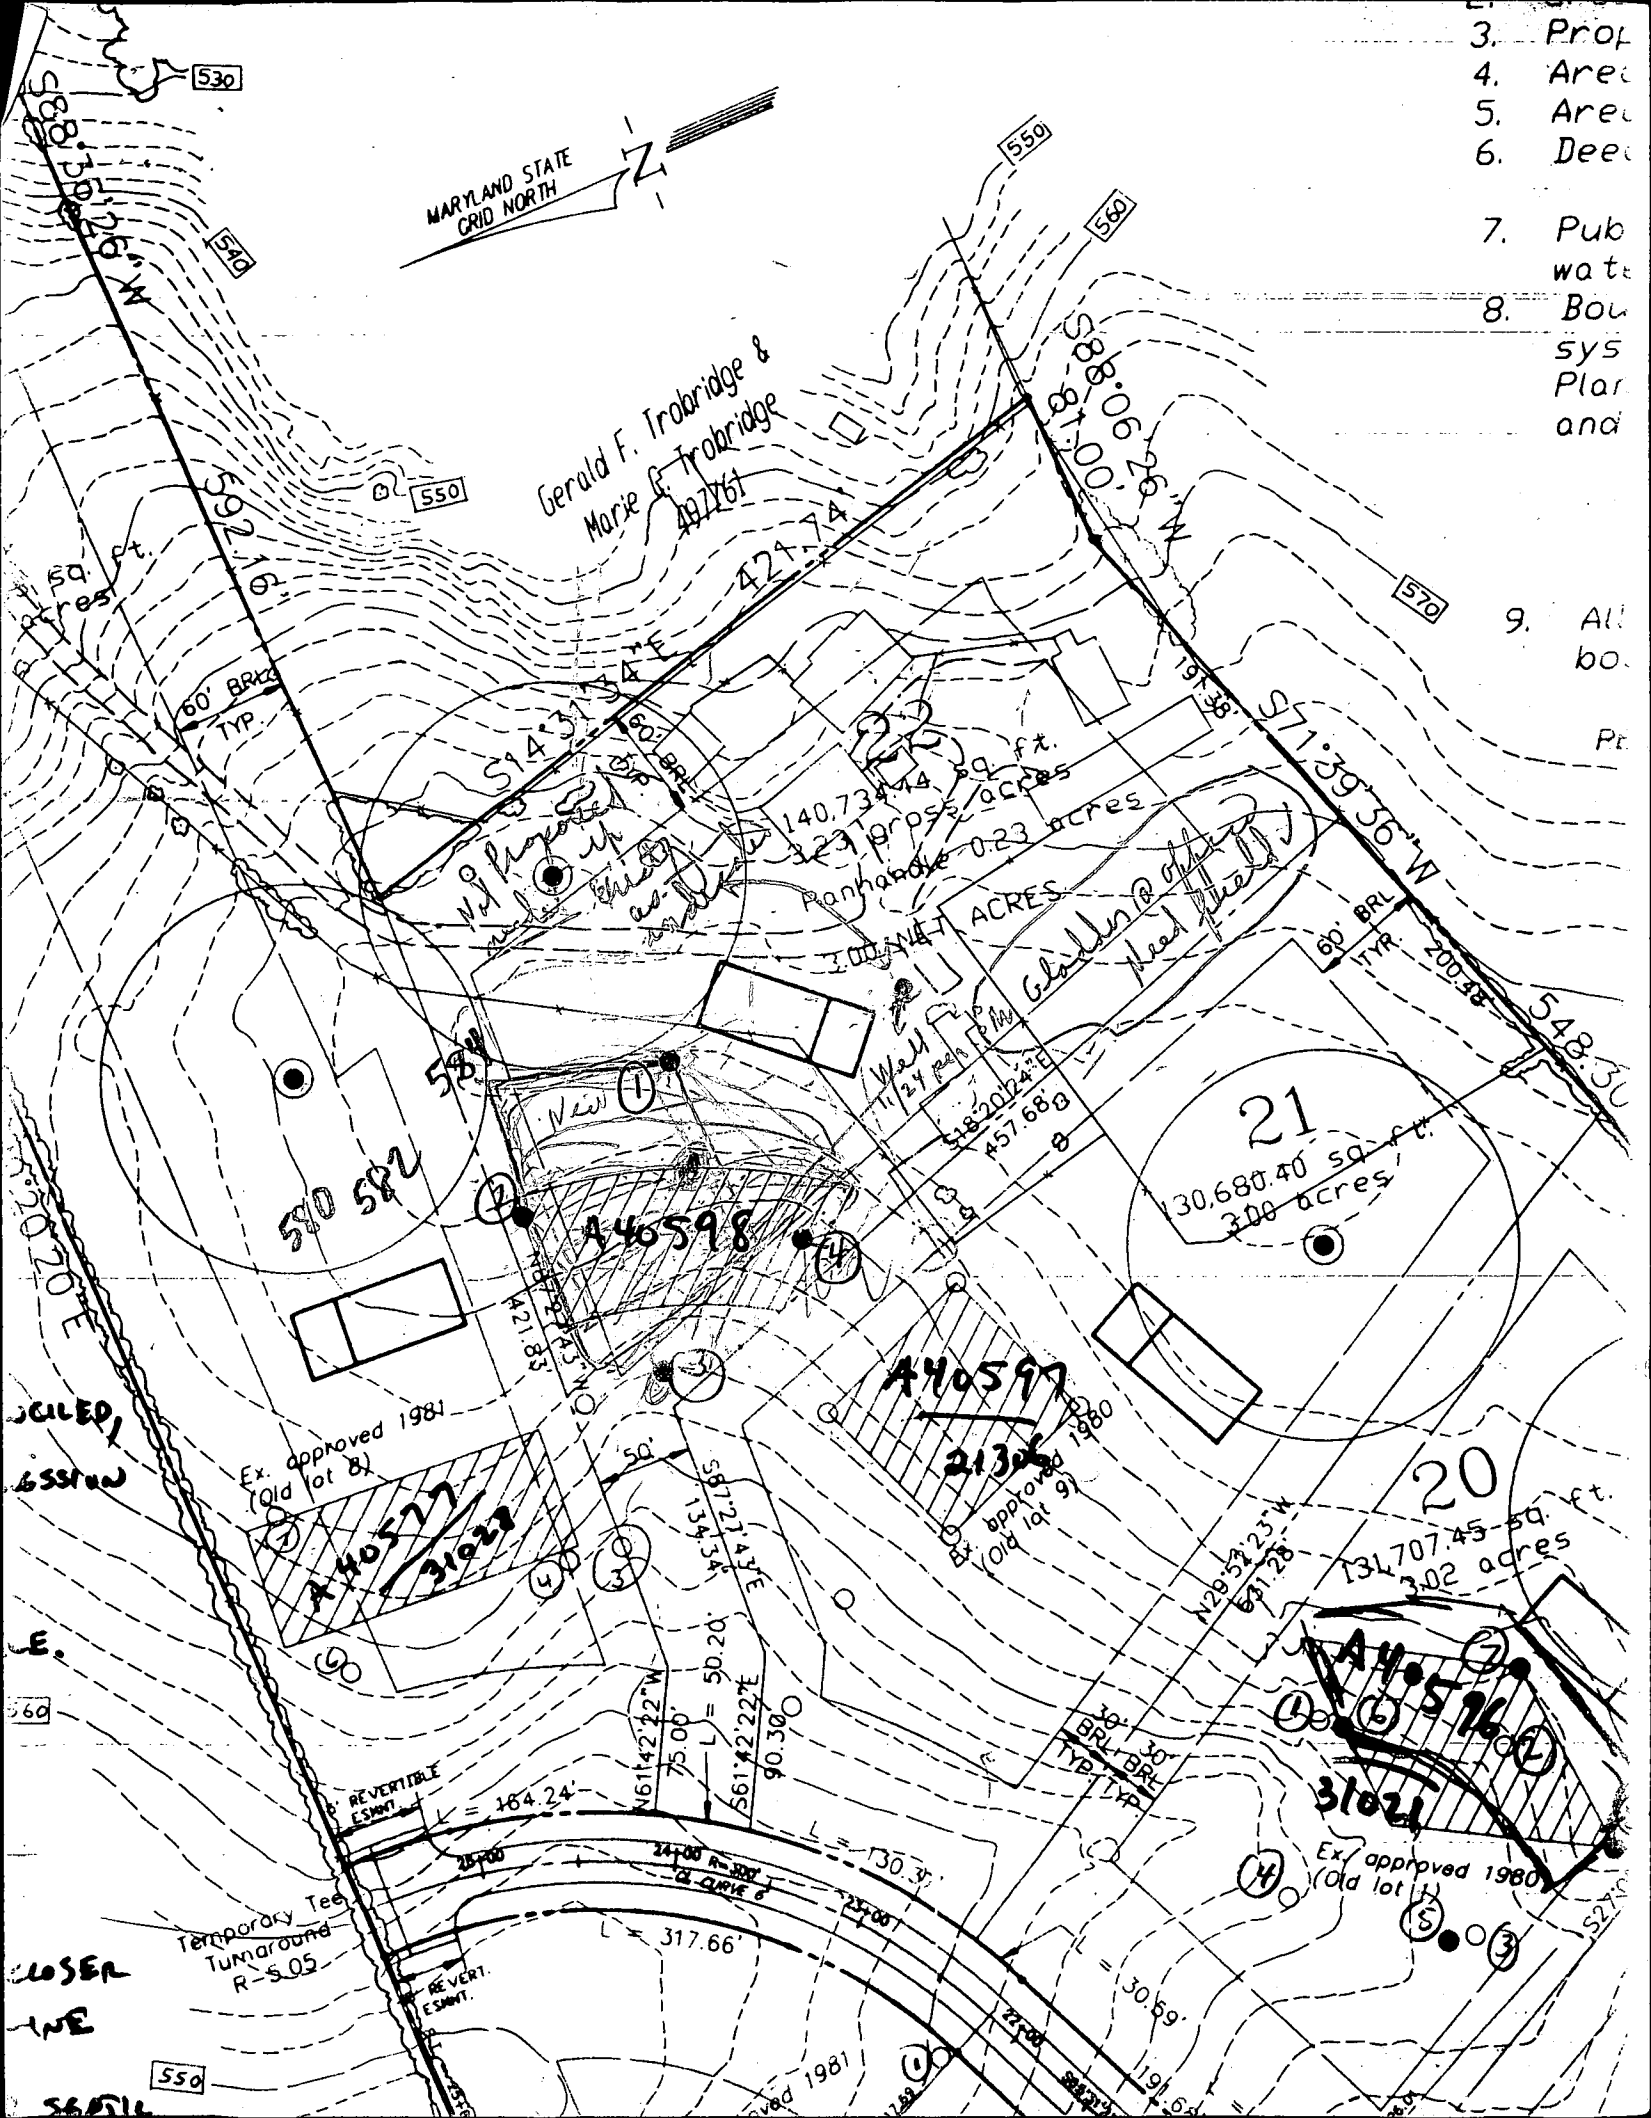

3. Prop
4. Area
5. Area
6. Deed
7. Pub
- water
8. Bou
- sys
- Plan
- and
9. All
- bo
- Pr