

7/16/84 a.m. please
approving 7/16/84 C. Williams 57

PERMIT

SEWAGE DISPOSAL SYSTEM

MARYLAND STATE DEPARTMENT OF HEALTH

HOWARD COUNTY

BUREAU OF ENVIRONMENTAL HEALTH

992-2330

65-30000
INDEX

ELLICOTT CITY

DISTRICT 5th.

DATE 6/6/84

Hobbs Bros., Inc.

IS PERMITTED TO INSTALL ☒ ALTER ☐

ADDRESS 13709 Nichols Drive, Clarksville, MD 21029

PHONE 854-3259

SUBDIVISION CHERRY BONE
GEORGE J SIMPSON

11965
ROAD Simpson Road

LOT ONE

PROPERTY OWNER

George Simpson

John McCoy

11965 Simpson Road

ADDRESS

IF GARBAGE GRINDER IS USED INCREASE SEPTIC TANK CAPACITY BY 50% AND ABSORPTION AREA BY 22%.

GARBAGE GRINDER? YES ☐ NO ☒

BLDG. PERMIT SIGNED

AND RETURNED 6-5-92

SEPTIC TANK CAPACITY 1250 GALLONS

NUMBER OF BEDROOMS 4

Serial # 304106042
2-Story Addition with Bedin

REPAIR - TRENCHES - 158 sq. ft. per bedroom. Trench to be 2 feet wide, Inlet 3 feet below original grade. Bottom maximum depth 9 feet below original grade. Effective area begins at 3 feet below original grade, with 6 feet of stone below distribution pipe.

LOCATION: Run trench(s) along level ground roughly parallel to and 100 feet from Simpson Ro.

NOTE: No trench to exceed 100 feet in length. If more than one trench used, a distribution box is required. Trenches to be installed on level ground. Call for inspection of trench before and after stone is installed. Provide 6"-8" diameter cleanout and cap to grade or above on septic tank and drywell.

No MR. HOBBS, SAID SOMEONE IN THE

MR. SKINNER & HAD IT CHANGED TO A DRY WELL ^{between} 6/6/84

& 7/12/84. CHECKED PERC DOES NOT MATTER ON THIS

LOT WHETHER IT IS A DRY WELL OR DITCH

BILL SWAN SUPPOSED TO HAVE REVISED PERMIT 2.

PLANS APPROVED BY Frank Skinner, C. Williams

DATE 6/6/84

COVER NO WORK UNTIL INSPECTED AND APPROVED.

7/13/84 CW & RH DECIDED DW OR SKINNER LABSE

NEITHER THE HOWARD COUNTY COUNCIL NOR THE HEALTH DEPARTMENT IS RESPONSIBLE FOR THE SUCCESSFUL OPERATION OF ANY SYSTEM.

NOTE: IF TRENCH IS USED CALL FOR INSPECTION BEFORE AND AFTER PLACING GRAVEL IN TRENCH.

NOTE: NO DRY WELL SHALL EXCEED 15 FOOT IN DIAMETER. NO ABSORPTION TRENCH TO EXCEED 100 FEET IN LENGTH.

NOTE: ALL PIPE FROM HOUSE TO SEPTIC TANK MUST BE CAST IRON OR SCHEDULE 40 PVC OR ABS.

PERMIT VOID AFTER THREE YEARS.

NOTE: INSTALL STAND PIPE ON SEPTIC TANK AND DRY WELL. STAND PIPES MUST BE 6 INCHES IN DIAMETER. CAST IRON, CONCRETE OR TERRA COTTA OR PVC OR ABS ACCEPTED. IF TOP OF SEPTIC TANK IS DEEPER THAN 3 FEET MANHOLE TO GRADE REQUIRED

BLDG. PERMIT SIGNED

AND RETURNED 9/2/84

Serial # 60982

Interior elevation

*INSTALLER IS RESPONSIBLE FOR OBTAINING FINAL APROVAL ON THIS PERMIT

*CALL 992-2330 FOR INSPECTION OF SEPTIC SYSTEMS.

EH - 2-1082

APPLICATION

SEWAGE DISPOSAL TESTING

STATE OF MARYLAND - DEPARTMENT OF HEALTH AND MENTAL HYGIENE

HOWARD COUNTY HEALTH DEPARTMENT
ENVIRONMENTAL HEALTH SERVICES

P. O. BOX 476 ELLICOTT CITY, MARYLAND 21043
TELEPHONE: 992-2330

A 33431

P _____

DISTRICT 5th.

DATE December 28, 19

TO: THE COUNTY HEALTH OFFICER
ELLICOTT CITY, MARYLAND

I, HEREBY, APPLY FOR THE NECESSARY TEST IN ORDER TO CONSTRUCT (OR RECONSTRUCT) A SEWAGE DISPOSAL SYSTEM.

PROPERTY OWNER Cherry Brae Hotthouse

ADDRESS 11961 Simpson Road
Clarksville, Maryland 21029 PHONE _____

PROPERTY LOCATION:

SUBDIVISION _____ LOT NO. "A" (2 EXST)

ROAD AND DESCRIPTION Farm House

SIZE OF LOT 3 acres TYPE BLDG. _____
(NUMBER OF BEDROOMS)

THE SYSTEM INSTALLED UNDER THIS APPLICATION IS ACCEPTABLE ONLY UNTIL PUBLIC FACILITIES BECOME AVAILABLE. I FULLY UNDERSTAND THE

FEE CONNECTED WITH THE FILING OF THIS PERC TEST APPLICATION IS NON-REFUNDABLE UNDER ANY CIRCUMSTANCES. I ALSO AGREE TO COMPLY

WITH ALL M.O.S.H.A. REQUIREMENTS IN TESTING THIS LOT. Wm Swann Agent 854 2608
(SIGNATURE OF APPLICANT)

APPROVED BY [Signature] FOR _____ DATE _____

REJECTED BY _____ FOR _____ DATE _____

HOLD PENDING FURTHER TESTS _____ DATE _____


REASONS FOR REJECTION OR HOLDING HOLD FOR FINAL SUBDIVISION PLAT 1-6-83 C. Williams

3/16/84 T.C. & Robert McCoy re Straight pipe & repair system specs 5/5



THIS IS NOT A PERMIT

GH
OLE #3

SOIL PROFILE

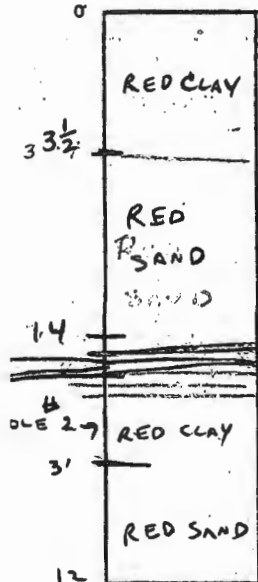

W
OLE #1

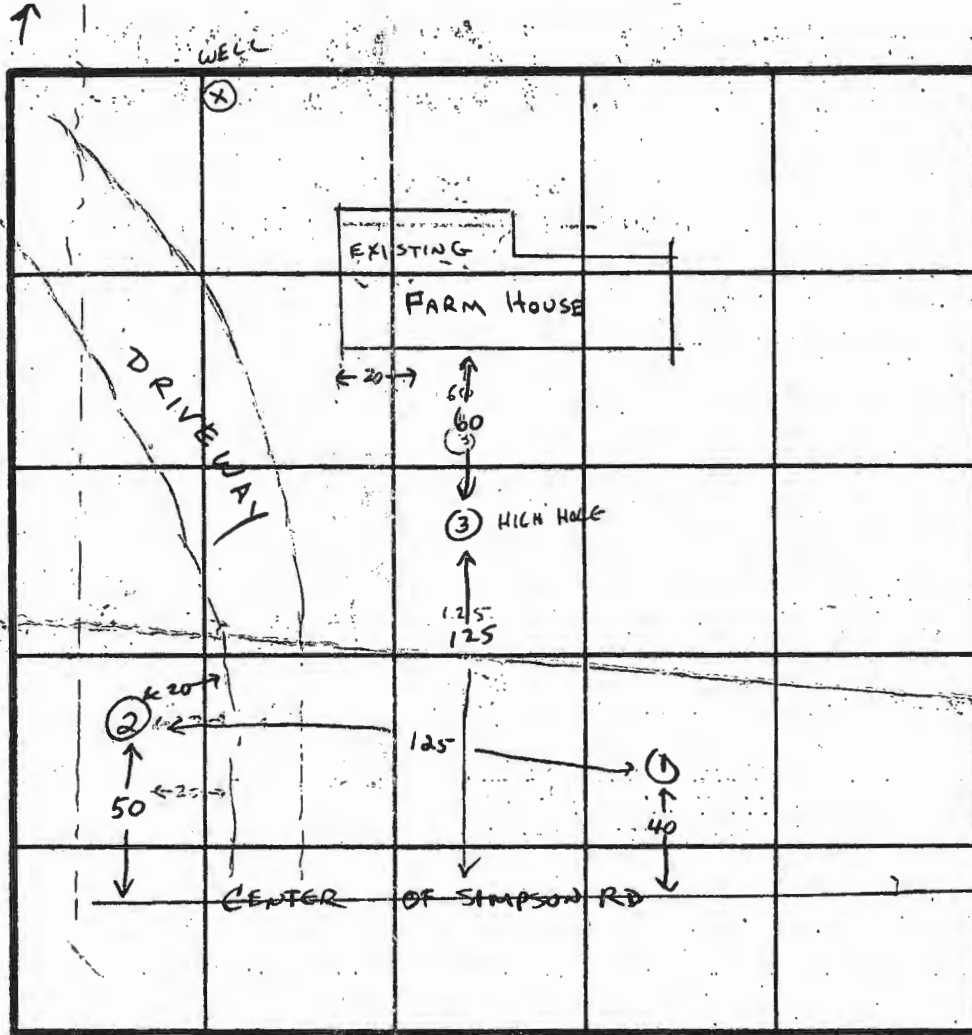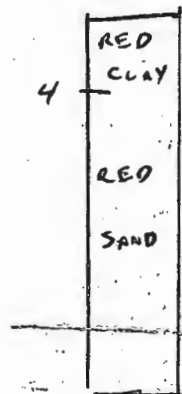

INDICATE NORTH - NAME ADJOINING ROADWAY AS BASE LINE.

DATE	TEST NO.	DEPTH	PRE-WET		TEST - 1" DROP		TIME
			START	STOP	START	STOP	
1-5-84	1	4 8	2:03	2:06	2:06	2:10	4 MIN
		12	SAND	4-12 FT	WATER AT 12 FT		
	2	4 12	2:09	2:14	2:14	2:19	5 MIN
		12	SAND	3-12 FT	DRY		
	3	4 8	2:16	2:18	2:18	2:20	2 MIN
		14	SAND	4-14'	DRY		

REMARKS

TYPE OF SOIL RED CLAY 3-4' (THEN RED SAND)

TESTED BY

C. Williams

ALSO PRESENT


BILL SWANN, OLIVETTE KETTERMAN

EH-12-1079

S 65° 52' 32" E
131.97'

SIMPSON ROAD

& Road 7
S 59° 02' 19" E 417'

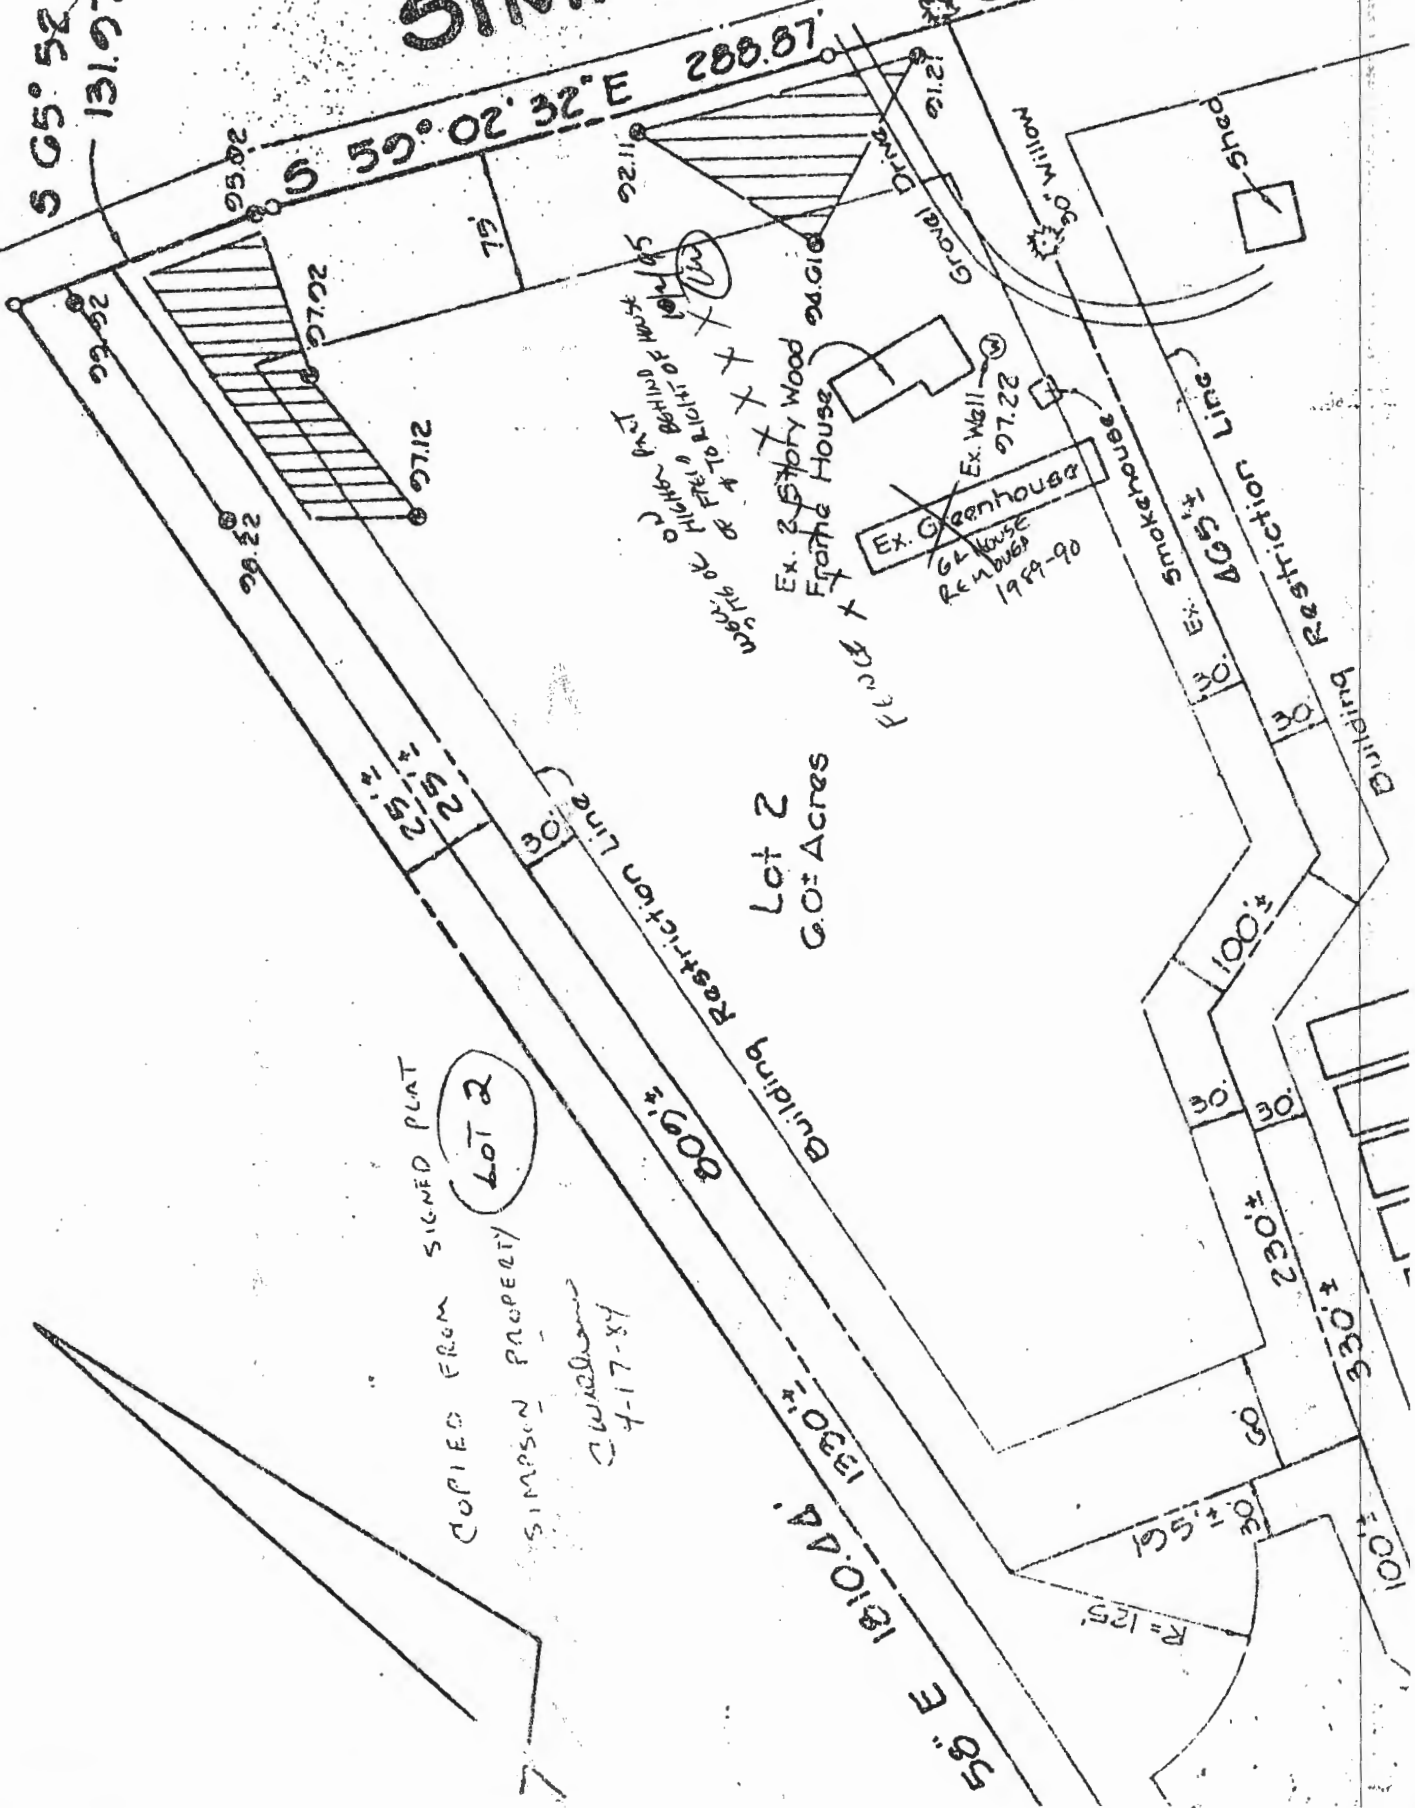

COPIED FROM SIGNED PLAT
Lot 2
SIMPSON PROPERTY
C. Williams
4-17-84