

check
8/29/61 approved 7/4

PERMIT

SEWAGE DISPOSAL SYSTEM

MARYLAND STATE DEPARTMENT OF HEALTH

HOWARD COUNTY

INDEXED

ELLICOTT CITY

DISTRICT 5

DATE 8-17-61

P 04147

A 03682

C. C. Cissell IS PERMITTED TO INSTALL ☒ ALTER

ADDRESS Simpsonville PHONE _____

A SEWAGE DISPOSAL SYSTEM LOCATED AT _____

SUBDIVISION Clarksville Ridge ROAD 6726 Surrey Lane LOT 44

PROPERTY OWNER B. J. Gilgus Karen Dibella - 21029

ADDRESS Clarksville 21029 Md.

SPECIFICATIONS

DRAIN FIELD _____ DEPTH _____ FEET, BOTTOM AREA _____ SQ. FT.

SEEPAGE PITS _____ ABSORBENT SIDE-WALL AREA _____ SQ. FT.

SEPTIC TANK CAPACITY 1000 GALLONS with the tip tank no
deeper than 3 ft. below grade.

FOR GARBAGE GRINDER, INCREASE DISPOSAL AREA 22% & TANK CAPACITY 50%.


OTHER Dry Well 300 sq. ft. side wall area below the inlet. Place the dry
well about 15 ft. to 50 ft. from the short (198 side- ft.) side line of the lot and
15 ft. to 50 ft. from the back lot line.

PLANS APPROVED BY Raymond Hodges DATE 5-9-61

FILL SEPTIC TANK AND DISTRIBUTION BOX WITH WATER BEFORE CALLING FOR AN INSPECTION. COVER NO WORK
UNTIL INSPECTED AND APPROVED.

NEITHER THE HOWARD COUNTY COMMISSIONERS NOR THE HEALTH DEPARTMENT IS RESPONSIBLE FOR THE
SUCCESSFUL OPERATION OF ANY SYSTEM.

A 03682

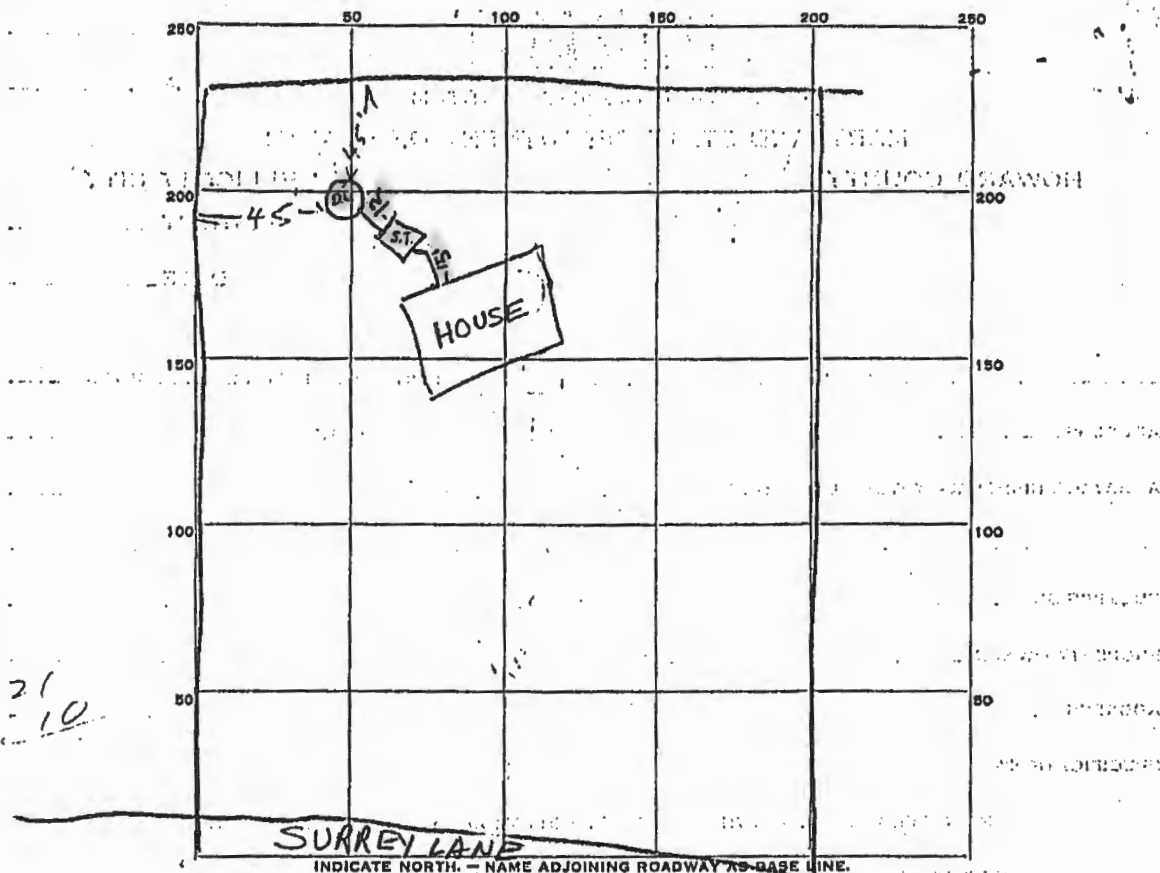

PERMIT CARD OK

SEPTIC TANK, LEVEL 1000 concrete
Top 1 ft below grade
 DISTRIBUTION BOX, LEVEL _____

CLEANOUTS OK

TILE FIELD, DEPTH _____ FT. TRENCH WIDTH _____ FT.

GRAVEL DEPTH _____ IN. TOTAL LENGTH _____ FT.

NUMBER OF TRENCHES _____ TOTAL BOTTOM AREA _____

SEEPAGE PITS, INSIDE DIAMETER 7 FT. DEPTH BELOW INLET 10 FT.

ABSORBENT AREA 210 SQ. FT. not counting stone

REMARKS 10 ft diam. dist. all to dist. all = 310 counting stone
Dry well inlet 2 ft below inlet

DATE SYSTEM APPROVED 8/29/01

INSPECTOR Raymond Hodges