

Repair
4/16/70
9:30

100

APPLICATION

SEWAGE DISPOSAL TESTING

MARYLAND STATE DEPARTMENT OF HEALTH

HOWARD COUNTY

ELLICOTT CITY

Deep trench - 11 ft deep
with 5 ft gravel below pipe, 2 ft wide
and 50 ft long

DISTRICT 5

DATE 4/13/70

2 inspection

TO: THE COUNTY HEALTH OFFICER
ELLICOTT CITY, MARYLAND

I, HEREBY, APPLY FOR THE NECESSARY TESTS IN ORDER TO CONSTRUCT (OR RECONSTRUCT) A SEWAGE DISPOSAL SYSTEM.

PROPERTY OWNER

Richard Higgins

ADDRESS

44 Surrey Ave.

PHONE

286-2455

PROPERTY LOCATION:

SUBDIVISION

Clarksville Ridge

LOT NO.

ROAD AND DESCRIPTION

OCCUPANT

PHONE

PERSON TO CONSTRUCT SYSTEM

ADDRESS

PHONE

SIZE OF LOT

TYPE BLDG.

Existing house

NUMBER OF BEDROOMS

IF NOT SINGLE RESIDENCE DESCRIBE

SIGNATURE OF APPLICANT

Jack Fyock

APPROVED BY

James T. Wright

FOR

Deep trench

(KIND OF SYSTEM)

DATE

4/16/70

REJECTED BY

FOR

(KIND OF SYSTEM)

DATE


HOLD PENDING FURTHER TESTS

DATE

REASONS FOR REJECTION OR HOLDING

THIS IS NOT A PERMIT

APR 20 8 16 AM '70
NEW YORK COUNTY
DEPT. OF SOCIAL
SERVICES
FACILITY

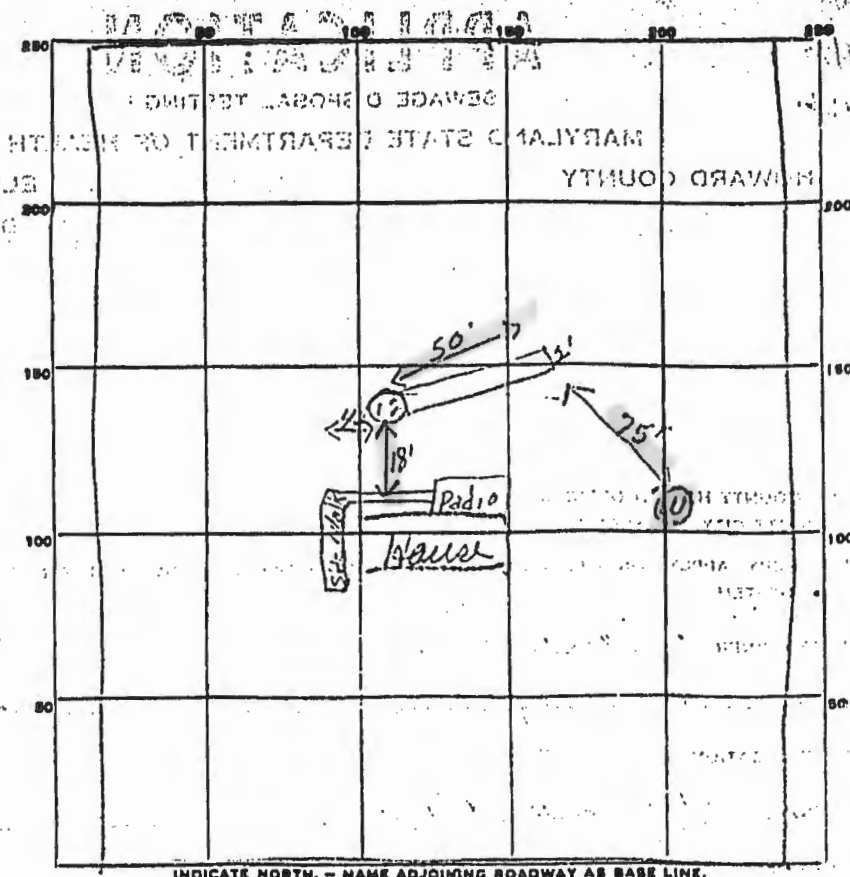

INDICATE NORTH. - NAME ADJOINING ROADWAY AS BASE LINE

Sure Lane.

[illegible]

SOIL AUGER FINDING.

TESTED BY

REMARKS.