


SEQUENCE NO. (DENY USE ONLY)		STATE OF TENNESSEE WELL COMPLETION REPORT FILL IN THIS FORM COMPLETELY PLEASE PRINT OR TYPE		45 DAYS AFTER WELL IS COMPLETED.	
2492				COUNTY NUMBER 41242	
DATE Received		DATE WELL COMPLETED		Depth of Well	
01/13		06/20/99		22 30 26 (TO NEAREST FOOT)	
OWNER CHENDWITH		last name McKendree first name		TOWN Cooksville	
STREET OR RFD		SUBDIVISION STERN PROP.		SECTION LOT 4	
WELL LOG Not required for driven wells		GROUTING RECORD		PUMPING TEST	
STATE THE KIND OF FORMATIONS PENETRATED, THEIR COLOR, DEPTH, THICKNESS AND IF WATER BEARING		WELL HAS BEEN GROUTED (Circle Appropriate Box) TYPE OF GROUTING MATERIAL CEMENT CM BENTONITE CLAY BC NO. OF BAGS 15 NO. OF POUNDS 1500 GALLONS OF WATER 75 DEPTH OF GROUT SEAL (to nearest foot) from 0 ft. to 34 ft. Casing types insert appropriate code below MAIN CASING TYPE ST CO PL OT Nominal diameter top (main) casing (nearest inch) 6 Total depth of main casing (nearest foot) 70 OTHER CASING (if used) diameter inch depth (feet) from to SCREEN RECORD screen type or open hole insert appropriate code below ST BR HO PL OT STEEL BRASS BRONZE PLASTIC OPEN HOLE OTHER C2 DEPTH (nearest ft.) 1 40 2 70 3 80 EACH SCREEN 1 40 2 70 3 80 CIRCLE APPROPRIATE LETTER A A WELL WAS ABANDONED AND SEALED WHEN THIS WELL WAS COMPLETED E ELECTRIC LOG OBTAINED P TEST WELL CONVERTED TO PRODUCTION WELL I HEREBY CERTIFY THAT THIS WELL HAS BEEN CONSTRUCTED IN ACCORDANCE WITH COMAR 10.17.13 "WELL CONSTRUCTION" AND IN CONFORMANCE WITH ALL CONDITIONS STATED IN THE ABOVE CAPTIONED PERMIT, AND THAT THE INFORMATION PRESENTED HEREIN IS ACCURATE AND COMPLETE TO THE BEST OF MY KNOWLEDGE. DRILLERS IDENT. NO. 46 DRILLERS SIGNATURE SITE SUPERVISOR (sign. of driller or journeyman responsible for sitework if different from permittee)		PUMPING TEST HOURS PUMPED (nearest hour) 3 PUMPING RATE (gal. per min. to nearest gal.) 9 METHOD USED TO MEASURE PUMPING RATE Bucket WATER LEVEL (distance from land surface) BEFORE PUMPING 16 WHEN PUMPING 55 TYPE OF PUMP USED (for test) A air P piston T turbine C centrifugal R rotary O other (describe below) J jet S submersible PUMP INSTALLED DRILLER WILL INSTALL PUMP YES NO IF DRILLER INSTALLS PUMP, THIS SECTION MUST BE COMPLETED FOR ALL WELLS EXCEPT HOME USE TYPE OF PUMP INSTALLED PLACE (A,C,J,P,R,S,T,O) IN BOX - SEE ABOVE: CAPACITY: GALLONS PER MINUTE (to nearest gallon) 31 35 PUMP HORSE POWER 37 41 PUMP COLUMN LENGTH (nearest ft.) 43 47 CASING HEIGHT (circle appropriate box and enter casing height) + above - below LAND SURFACE 50 (nearest foot) LOCATION OF WELL ON LOT SHOW PERMANENT STRUCTURE SUCH AS BUILDING, SEPTIC TANKS, AND/OR LANDMARKS AND INDICATE NOT LESS THAN TWO DISTANCES (MEASUREMENTS TO WELL) McKendree Rd. 65' 200' 200'	

B 1 1148		SEQUENCE NO. (DP USE ONLY)		STATE OF MARYLAND PERMIT TO DRILL WELL please print or type		STATE PERMIT NUMBER HO-88-0656 <small>fill in this form completely</small>	
Date Received (APA) 09-889 CHENOWETH JIM 15 Last Name Owner First Name 328 KINGSTON CIRCLE 36 Street or RFD 55 SYKESVILLE MD 21784 57 Town 70 State 72 Zip 76				B 3 LOCATION OF WELL R-44027 HOWARD 8 COUNTY 21 THE STERN PROPERTY 23 SUBDIVISION 42 SECTION LOT 4 44 46 48 50 COOKSVILLE 52 NEAREST TOWN 71 MILES FROM TOWN (enter 0 if in town) 1 MI 73 76 77 78			
DRILLER INFORMATION George F. Easterday Driller's Name L. Franklin Easterday, Inc. Firm Name 9205 Brown Church Rd., MT. Airy, Md. 21771 Address George F. Easterday Signature Date 4/14/89 77 License No. 80				B 4 DIRECTION OF WELL FROM TOWN (CIRCLE BOX) ON WHICH SIDE OF ROAD (CIRCLE APPROPRIATE BOX) NEAR WHAT ROAD MCKENDREE RD 11 30 DISTANCE FROM ROAD 25 34 37 ENTER FT or MI FT 38 39			
B 2 WELL INFORMATION APPROX. PUMPING RATE (GAL. PER MIN.) 5 8 12 AVERAGE DAILY QUANTITY NEEDED (GAL. PER DAY) 500 14 20				USE FOR WATER (CIRCLE APPROPRIATE BOX) <input checked="" type="checkbox"/> D HOME (SINGLE OR DOUBLE HOUSEHOLD UNIT ONLY) <input type="checkbox"/> F FARMING (LIVESTOCK WATERING & AGRICULTURAL IRRIGATION) <input type="checkbox"/> I INDUSTRIAL, COMMERCIAL, STATE AND FEDERAL GOV. OTHER (REQUIRES APPROPRIATION PERMIT) <input type="checkbox"/> P PUBLIC OR PRIVATE WATER COMPANY (REQUIRES APPROPRIATION PERMIT AND STATE HEALTH DEPARTMENT APPROVAL) <input type="checkbox"/> T TEST, OBSERVATION, MONITORING (MAY REQUIRE APPROPRIATION PERMIT)			
APPROXIMATE DEPTH OF WELL 200 FEET 24 28				NOT TO BE FILLED IN BY DRILLER HEALTH DEPARTMENT APPROVAL Howard COUNTY NAME COUNTY NO. A41242 STATE SIGNATURE INSERT S <input type="checkbox"/> DATE ISSUED 053189 Mark E. Rifkin 4/30/89 43 48 CO SIGNATURE EXP. DATE NORTH GRID 538000 EAST GRID 0799000 50 55 57 63			
APPROXIMATE DIAMETER OF WELL 6 INCH NEAREST INCH				SHOW MAJOR FEATURES OF BOX & LOCATE WELL WITH AN X SOURCES OF DRILLING WATER 1. WELL 2. 3. WRITE THE BOX NUMBER FROM THE MAP HERE DRAW A SKETCH BELOW SHOWING LOCATION OF WELL IN RELATION TO NEARBY TOWNS AND ROADS AND GIVE DISTANCE FROM WELL TO NEAREST ROAD JUNCTION			
METHOD OF DRILLING (circle one) <input checked="" type="radio"/> BORED (or Augered) <input type="radio"/> JETTED Jetted & <input type="radio"/> DRIVEN <input checked="" type="radio"/> AIR-ROtary <input type="radio"/> AIR-PERcussion <input type="radio"/> ROTARY (Hydraulic Rotary) <input type="radio"/> CABLE <input type="radio"/> REVerse-ROtary <input type="radio"/> Drive-POINT other _____				REPLACEMENT OR DEEPEINED WELLS (CIRCLE APPROPRIATE BOX) <input checked="" type="radio"/> N THIS WELL WILL NOT REPLACE AN EXISTING WELL <input type="radio"/> Y THIS WELL WILL REPLACE A WELL THAT WILL BE ABANDONED AND SEALED <input checked="" type="radio"/> S THIS WELL WILL REPLACE A WELL THAT WILL BE USED AS A STANDBY <input type="radio"/> D THIS WELL WILL DEEPEIN AN EXISTING WELL PERMIT NUMBER OF WELL TO BE REPLACED OR DEEPEINED (IF AVAILABLE) 41 _____ 52			
Not to be filled in by driller (OEP USE ONLY) APPROP. PERMIT NUMBER _____ GAP _____ 54 63 FORCE MR WRITE INITIALS IN BOX PERMIT No. HO-88-0656 67 68 70 71 72 73 74 75 76 77 78 79				SPECIAL CONDITIONS			

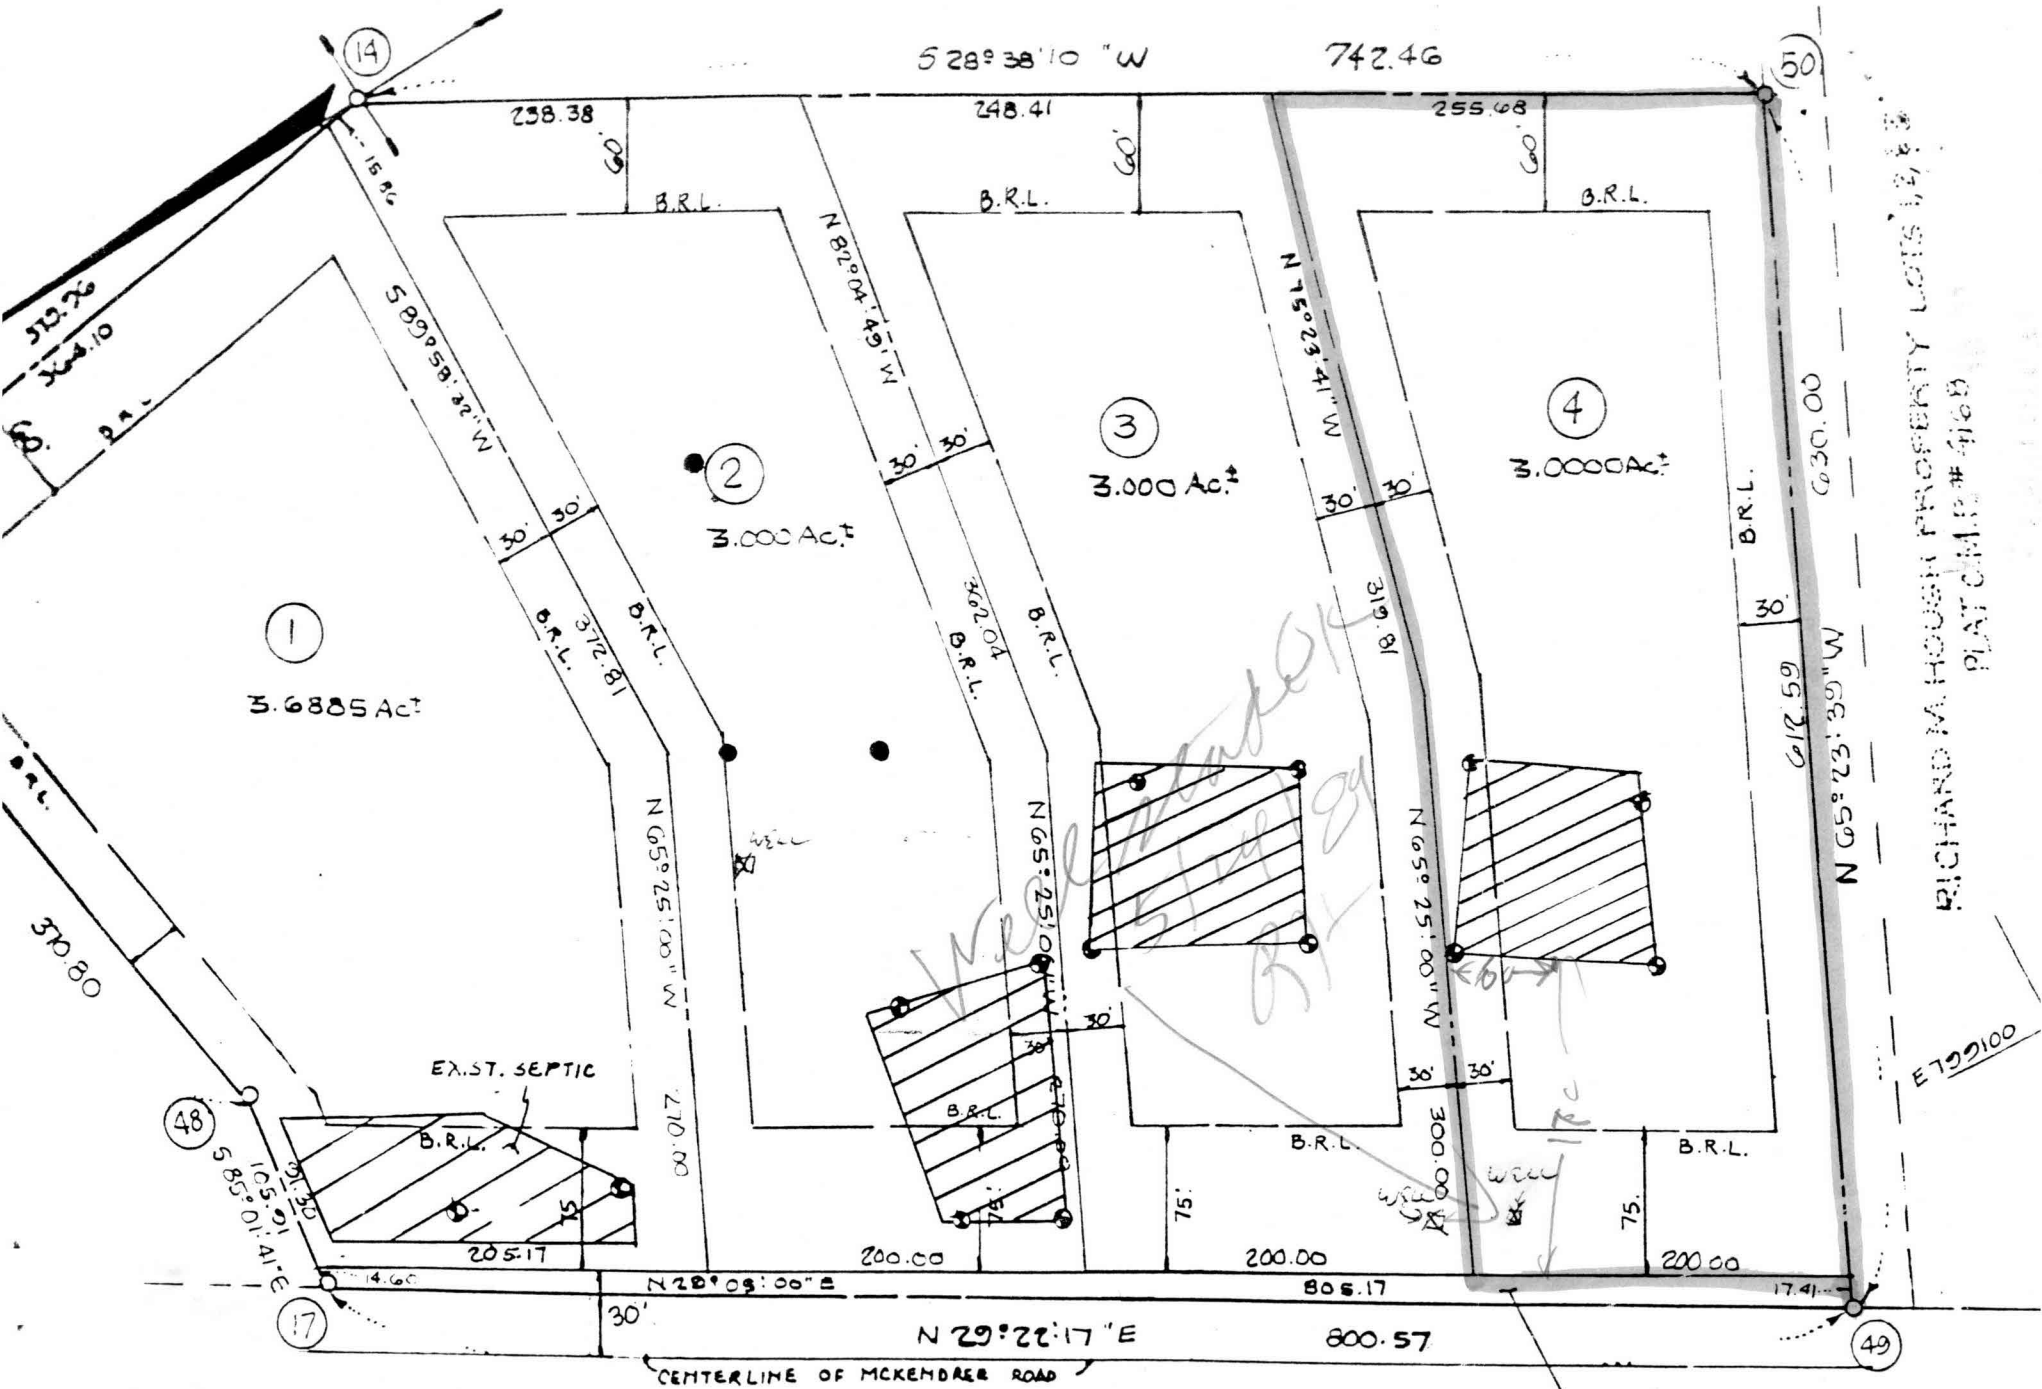

RICHARD M. HOUGH PROPERTY LOTS 1, 2, 3, 4
PLAT C.M.L. # 4160

McKENDREE ROAD

LAND DEDICATED TO HOWARD COUNTY, MARYL.