



Building Permit Application

Howard County Maryland
Department of Inspections, Licenses and Permits
3430 Court House Drive
Permits: 410-313-2455
www.howardcountymd.gov

Date Received: _____

Permit No.: _____

Building Address: <u>9334 Vollmerhausen Rd</u> City: <u>Savage</u> State: <u>MD</u> Zip Code: <u>20763</u> Suite/Apt. #: _____ SDP/WP/BA #: _____ Subdivision: <u>2001</u> Lot: _____ Tax Map: _____ Parcel: <u>0791</u> Existing Use: <u>Residential</u> Proposed Use: <u>Residential</u> Estimated Construction Cost: \$ <u>10,000</u> Description of Work: <u>Build new 12x20 pressure treated deck with P.T. railing, Steps to grade, concrete footings 30" below grade - 6x6 posts -</u> Occupant/Tenant Name: _____ Was tenant space previously occupied? ☐ Yes ☐ No Contact Name: _____ Address: _____ City: _____ State: _____ Zip Code: _____ Phone: _____ Fax: _____ Email: _____	Property Owner's Name: _____ Address: _____ City: _____ State: _____ Zip Code: _____ Phone: _____ Fax: _____ Email: _____ Applicant's Name & Mailing Address, (If other than stated herein) Applicant's Name: <u>Jennifer Madrid</u> Address: <u>21-B Randall St.</u> City: <u>Annapolis</u> State: <u>MD</u> Zip Code: <u>21403</u> Phone: <u>410-757-0971</u> Fax: _____ Email: <u>jmadrid@bonancontracting.com</u> Contractor Company: <u>Bonan Contracting</u> Contact Person: <u>Mark Marek</u> Address: <u>21-B Randall St.</u> City: <u>Annapolis</u> State: <u>MD</u> Zip Code: <u>21401</u> License No.: <u>101640</u> Phone: <u>410-757-0971</u> Fax: _____ Email: <u>mmarek@bonancontracting.com</u> Engineer/Architect Company: _____ Responsible Design Prof.: _____ Address: _____ City: _____ State: _____ Zip Code: _____ Phone: _____ Fax: _____ Email: _____
--	--

Commercial Building Characteristics	Residential Building Characteristics
Height: _____	☒ SF Dwelling ☐ SF Townhouse
No. of stories: _____	Depth _____ Width _____
Gross area, sq. ft./floor: _____	1 st floor: _____
	2 nd floor: _____
Area of construction (sq. ft.): _____	Basement: _____
	☐ Finished Basement
Use group: _____	☐ Unfinished Basement
	☐ Crawl Space
Construction type:	☐ Slab on Grade
☐ Reinforced Concrete	No. of Bedrooms: _____
☐ Structural Steel	Multi-family Dwelling
☐ Masonry	No. of efficiency units: _____
☐ Wood Frame	No. of 1 BR units: _____
☐ State Certified Modular	No. of 2 BR units: _____
	No. of 3 BR units: _____
	Other Structure: _____
	Dimensions: _____
Roadside Tree Project Permit	Footings: _____
☐ Yes ☒ No	Roof: _____
Roadside Tree Project Permit #	☐ State Certified Modular
	☐ Manufactured Home

Utilities	
Electric: ☐ Yes ☐ No	
Gas: ☐ Yes ☐ No	
Water Supply	
☐ Public	
☐ Private	
Sewage Disposal	
☐ Public	
☐ Private	
Heating System	
☐ Electric ☐ Oil	
☐ Natural Gas ☐ Propane Gas	
☐ Other:	
Sprinkler System:	
☐ Yes ☐ No	
Grading Permit Number:	
Building Shell Permit Number:	

THE UNDERSIGNED HEREBY CERTIFIES AND AGREES AS FOLLOWS: (1) THAT HE/SHE IS AUTHORIZED TO MAKE THIS APPLICATION; (2) THAT THE INFORMATION IS CORRECT; (3) THAT HE/SHE WILL COMPLY WITH ALL REGULATIONS OF HOWARD COUNTY WHICH ARE APPLICABLE THERETO; (4) THAT HE/SHE WILL PERFORM NO WORK ON THE ABOVE REFERENCED PROPERTY NOT SPECIFICALLY DESCRIBED IN THIS APPLICATION; (5) THAT HE/SHE GRANTS COUNTY OFFICIALS THE RIGHT TO ENTER ONTO THIS PROPERTY FOR THE PURPOSE OF INSPECTING THE WORK PERMITTED AND POSTING NOTICES.

Jennifer Madrid Jennifer Madrid
 Applicant's Signature Print Name
jmadrid@bonancontracting.com _____
 Email Address Date
Production Coordinator - Bonan Contracting _____
 Title/Company

Checks Payable to: DIRECTOR OF FINANCE OF HOWARD COUNTY

PLEASE WRITE NEATLY & LEGIBLY
FOR OFFICE USE ONLY

AGENCY	DATE	SIGNATURE OF APPROVAL
State Highways		
Building Officials		
PSZA (Zoning)		
PSZA (Engineering)		
Health		

Is Sediment Control approval required for issuance? ☐ Yes ☐ No
☐ CONTINGENCY CONSTRUCTION START

DPZ SETBACK INFORMATION	
Front:	
Rear:	
Side:	
Side St.:	
All minimum setbacks met?	☐ Yes ☐ No
Is Entrance Permit Required?	☐ Yes ☐ No
Historic District?	☐ Yes ☐ No
Lot Coverage for New Town Zone:	
SDP/Red-line approval date:	

Filing Fee	\$
Permit Fee	\$
Tech Fee	\$
Excise Tax	\$
PSFS	\$
Guaranty Fund	\$
Add'l per Fee	\$
Total Fees	\$
Sub- Total Paid	\$
Balance Due	\$
Check	#

Distribution of Copies: White: Building Officials

Green: PSZA,Zoning

Yellow: PSZA,Engineering

Pink: Health

Gold: SHA

THIS DOCUMENT IS CERTIFIED TO:





CASE #: HF-19-0907



kw
KELLERWILLIAMS

Kevin Guerrieri
231 Najoles Road
Millersville, MD 21108
301-455-8100

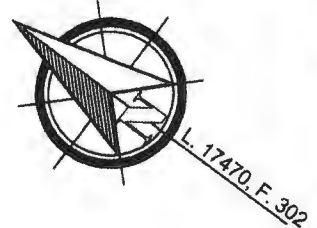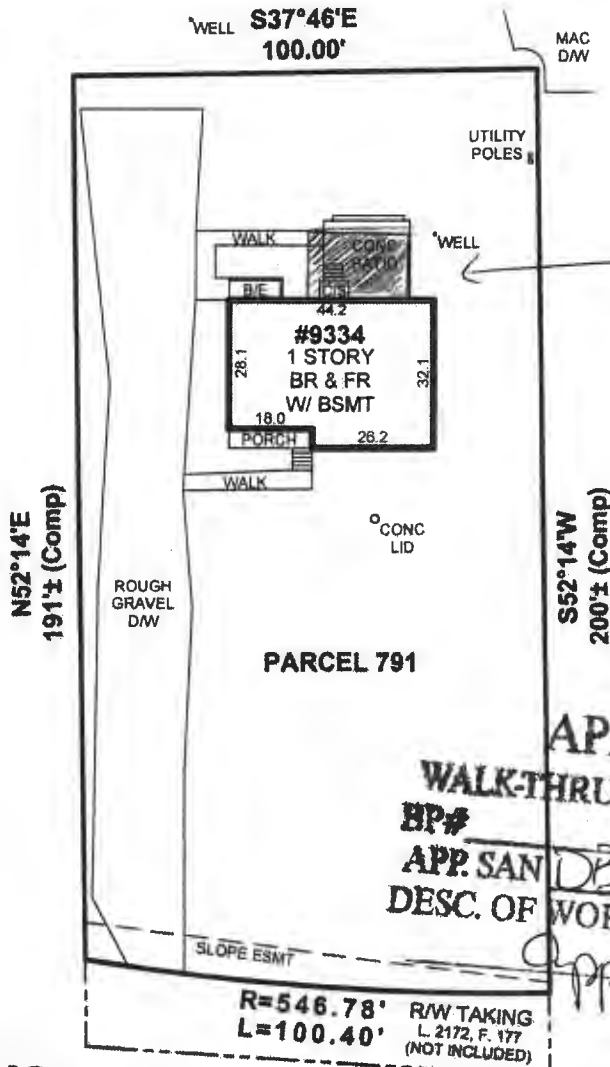

VOLLMERHAUSEN ROAD

NOTE:
ENCROACHMENTS
MAY EXIST

LOCATION DRAWING OF:

**#9334 VOLLMERHAUSEN ROAD
PARCEL 791 TAX MAP 47**

N/F PROPERTY OF
JEFFREY & RUTH WISE
LIBER 17470, FOLIO 302
HOWARD COUNTY, MARYLAND

SCALE: 1"=40' DATE: 07-02-2019
DRAWN BY: AP / CP FILE #: 195446-607

LEGEND:

- FENCE
- BASEMENT ENTRANCE
- BAY WINDOW
- BRICK
- BLDG. RESTRICTION LINE
- BASEMENT
- CONCRETE STOOP
- CONCRETE
- DRIVEWAY
- EXISTING
- FRAME
- MACADAM
- GATE
- OVERHANG
- PUBLIC UTILITY ESMT.
- PUBLIC IMPROVEMENT ESMT.

COLOR KEY:

- (RED) - RECORD INFORMATION
- (BLUE) - IMPROVEMENTS
- (GREEN) - ESMTS & RESTRICTION LINES

A Land Surveying Company



DULEY
and
Associates, Inc.

Serving D.C. and MD.

14604 Elm Street, Upper Marlboro, MD 20772

Phone: 301-888-1111

Email: orders@duley.biz

Fax: 301-888-1114

On the web: www.duley.biz

SURVEYOR'S CERTIFICATE

I HEREBY STATE THAT I WAS IN RESPONSIBLE CHARGE OVER THE PREPARATION OF THIS DRAWING AND THE SURVEY WORK REFLECTED HEREIN AND IT IS IN COMPLIANCE WITH THE REQUIREMENTS SET FORTH IN REGULATION 12 CHAPTER 09.13.09 OF THE CODE OF MARYLAND ANNOTATED REGULATIONS. THIS SURVEY IS NOT TO BE USED OR RELIED UPON FOR THE ESTABLISHMENT OF FENCES, BUILDING, OR OTHER IMPROVEMENTS, THIS PLAT DOES NOT PROVIDE FOR THE ACCURATE IDENTIFICATION OF PROPERTY BOUNDARY LINES, BUT SUCH IDENTIFICATION MAY NOT BE REQUIRED FOR THE TRANSFER OF TITLE OR SECURING FINANCING OR REFINANCING. THIS PLAT IS OF BENEFIT TO A CONSUMER ONLY INsofar AS IT IS REQUIRED BY A LENDER OR A TITLE INSURANCE COMPANY OR ITS AGENTS IN CONNECTION WITH THE CONTEMPLATED TRANSFER, FINANCING OR REFINANCING. THE LEVEL OF ACCURACY FOR THIS DRAWING IS 3". NO TITLE REPORT WAS FURNISHED TO NOR DONE BY THIS COMPANY. SAID PROPERTY SUBJECT TO ALL NOTES, RESTRICTIONS AND EASEMENTS OF RECORD. BUILDING RESTRICTION LINES AND EASEMENTS MAY NOT BE SHOWN ON THIS SURVEY. IMPROVEMENTS WHICH IN THE SURVEYOR'S OPINION APPEAR TO BE IN A STATE OF DISREPAIR OR MAY BE CONSIDERED "TEMPORARY" MAY NOT BE SHOWN. IF IT APPEARS ENCROACHMENTS MAY EXIST, A BOUNDARY SURVEY IS RECOMMENDED.



DULEY & ASSOC.

WILL GIVE YOU A 100%
FULL CREDIT TOWARDS
UPGRADING THIS
SURVEY TO A
"BOUNDARY/STAKE"
SURVEY FOR ONE
YEAR FROM THE DATE
OF THIS SURVEY.

(EXCLUDING D.C. & BALT. CITY)

PERMIT

SEWAGE DISPOSAL SYSTEM

DEPARTMENT OF HEALTH AND MENTAL HYGIENE

HOWARD COUNTY HEALTH DEPARTMENT

BUREAU OF ENVIRONMENTAL HEALTH

461-9933

P 48283

A REPAIR

DISTRICT _____

DATE 4/24/92

DATE SYSTEM APPROVED _____

INSPECTOR _____

Jack Fyock

IS PERMITTED TO INSTALL _____ ALTER X

ADDRESS _____ PHONE 988-9270

SUBDIVISION _____ Tax Map: 47
LOT Parcel: 791 ROAD 9334 Vollmerhausen

PROPERTY OWNER Wise
ADDRESS 792-2978 9334 Vollmerhausen - Off of Murry Hill Road

SEPTIC TANK CAPACITY _____ GALLONS

NUMBER OF BEDROOMS _____

_____ SQUARE FEET PER BEDROOM

LINEAR FEET OF TRENCH REQUIRED _____

REPAIR - CALL FOR INSPECTION WHEN GROUND IS OPENED SO SANITARIAN CAN RECOMMEND REPAIR.

1/28/91 UNSATISFACTORY SOIL LIMITED AREA
1/2 AC LOT WITH WATER WELL
RECOMMEND SEPTIC TANK RD

PLANS APPROVED BY C. Williams

DATE 1/28/91

COVER NO WORK UNTIL INSPECTED AND APPROVED

NEITHER THE HOWARD COUNTY COUNCIL NOR THE HEALTH DEPARTMENT IS RESPONSIBLE FOR THE SUCCESSFUL OPERATION OF ANY SYSTEM

NOTE: CLEANOUT REQUIRED EVERY 70 FEET OF SEWER LINE AND/OR AT 90° SWEEPS IN LINES FROM HOUSE TO DRAIN FIELDS, 90° ELBOWS NOT ACCEPTABLE.

NOTE: ALL PARTS OF SEPTIC SYSTEMS (I.E. TANK, DISTRIBUTION BOX TRENCHES) TO BE 100 FEET FROM WELL (UNLESS OTHERWISE SPECIFICALLY AUTHORIZED)

NOTE: IF DEEP TRENCH(ES) ARE USED CALL FOR INSPECTION BEFORE AND AFTER PLACING GRAVEL IN TRENCH(ES)

NOTE: NO DRY WELL SHALL EXCEED 15 FOOT IN DIAMETER NO ABSORPTION TRENCH TO EXCEED 100 FEET IN LENGTH

NOTE: ALL PIPE FROM HOUSE TO SEPTIC TANK MUST BE CAST IRON OR SCHEDULE 35/40 PVC OR ABS

PERMIT VOID AFTER TWO YEARS

NOTE: INSTALL STAND PIPE ON SEPTIC TANK AND DRY WELL STAND PIPES MUST BE 6 INCHES IN DIAMETER CAST IRON, CONCRETE OR TERRA COTTA OR PVA OR ABS ACCEPTED. IF TOP OF SEPTIC TANK IS DEEPER THAN 3 FEET, MANHOLE TO GRADE REQUIRED.

NOTE: DISTRIBUTION BOXES MUST HAVE BAFFLES

***INSTALLER IS RESPONSIBLE FOR OBTAINING FINAL APPROVAL ON THIS PERMIT**

***CALL 461-9933 FOR INSPECTION OF SEPTIC SYSTEM.**

Howard County Health Department

Bureau of Environmental Health, Ellicott City, Md. 461-9933

SEWAGE DISPOSAL PERMIT NO. A-Ripon P-48283

PERMITTEE

LOCATION

Jack Furr
Tay Map 47 Parcel: 791-9334/Williamhausen Rd
(Wise)

Do Not Cover Work Until Health Department Approval Appears On This Card

NOTICE

☐

STOP ALL CONSTRUCTION ON SEWAGE DISPOSAL SYSTEM AND CONTACT HEALTH DEPARTMENT BEFORE CONTINUING

Inspector

Date

☐

WORK IS SATISFACTORY, CONTINUE

Inspector

Date


☐

FINAL INSPECTION MADE,
COVER ALL WORK

Inspector

Date

POST THIS CARD WHERE IT CAN BE SEEN FROM ROAD

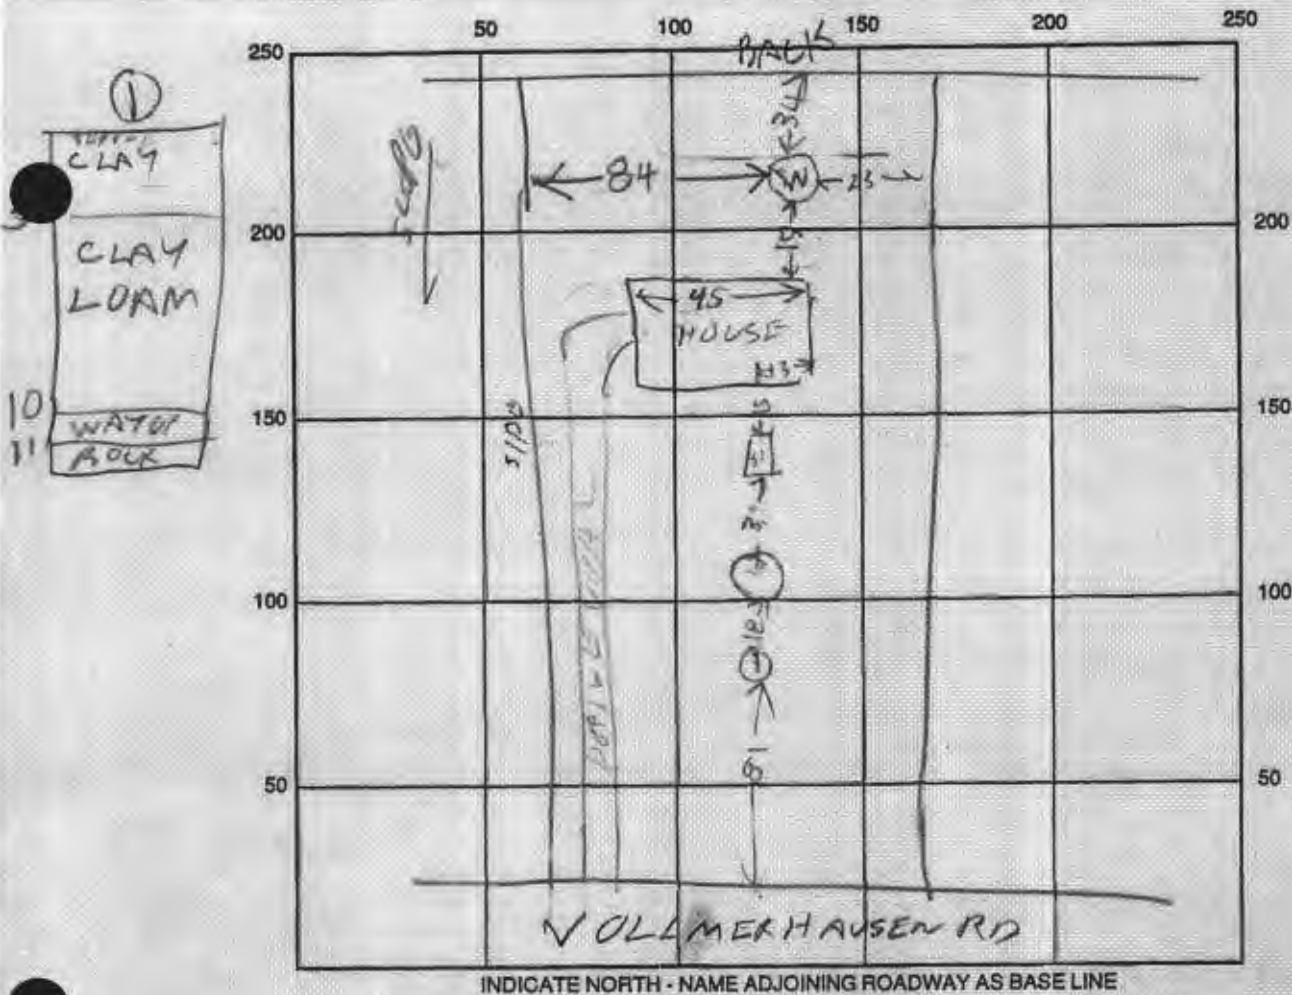

SEPTIC TANK LEVEL _____ CLEANOUTS _____

DISTRIBUTION BOX LEVEL _____

DRAIN FIELD/TITLE DEPTH _____ FT. TRENCH WIDTH _____ FT. INLET DEPTH _____ FT.

EFFECTIVE GRAVEL DEPTH _____ FT. TOTAL LENGTH _____ FT.

NUMBER OF TRENCHES _____ ONE SIDEWALL/BOTTOM AREA _____ SQ. FT.

DRYWALL INSIDE DIAMETER _____ FT. EFFECTIVE DEPTH BELOW INLET _____ FT.

ABSORBENT AREA _____ SQ. FT.

REMARKS: 1/28/91 - RY TESTED AT 3 FT FAIL & 5 FT FAILED
 PER ROCKY & RICK. CITY WATER NOT AVAILABLE & CITY
 SEWER NOT AVAILABLE NO PLACE TO DIG EXTRA HOLES
 BECAUSE SMALL YAC LOT WITH WELL TALKED TO MRS
 WISE RECOMMENDED SEALED TANK. ROCKY AGREED RH
 MRS WISE DISAPPOINTED RH 5/26/94 OWNER REPORTS PUMPING

DATE SYSTEM APPROVED _____ INSPECTOR _____

EVERY 6 WEEKS TO AVOID BACKUP. LAST YEAR SPOKE
 TO MS. BUTLER 313-6318 (HOUSING) NO NEWS SINCE THEN;
 HOUSE 25 YRS OLD HR 5/27/94 T/O TO HOUSING, LEFT MSG.
 (RE: CONNECTION) MR

PERMIT

SEWAGE DISPOSAL SYSTEM

DEPARTMENT OF HEALTH AND MENTAL HYGIENE

P 48213

A REPAIR

DISTRICT _____

DATE 4/24/92

HOWARD COUNTY HEALTH DEPARTMENT

BUREAU OF ENVIRONMENTAL HEALTH

461-9933

DATE SYSTEM APPROVED _____

INSPECTOR _____

Jack Fyock

IS PERMITTED TO INSTALL _____ ALTER X

ADDRESS _____ PHONE 988-9270

SUBDIVISION _____ Tax Map: 47
LOT Parcel: 791 ROAD 9334 Vollmerhausen

PROPERTY OWNER Wise

ADDRESS 9334 Vollmerhausen - Off of Murry Hill Road

SEPTIC TANK CAPACITY _____ GALLONS

NUMBER OF BEDROOMS _____

_____ SQUARE FEET PER BEDROOM

LINEAR FEET OF TRENCH REQUIRED _____

REPAIR - CALL FOR INSPECTION WHEN GROUND IS OPENED SO SANITARIAN CAN RECOMMEND REPAIR.

1/20/91 - UNSATISFACTORY SOIL LIMITED AREA
1/4 AC LOT WITH WATER WELL
RECOMMEND SEALED TANK R/H

PLANS APPROVED BY C. Williams DATE 1/28/91

COVER NO WORK UNTIL INSPECTED AND APPROVED

NEITHER THE HOWARD COUNTY COUNCIL NOR THE HEALTH DEPARTMENT IS RESPONSIBLE FOR THE SUCCESSFUL OPERATION OF ANY SYSTEM

NOTE: CLEANOUT REQUIRED EVERY 70 FEET OF SEWER LINE AND/OR AT 90° SWEEPS IN LINES FROM HOUSE TO DRAIN FIELDS, 90° ELBOWS NOT ACCEPTABLE.

NOTE: ALL PARTS OF SEPTIC SYSTEMS (I.E. TANK, DISTRIBUTION BOX TRENCHES) TO BE 100 FEET FROM WELL (UNLESS OTHERWISE SPECIFICALLY AUTHORIZED)

NOTE: IF DEEP TRENCH(ES) ARE USED CALL FOR INSPECTION BEFORE AND AFTER PLACING GRAVEL IN TRENCH(ES)

NOTE: NO DRY WELL SHALL EXCEED 15 FOOT IN DIAMETER NO ABSORPTION TRENCH TO EXCEED 100 FEET IN LENGTH

NOTE: ALL PIPE FROM HOUSE TO SEPTIC TANK MUST BE CAST IRON OR SCHEDULE 35/40 PVC OR ABS

PERMIT VOID AFTER TWO YEARS

NOTE: INSTALL STAND PIPE ON SEPTIC TANK AND DRY WELL STAND PIPES MUST BE 6 INCHES IN DIAMETER CAST IRON, CONCRETE OR TERRA COTTA OR PVA OR ABS ACCEPTED. IF TOP OF SEPTIC TANK IS DEEPER THAN 3 FEET, MANHOLE TO GRADE REQUIRED.

NOTE: DISTRIBUTION BOXES MUST HAVE BAFFLES

***INSTALLER IS RESPONSIBLE FOR OBTAINING FINAL APPROVAL ON THIS PERMIT**

***CALL 461-9933 FOR INSPECTION OF SEPTIC SYSTEM.**



INDICATE NORTH - NAME ADJOINING ROADWAY AS BASE LINE

SEPTIC TANK LEVEL _____ CLEANOUTS _____

DISTRIBUTION BOX LEVEL _____

DRAIN FIELD/TITLE DEPTH _____ FT. TRENCH WIDTH _____ FT. INLET DEPTH _____ FT.

EFFECTIVE GRAVEL DEPTH _____ FT. TOTAL LENGTH _____ FT.

NUMBER OF TRENCHES _____ ONE SIDEWALL/BOTTOM AREA _____ SQ. FT.

DRYWALL INSIDE DIAMETER _____ FT. EFFECTIVE DEPTH BELOW INLET _____ FT.

ABSORBENT AREA _____ SQ. FT.

REMARKS: _____

DATE SYSTEM APPROVED _____ INSPECTOR _____